



N.I.C.
DRAIN DETAIL

y all utility locations
construction.

DESCRIPTION

- H Addition, Wichita, Kansas

APPROVED AS NOTED
BY CITY ENGINEER OF WICHITA



Sanitary Sewers _____
Storm Sewers VRH 10/17/99
Driveway Approaches _____
Water Mains _____
Paving _____

NOTE TO CONTRACTORS

inspection and testing for this project is to be provided by a Licensed Consulting Engineering Firm under contract with the Owner/Developer. Said inspection to be in accordance with the City of Wichita standard construction engineering practices and certified by a Licensed Professional Engineer. No work shall be performed in dedicated easements or public right-of-way by the Contractor without such inspection nor shall any work be commenced without written authorization by the City Engineer. All Construction and Materials shall comply with the City of Wichita Specifications and Standards (on file and available in the City Engineer's Office).

City of Wichita Private Project

No. 506 FPS (607861)

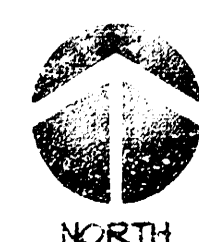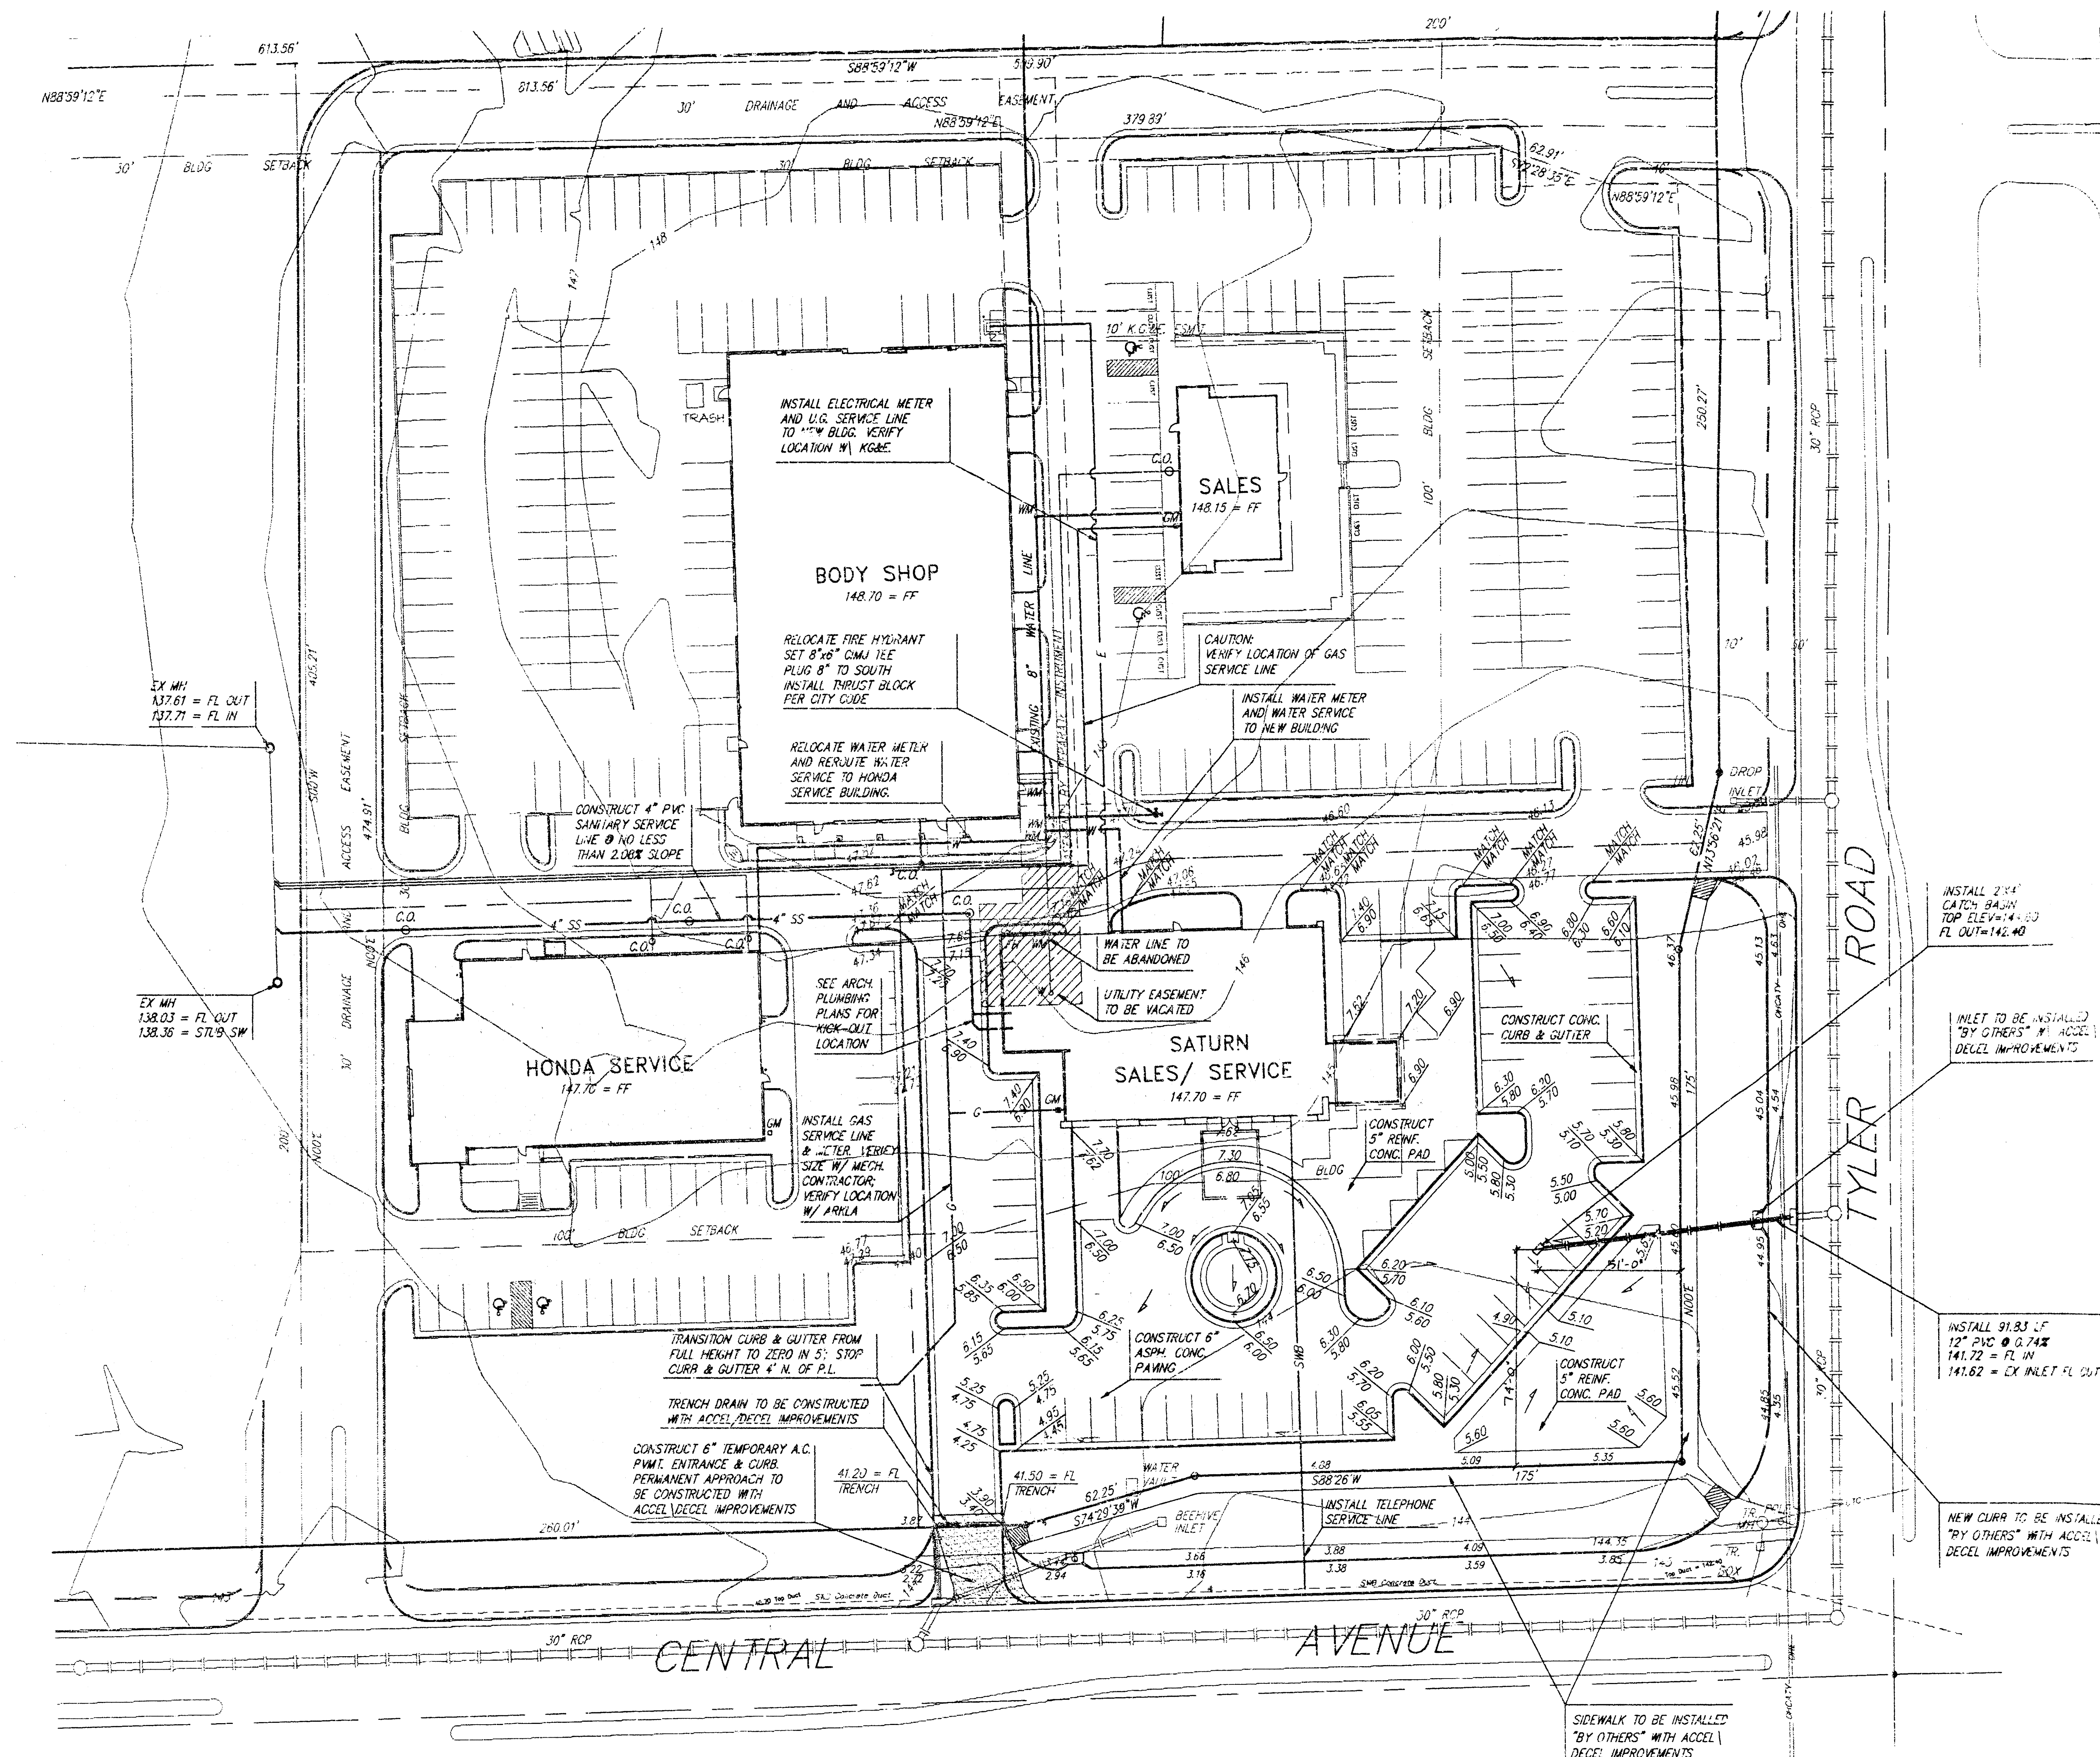


A

SITE GRADING & UTILITY PLAN

$$\text{SCA}^{\text{H}}_{\text{H}} |^{\text{H}} = 30^{\circ} - 0$$


BAUGHMAN COMPANY P. A.
ENGINEERING & SURVEYING
316/262-7271 • 315 ELLIS • WICHITA, KANSAS 67211

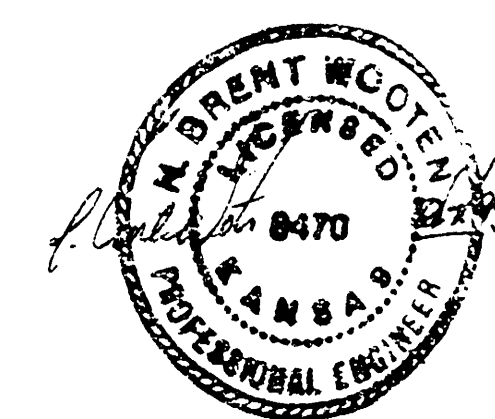

CREHBIEL ASSOCIATES
re • planning • interiors

Kansas 67211 (316) 267-8233 Fax: (316) 267-8566

date drawn 7-15-94 | revisions 10-6-94
prints issued



SATURN OF WICHITA SERVICE CENTER
CENTRAL & TYLER WICHITA, KANSAS

SG-1
of 10-4-3-a