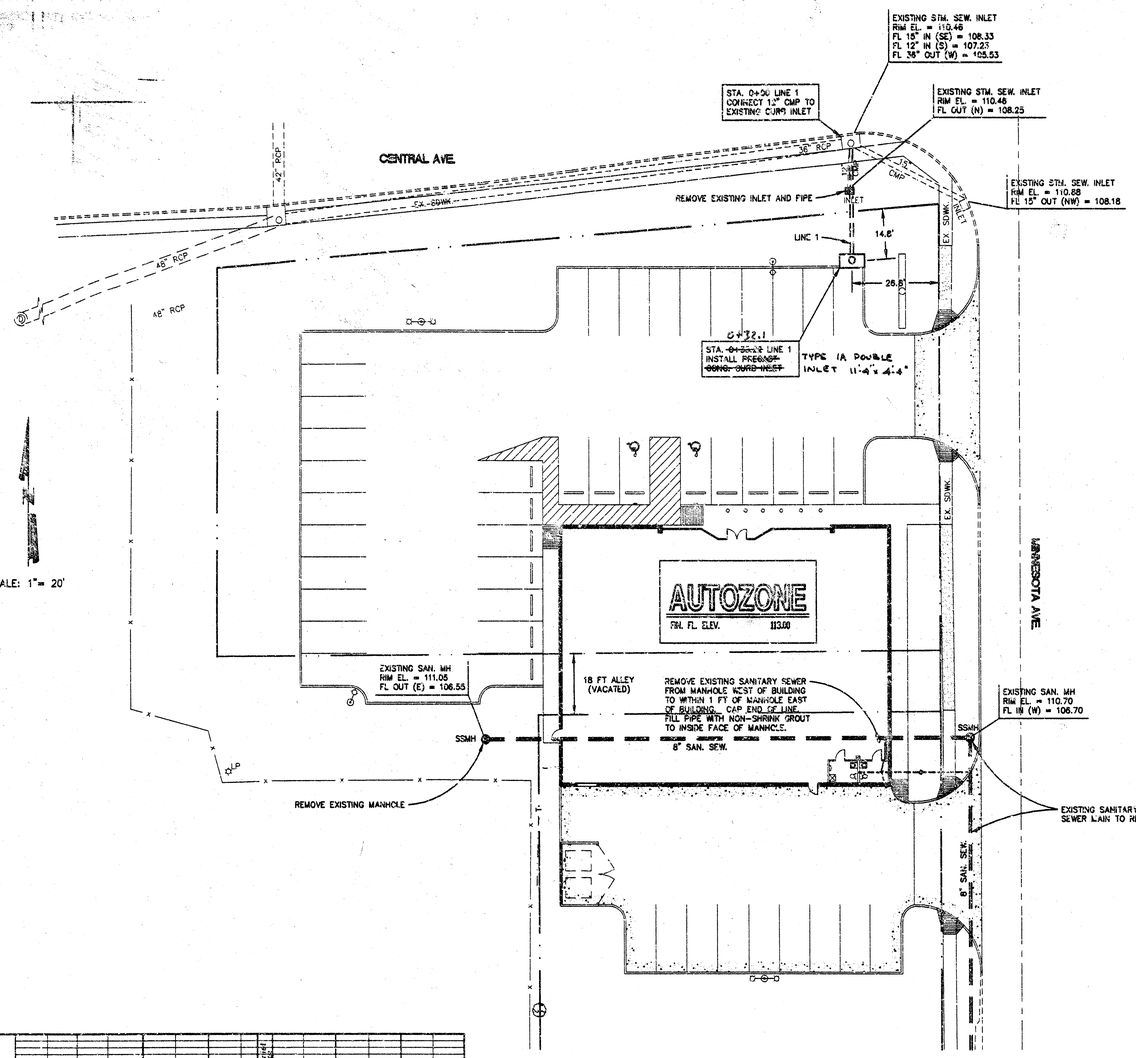

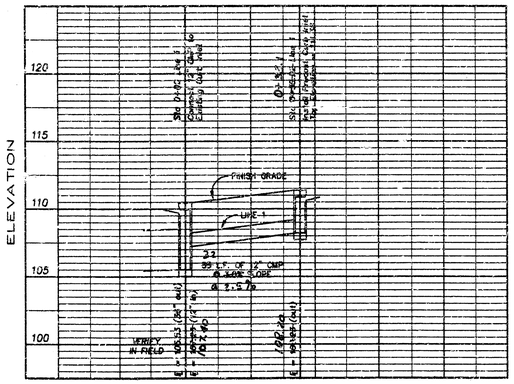

DRAINAGE PROFILE

HOR. SCALE: 1" = 20'
VERT. SCALE: 1" = 5'

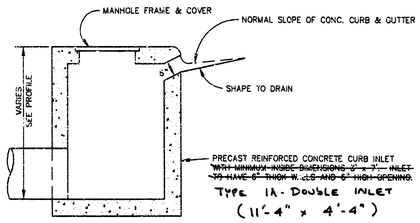

CURB INLET DETAIL

NTS

REMOVAL OF SANITARY SEWER & SWS EXTENSION
LOTS 3 – 18, BEN BAILEY'S ADDITION
CITY OF WICHITA
MICHAEL E. LINDEBAK, P.E. : CITY ENGINEER
PRIVATE PROJECT NO.: 659PPS (607861)

PROPOSED SITE IMPROVEMENTS PROVIDED BY:

AutoZone
STORE DEVELOPMENT
60 MADISON AVENUE MEMPHIS, TENNESSEE 38103
PHONE (901) 495-8719
FAX (901) 495-8901

TOPOGRAPHIC & BOUNDARY SURVEY PERFORMED BY:
COOK, FLATT & STROBEL

SEE SURVEY FOR COMPLETE LEGAL DESCRIPTION INFORMATION.

BENCHMARK

SQUARE CUT TOP OF CURB AT E. END OF
ISLAND CURB AT INTERSECTION OF CENTRAL
AND MINNESOTA. ELEV. 112.03

ELEVATION DATUM SHOWN IS CITY OF WICHITA DATUM,
ELEVATIONS SHOWN PLUS 1187.4 = SEA LEVEL DATUM.

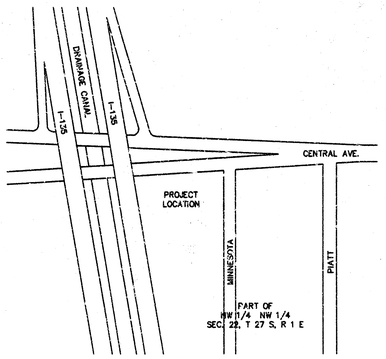

LOCATION MAP
NOT TO SCALE

San. Sew. Booked
4-4-97
JKB
As Per Plan

Booked
5-6-97
MCG
D-338

REV. NO. 1 – RELOCATED BUILDING AND PARKING LOT AREAS AS DIRECTED BY ARCHITECT

GENERAL CONSTRUCTION NOTES

1. CONSTRUCTION METHODS, CONSTRUCTION MATERIALS AND TESTING PROCEDURES SHALL CONFORM TO THE CITY OF WICHITA'S TECHNICAL SPECIFICATIONS FOR PUBLIC IMPROVEMENTS.
2. THE CONTRACTOR SHALL PROVIDE PERFORMANCE AND MAINTENANCE BONDS AS REQUIRED BY THE CITY OF WICHITA.
3. THE CONTRACTOR SHALL SECURE THE SERVICES OF AN ENGINEERING FIRM TO PROVIDE CONSTRUCTION STAKING AND INSPECTION AND VACUUM TESTING OF THE COMPLETED SEWER SYSTEM.
4. THE CONTRACTOR SHALL VERIFY LOCATION AND ELEVATION OF THE EXISTING SANITARY SEWER MAIN PRIOR TO BEGINNING CONSTRUCTION.
5. THE CONTRACTOR SHALL BE RESPONSIBLE FOR ANY DAMAGE AND SUBSEQUENT REPAIR OF UNDERGROUND UTILITIES OR PERTINENT OBSTRUCTIONS DURING THE COURSE OF HIS OR HER OPERATIONS ON THE CONSTRUCTION SITE OR THE IMMEDIATE AREA. CALL KANSAS ONE-CALL (1-800-344-7233) PRIOR TO BEGINNING CONSTRUCTION.
6. ALL DISTURBED AREAS SHALL BE SEEDED AND RESTORED TO EXISTING CONDITION.

APPROVED AS NOTED

By CITY ENGINEER OF WICHITA

Sanitary Sewers VRH 11/20/96

Storm Sewers VRH 11/20/96

Driveway Approaches

Water Mains

Paving

NOTE TO CONTRACTOR

INSPECTION AND TESTING FOR THIS PROJECT IS TO BE PROVIDED BY A LICENSED CONSULTING ENGINEERING FIRM UNDER CONTRACT WITH THE OWNER, DEVELOPER. SAID INSPECTION TO BE IN ACCORDANCE WITH THE CITY OF WICHITA STANDARD CONSTRUCTION ENGINEERING PRACTICES AND CERTIFIED BY A LICENSED PROFESSIONAL ENGINEER. NO WORK SHALL BE PERFORMED IN DEDICATED EASEMENTS OR THE PUBLIC RIGHT-OF-WAY BY THE CONTRACTOR WITHOUT SUCH INSPECTION NOR SHALL ANY WORK BE COMMENCED IN DEDICATED EASEMENTS OR PUBLIC RIGHT-OF-WAY WITHOUT WRITTEN AUTHORIZATION BY THE CITY ENGINEER.

REVISIONS	BY
NO. 1 – 11/18/96	BRP

PRIVATE PROJECT – CITY OF WICHITA
FOR
AUTOZONE
CENTRAL AND MINNESOTA
WICHITA, KANSAS

SAN. SEWER & SWS EXTENSION

Palmerton & Parrish, Inc.
2935 – K East Division (417) 864-6060
Springfield, MO 65803
3416 East 15th Street (417) 624-2005
Joplin, MO 64801

BRAD R. PARRISH
LICENSED
NO. 11270
KANSAS
PROFESSIONAL ENGINEER
11/18/96

JOB NO.	DATE
068349	10/21/96
DRAWN KRB	CHECKED BRP
SCALE 1" = 20'	
DRAWING NO. 68349SSW	

C1.1B