




SCALE: 1" = 20'

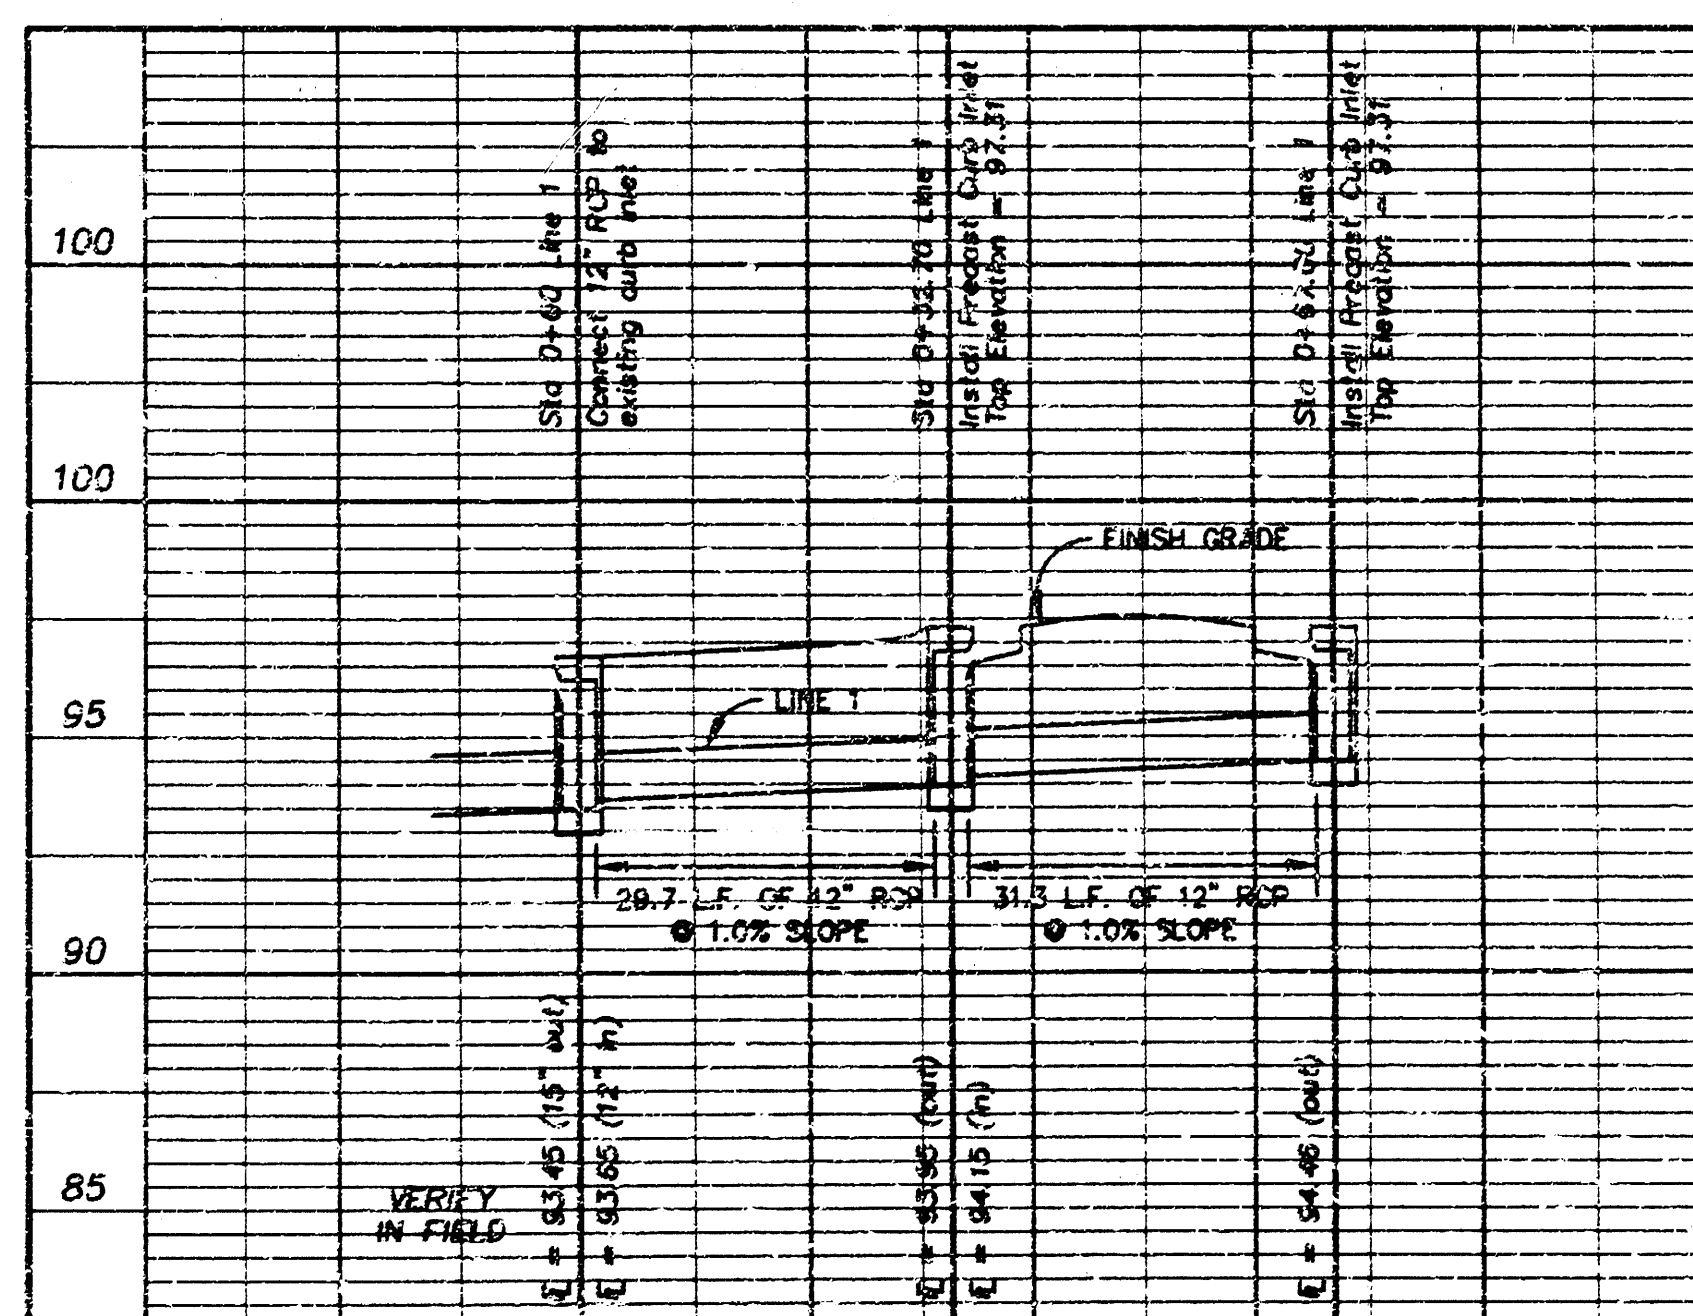

DRAINAGE PROFILE
HOR. SCALE: 1" = 20'
VERT. SCALE: 1" = 5'

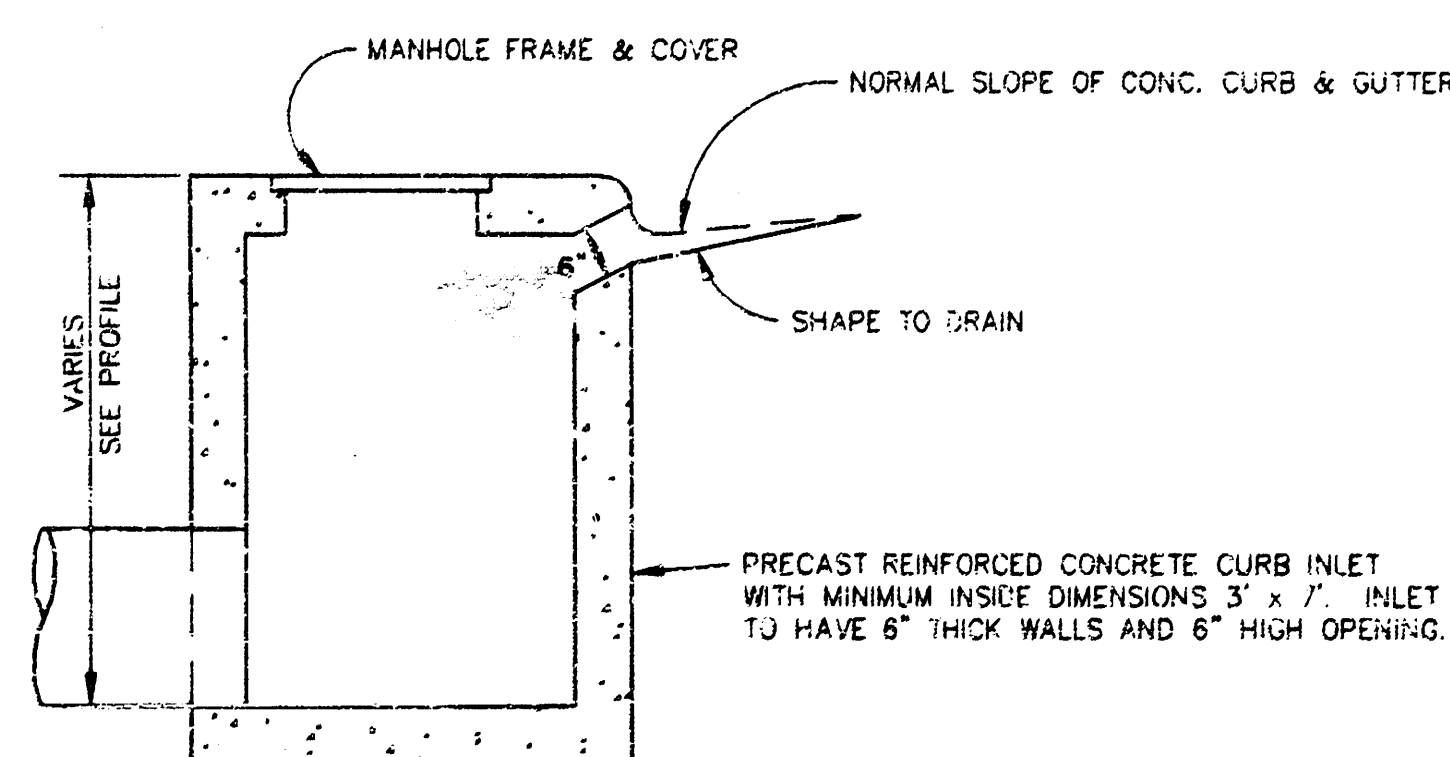

CURB INLET DETAIL
N.T.S.

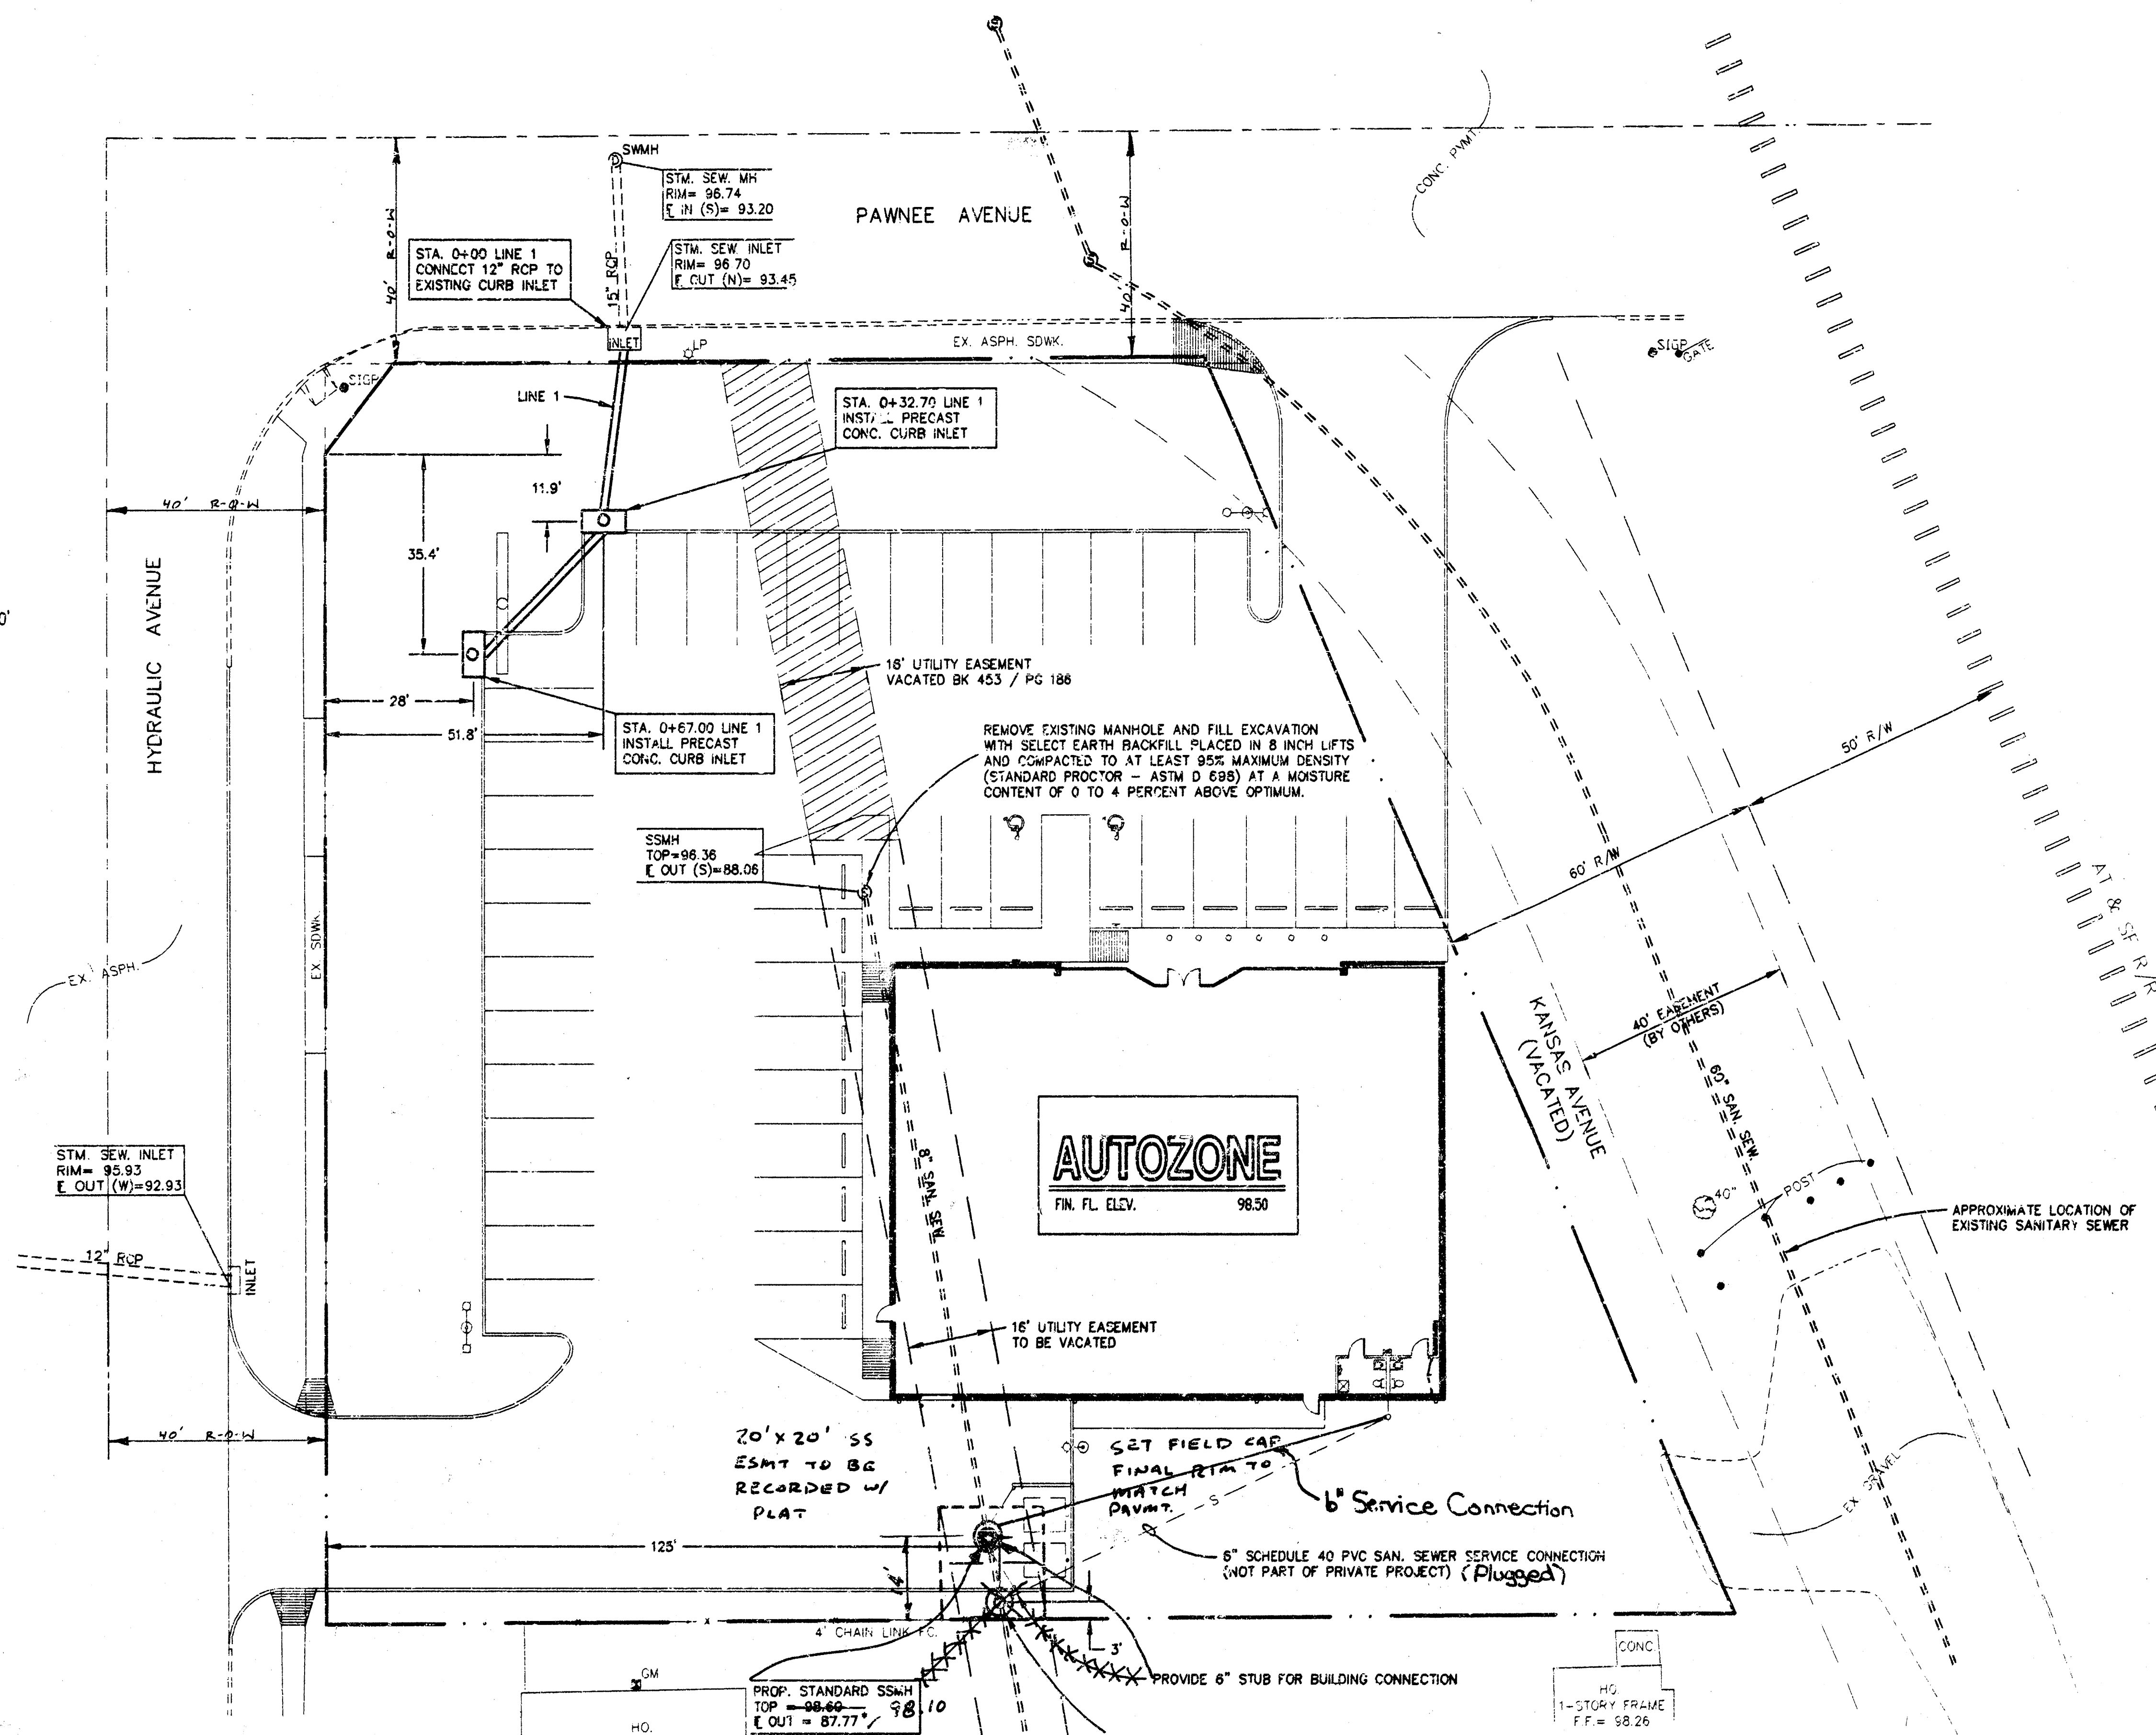

STORMWATER SYSTEM EXTENSION &
REMOVAL OF SANITARY SEWER
LOTS 1, 2, 3, 8, 9 & 10, PAWNEE ADDITION
CITY OF WICHITA
MICHAEL E. LINDEBAK, P.E. : CITY ENGINEER
PRIVATE PROJECT NO.: 660PPS (607861)

PROPOSED SITE IMPROVEMENTS PROVIDED BY:



TOPOGRAPHIC & BOUNDARY SURVEY PERFORMED BY:
COOK, FLATT & STROBEL

SEE SURVEY FOR COMPLETE LEGAL DESCRIPTION INFORMATION.

BENCHMARK

BRASS DISK IN RAILROAD SIGNAL BASE
200' ± EAST OF HYDRAULIC AND 25' ±
SOUTH OF PAWNEE. ELEV. 100.45

ELEVATION DATUM SHOWN IS CITY OF WICHITA DATUM,
ELEVATIONS SHOWN PLUS 1197.4 = SEA LEVEL DATUM.

