



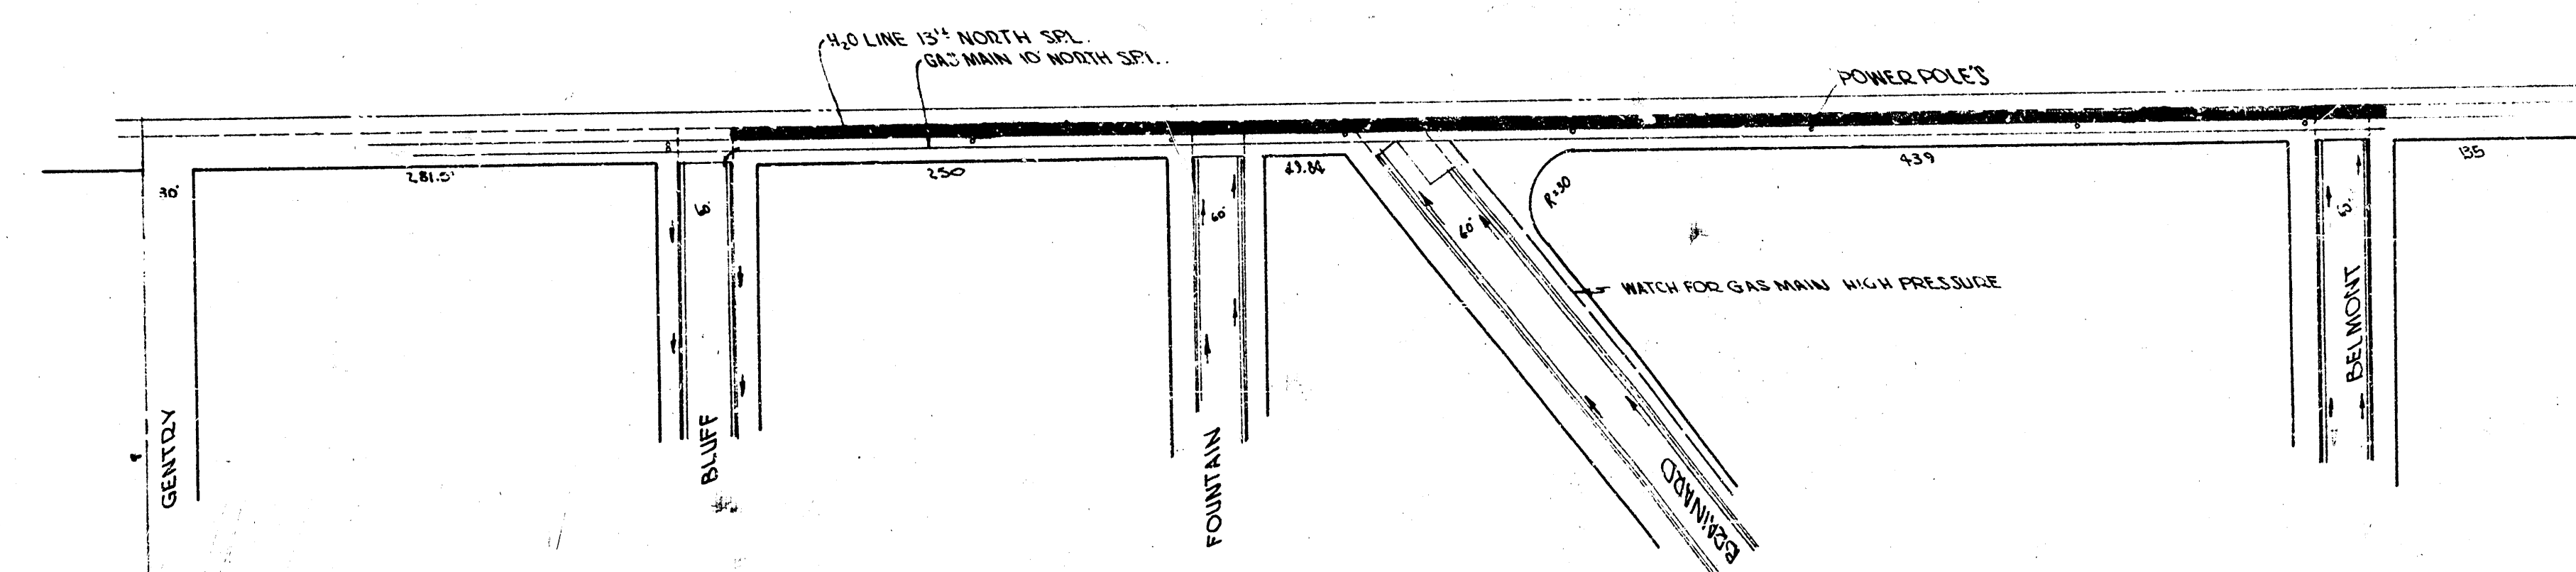

Note: Install 15" Tinhorn's at Fountain & Brainerd.
Install 10" Tinhorn at Belmont.

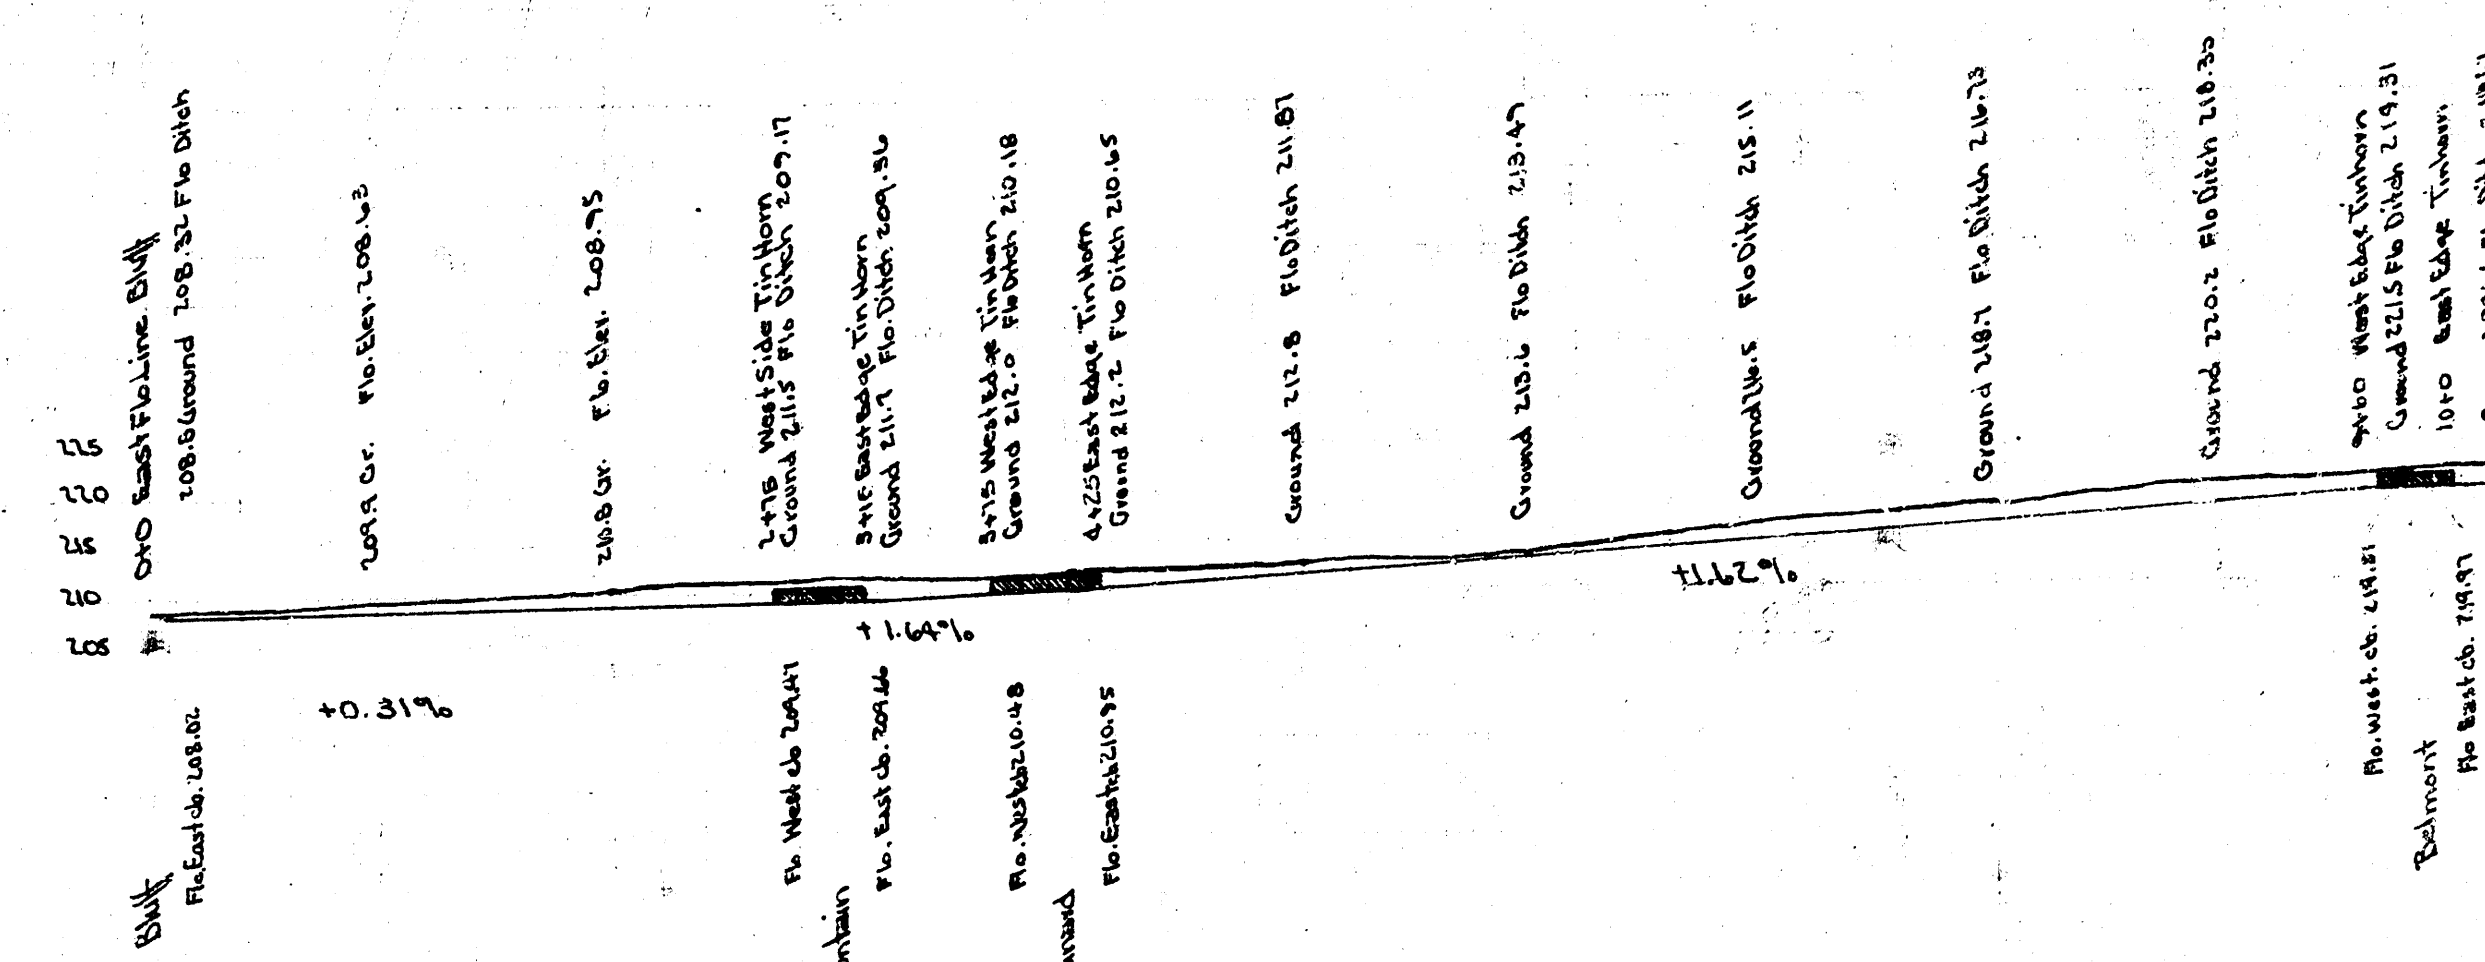

PROPOSED DRAINAGE DITCH ON SEVENTEENTH ST.