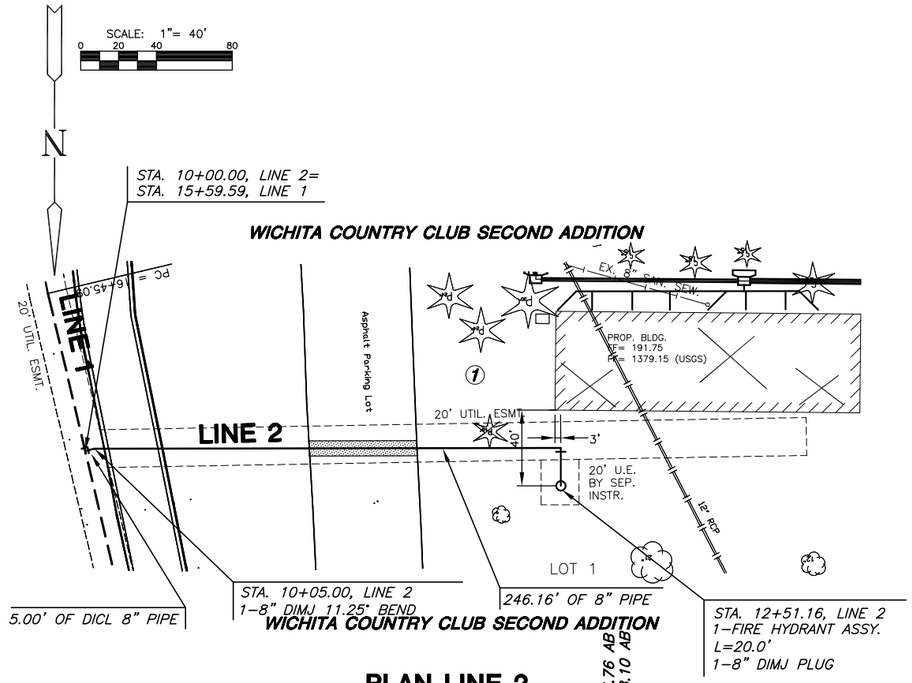

PLAN LINE 2

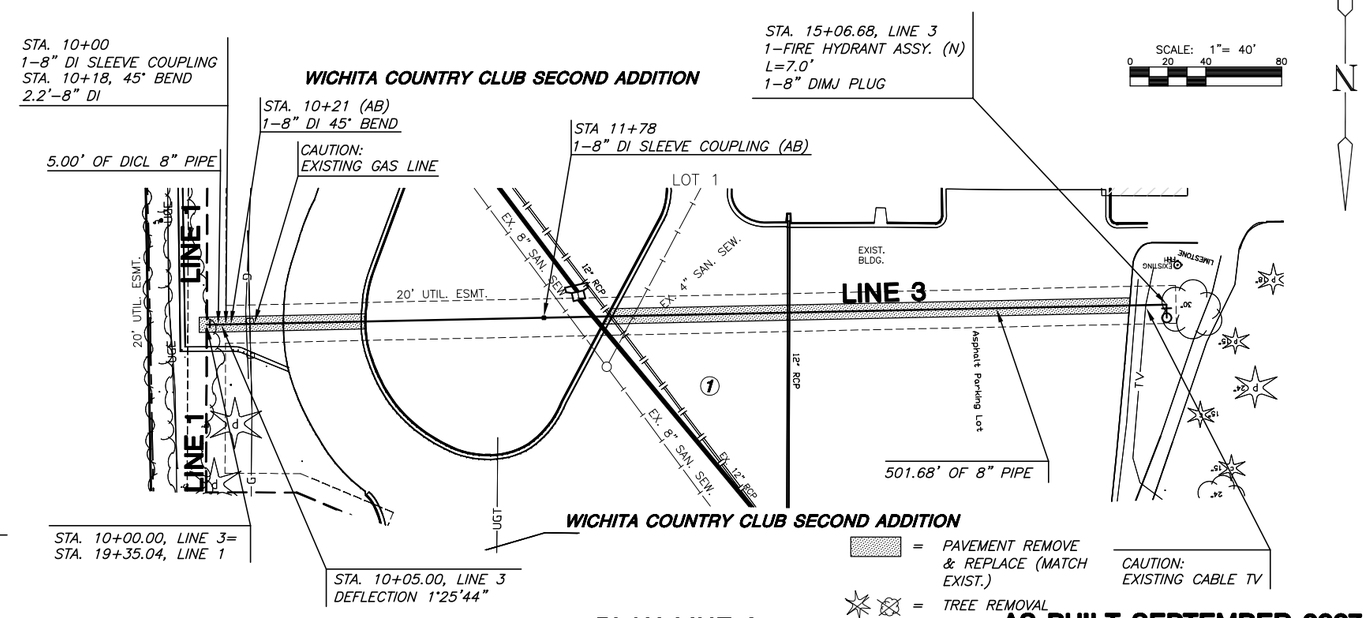

PLAN LINE 3

AS-BUILT SEPTEMBER 2007

PROFILE LINE 2

SCALE: HORIZ. 1"=40'
SCALE: VERT. 1"=5'

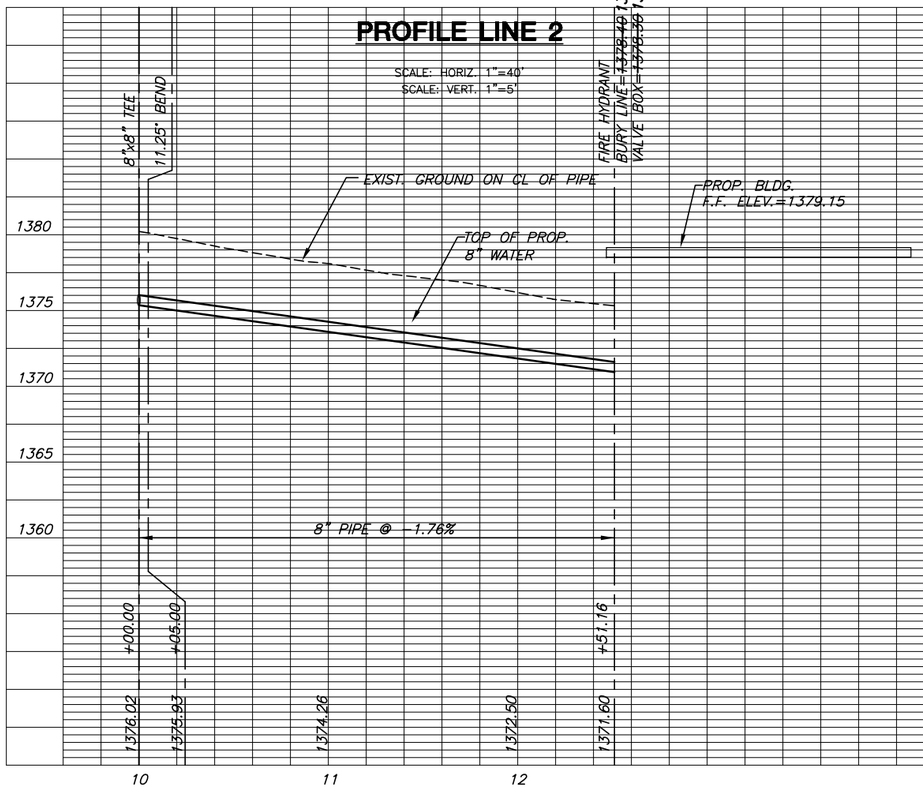

PROFILE LINE 3

SCALE: HORIZ. 1"=40'
SCALE: VERT. 1"=5'

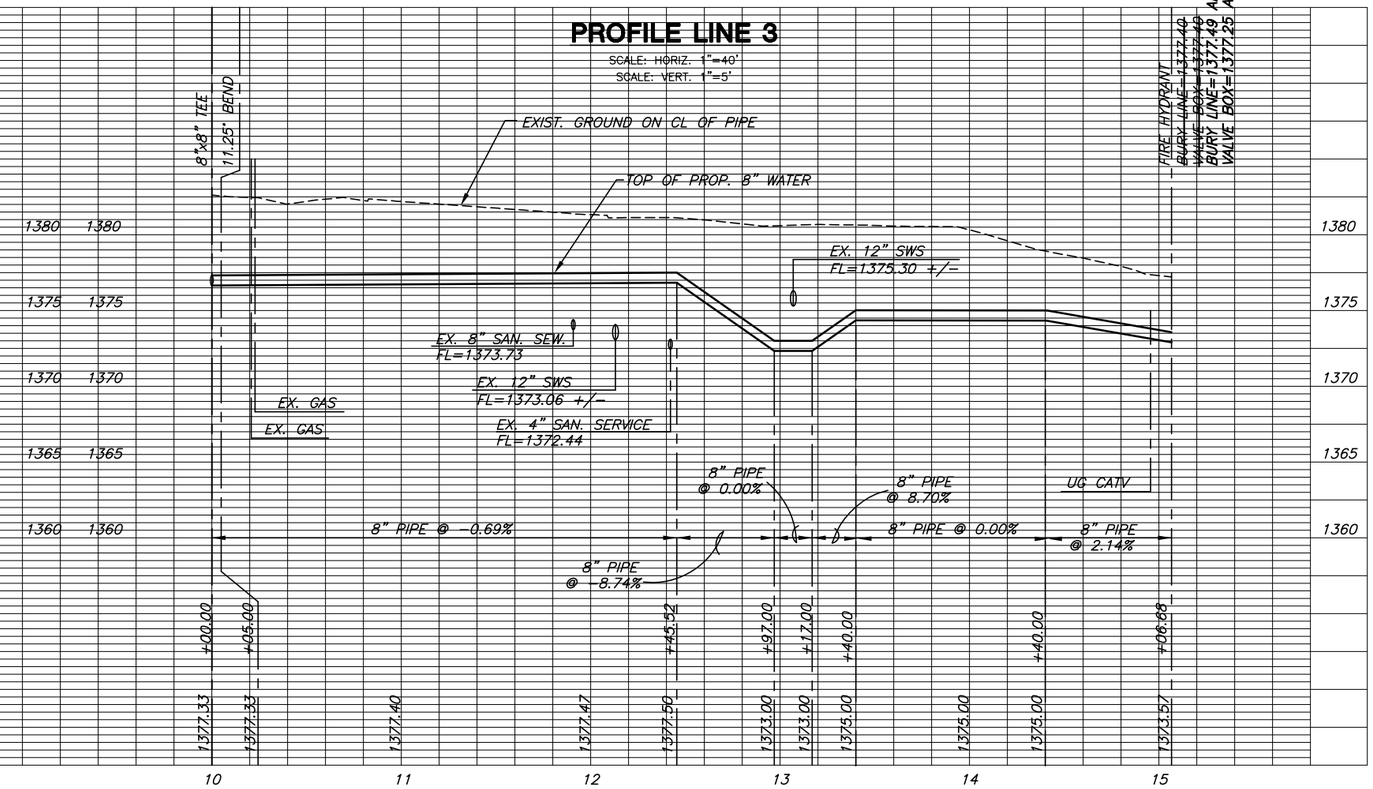

MKEC ENGINEERING CONSULTANTS, INC.
411 N. WEBB ROAD
WICHITA, KS. 67206
316 - 684 - 9600

WICHITA COUNTRY CLUB SECOND ADDITION

WATER PLANS

PLAN & PROFILE LINES 3 & 4
SHEET TITLE

07038
PROJECT NUMBER

MAB
DESIGN BY

DM
DRAWN BY

GJA
CHECKED BY

ISSUED
June 2007

REVISED

SHEET NO.
6 of 15

J:\CIVIL\07038\DWG\WTR\AS-BUILT\07038C4.DWG

PLOTTED: Monday, September 17, 2007 @ 11:25AM