



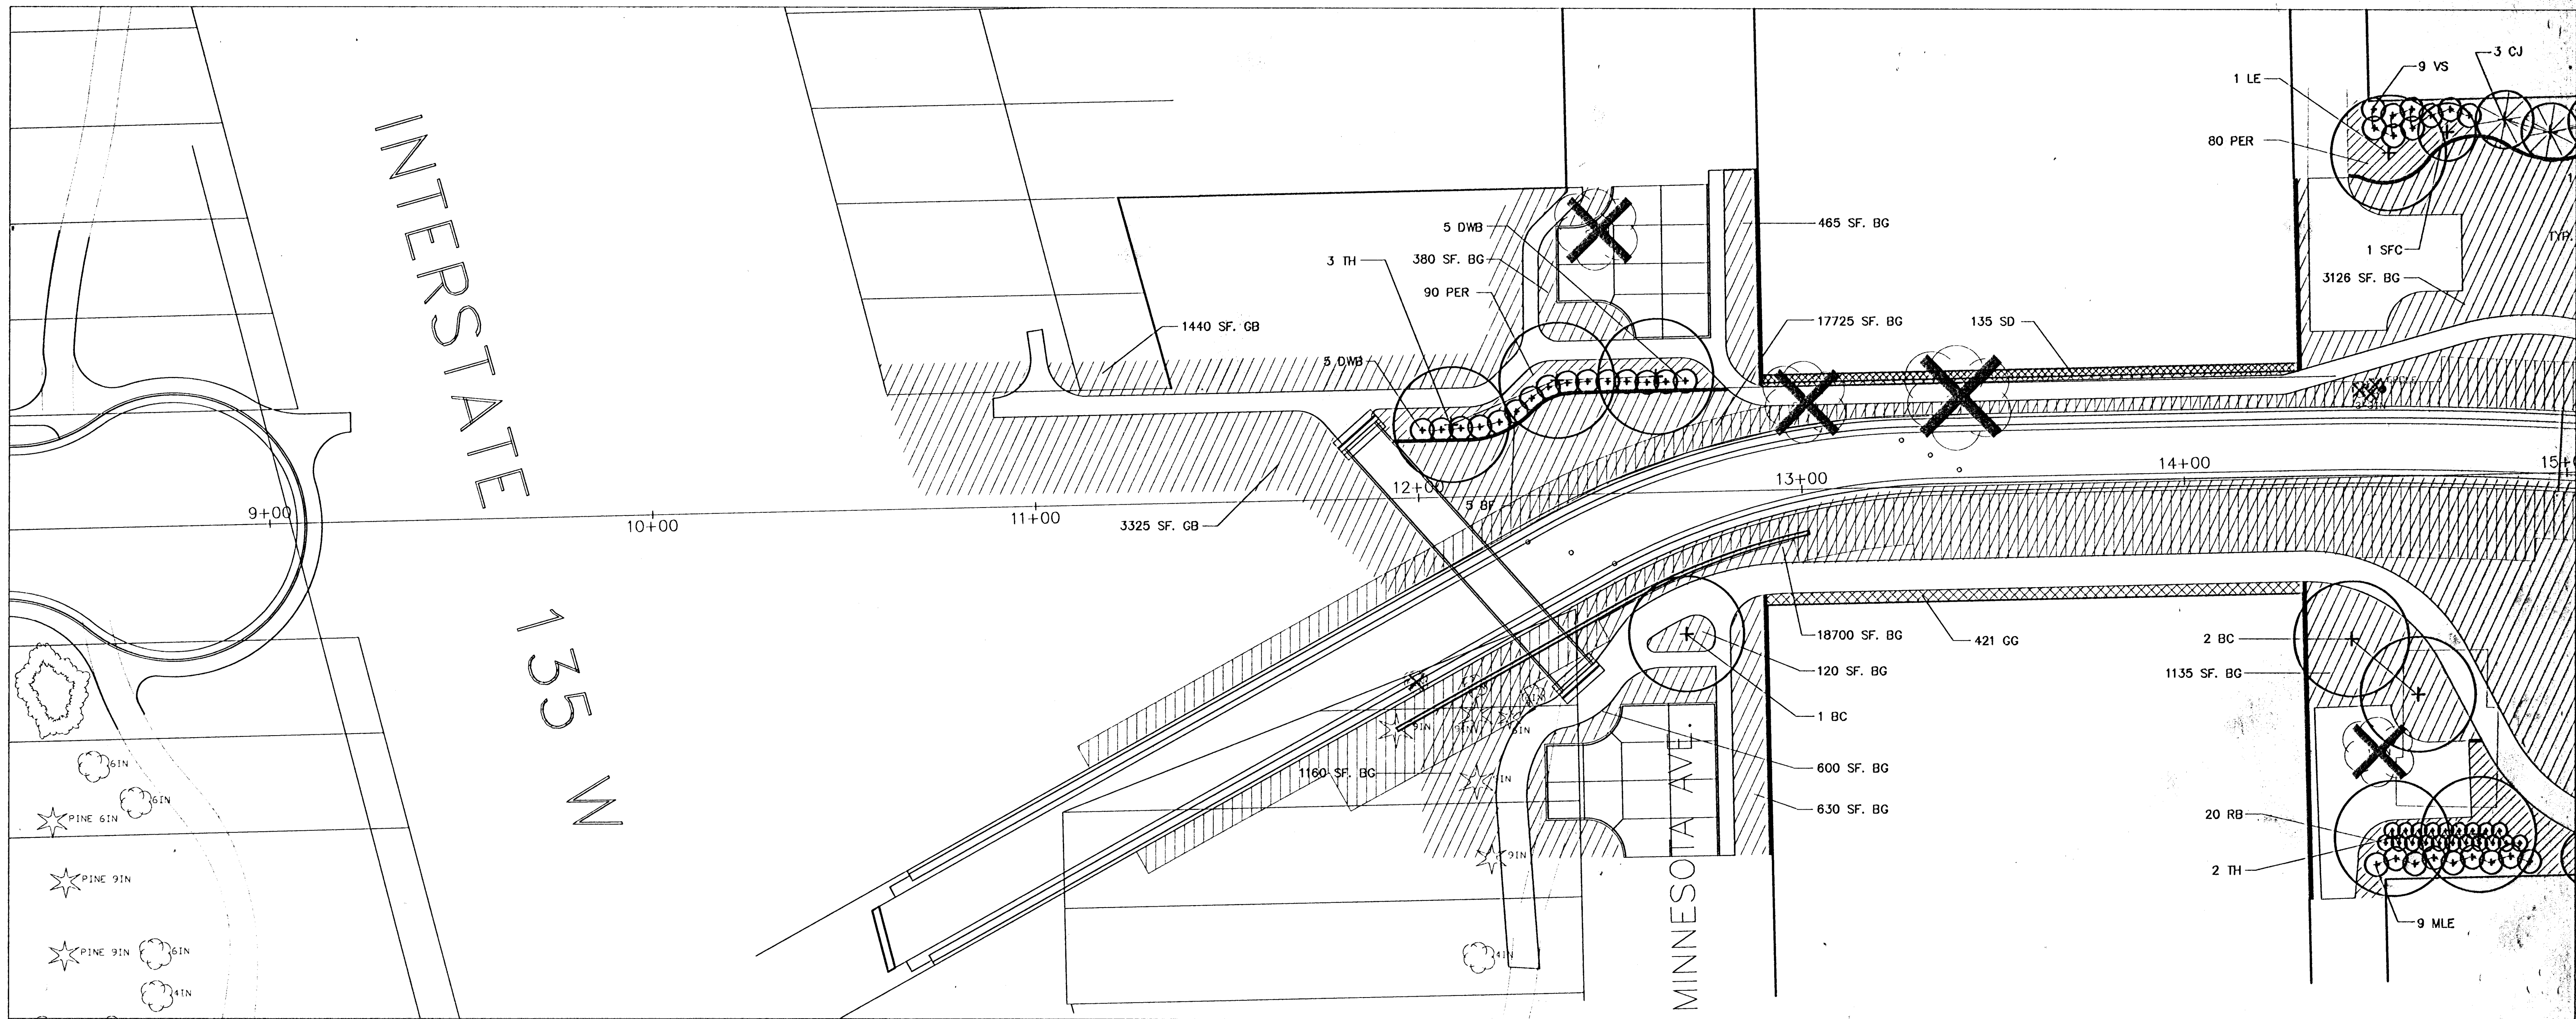

A

STATION 9+00.00 TO STATION 15+00.00

0' 10' 20' 1"=20'-0"

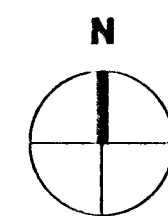


PLANT LIST FOR THIS SHEET

KEY	QTY.	COMMON NAME	BOTANICAL NAME	SIZE	CONDITION
LARGE DECIDUOUS TREES					
TH	5	THORNLESS HONEYLOCUST	Gleditsia triacanthos 'Shademaster'	2" to 2 1/2" cal.	Balled-in-Burlap
LE	1	LACEBARK ELM	Ulmus parvifolia	2" to 2 1/2" cal.	Balled-in-Burlap
BC	3	BALD CYPRESS	Taxodium distichum	2" to 2 1/2" cal.	Balled-in-Burlap
SMALL TO MEDIUM DECIDUOUS TREES					
SFC	1	FLOWERING CRABAPPLE	Malus spp. 'Spring Snow'	2" to 2 1/2" cal.	Balled-in-Burlap
SMALL TO MEDIUM BROADLEAF EVERGREEN TREES					
CJ	3	CANAERT JUNIPER	Juniperus virginiana 'Canaertii'	2" to 2 1/2" cal.	Balled-in-Burlap

KEY	QTY.	COMMON NAME	BOTANICAL NAME	SIZE	CONDITION
MEDIUM TO LARGE DECIDUOUS SHRUBS					
RB	20	REDLEAF BARBERRY	Berberis thunbergii 'atropurpurea'	5 gal.	Container
DWB	10	DWARF WINGED BURNING BUSH	Euonymus alatus 'compacta'	5 gal.	Container
MLE	9	MEDIUM LEAF EUONYMUS	Euonymus klautschovius	5 gal.	Container
BF	5	BORDER FORSYTHIA	Forsythia x intermedia	5 gal.	Container
VS	9	VANHOUTT SPIREA	Spirea x vanhouttei	5 gal.	Container
GROUNDCOVERS					
PER	170	PERIWINKLE	Vinca minor	1 gal., 24" O.C.	Container
PERENNIALS					
GG	421	BLANKET FLOWER	Gaillardia grandiflora	2 1/4" pot, 18" O.C.	Container
SD	135	SHASTA DAISY	Chrysanthemum superbum	2 1/4" pot, 18" O.C.	Container
GRASS					
BG	48806 SF.	COMMON BERMUDA GRASS	Cynodon dactylon	Seed	Drilled


NOTE

- CONSTRUCTION OF SANITARY SEWER SEE SHEET 4-10
- CONSTRUCTION OF STORM WATER SEWER SEE SHEET 11-15
- CONSTRUCTION OF PAVED CHANNEL SEE SHEET 16-23
- CONSTRUCTION OF PAVED CUL-DE-SACS SEE SHEET 24-33
- CONSTRUCTION OF PEDESTRIAN BRIDGE SEE SHEET 41-42
- CONSTRUCTION OF SIDEWALK/PATHWAY SEE SHEET 34-40

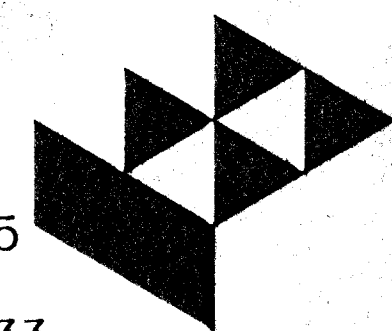

GossinLivingston

Architectural
Site/Civil
Mechanical
Electrical
Plumbing

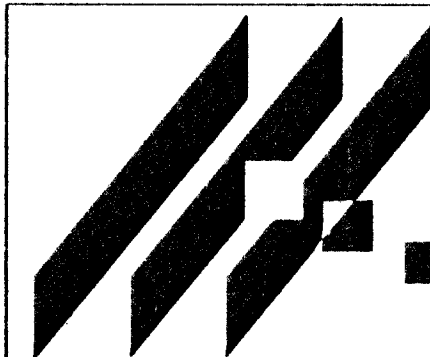

MID-KANSAS ENGINEERING
CONSULTANTS, INC.
411 N. WEBB ROAD
WICHITA, KS. 67206
316-684-9600

AREA "K" 3RD. STREET CHANNEL
PROJECT NAME

LANDSCAPE PLAN
SHEET TITLE

TDM, JRS
DESIGN BY.
JUNE 96
DATE

TDM, JRS
DRAWN BY.
9331_B1
JOB NO.

CHECKED BY.
43/77
SHEET/OF