


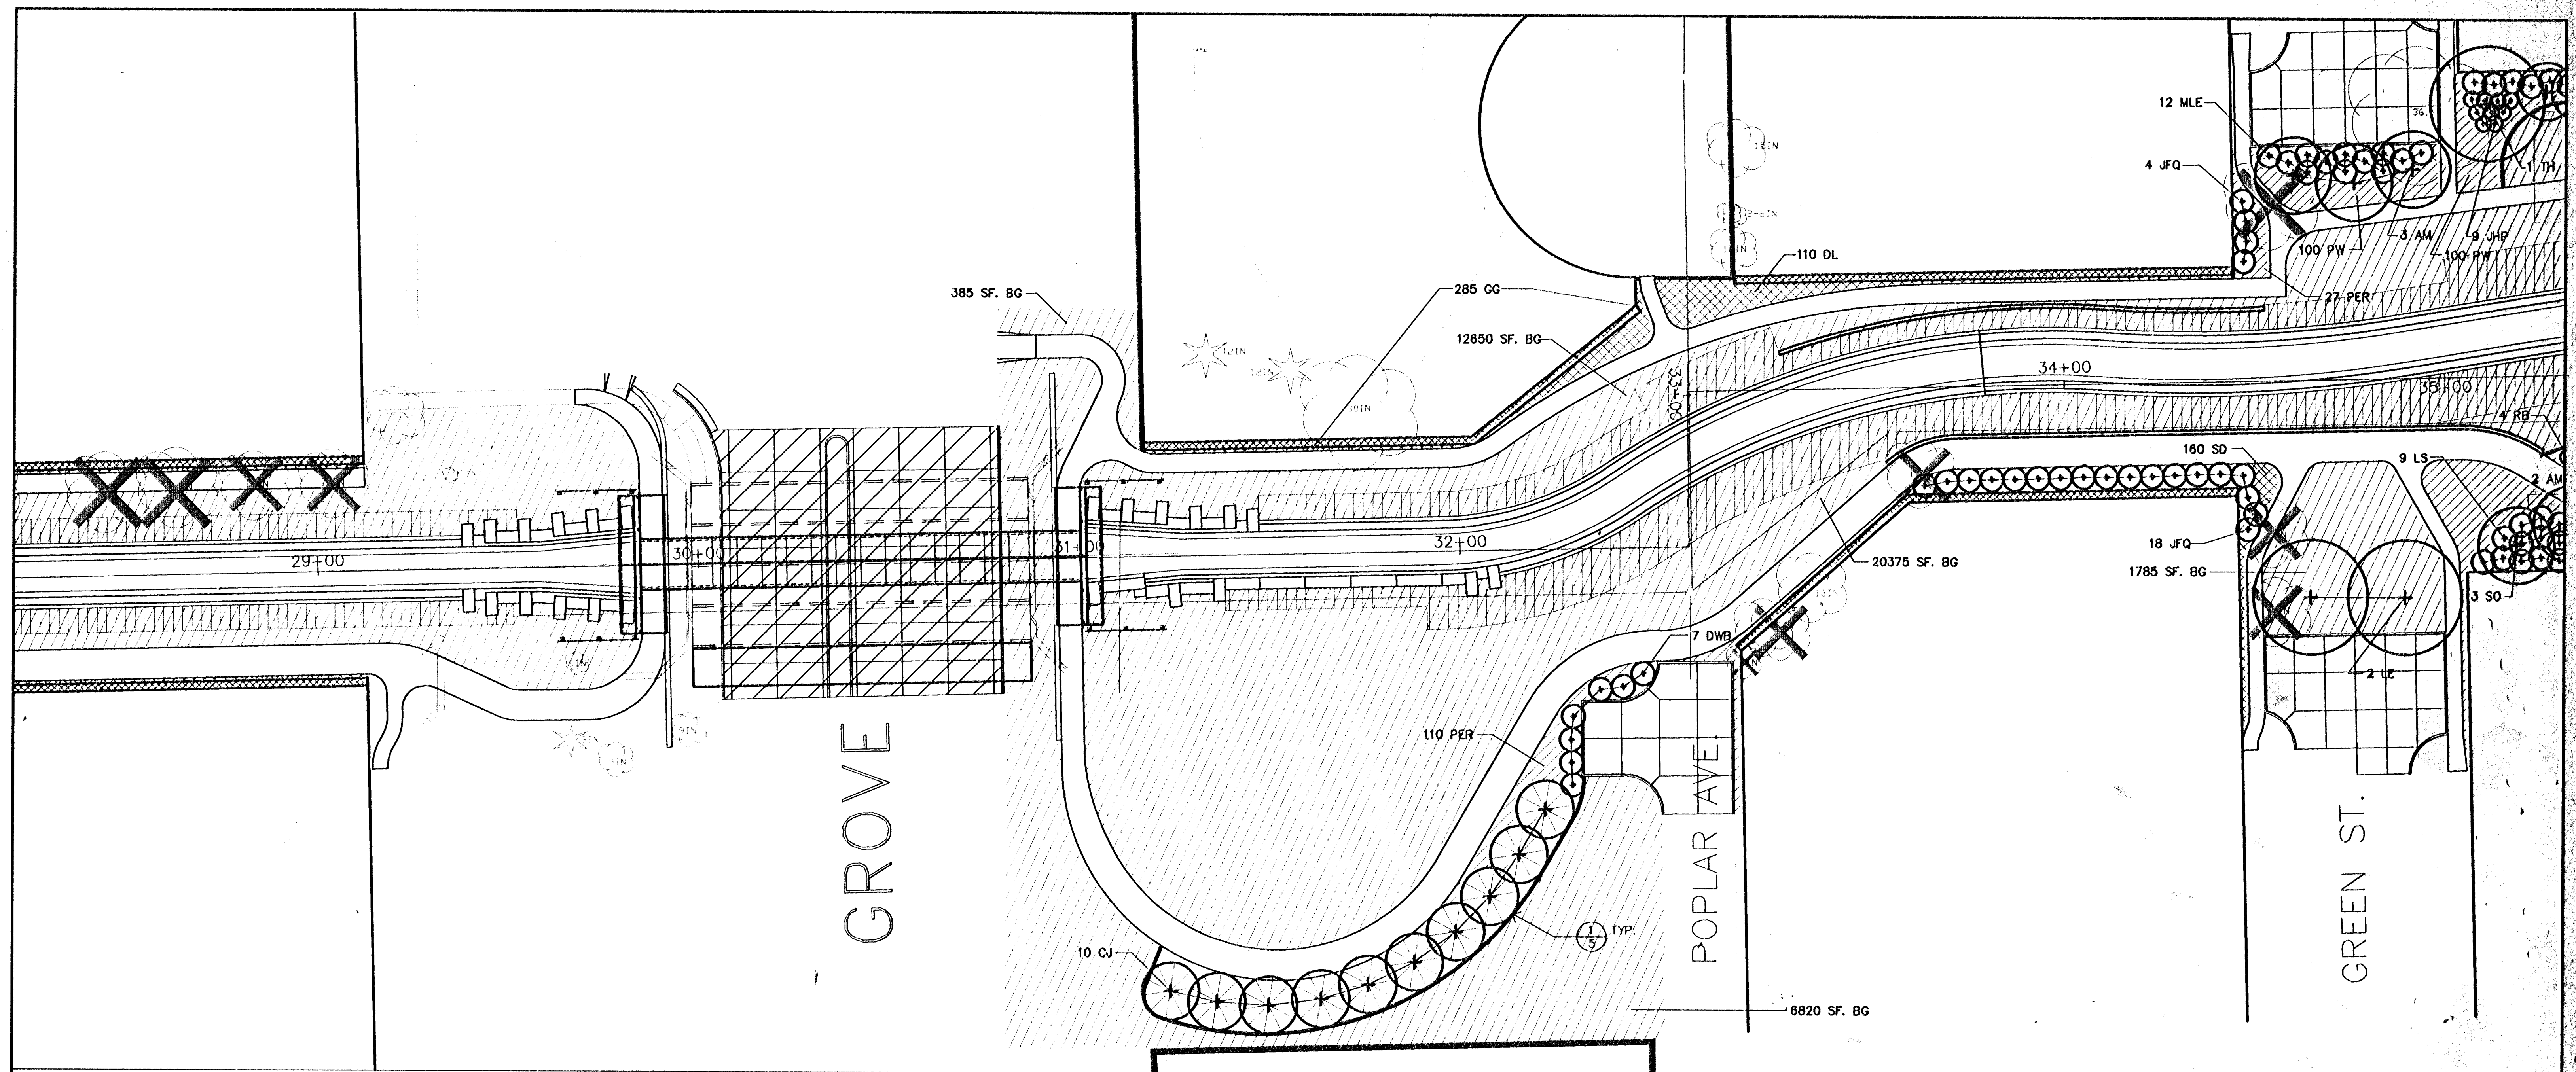

A STATION 28+00.00 TO STATION 35+00.00

0' 10' 20' 1"=20'-0"

N


PLANT LIST FOR THIS SHEET

KEY	QTY.	COMMON NAME	BOTANICAL NAME	SIZE	CONDITION
LARGE DECIDUOUS TREES					
TH	1	THORNLESS HONEYLOCUST	Gleditsia triacanthos 'Shademaster'	2" to 2 1/2" cal.	Balled-in-Burlap
LE	2	LACEBARK ELM	Ulmus parvifolia	2" to 2 1/2" cal.	Balled-in-Burlap
SMALL TO MEDIUM DECIDUOUS TREES					
AM	3	AMUR MAPLE	Acer ginnala 'Flame'	2" to 2 1/2" cal.	Balled-in-Burlap
SO	3	SAWTOOTH OAK	Quercus acutissima	2" to 2 1/2" cal.	Balled-in-Burlap
SMALL TO MEDIUM BROADLEAF EVERGREEN TREES					
CJ	10	CANAERT JUNIPER	Juniperus virginiana 'Canaertii'	2" to 2 1/2" cal.	Balled-in-Burlap
MEDIUM TO LARGE DECIDUOUS SHRUBS					
RB	4	REDLEAF BARBERRY	Berberis thunbergii 'atropurpurea'	5 gal.	Container
JFQ	22	JAPANESE FLOWERING QUINCE	Chaenomeles japonica	5 gal.	Container
DWB	7	DWARF WINGED BURNING BUSH	Euonymus alatus 'compacta'	5 gal.	Container

MLE	12	MEDIUM LEAF EUONYMUS	Euonymus kiautschovicus	5 gal.	Container
LS	9	LILAC	Lilac Syringa	5 gal.	Container
EVERGREEN SHRUBS					
JHP	9	ANDORRA JUNIPER	Juniperus horizontalis 'Plumosa'	2 gal.	Container
GROUNDCOVERS					
PW	200	PURPLELEAF WINTERCREEPER	Euonymus fortunei 'coloratus'	1 gal., 24" O.C.	Container
PER	137	PERIWINKLE	Vinca minor	1 gal., 24" O.C.	Container
PERENNIALS					
GG	285	BLANKET FLOWER	Gaillardia grandiflora	2 1/4" pot, 18" O.C.	Container
DL	110	DAYLILY	Hemerocallis hybrida	1 gal., 24" O.C.	Container
SD	180	SHASTA DAISY	Chrysanthemum superbum	2 1/4" pot, 18" O.C.	Container
GRASS					
BG	42015 SF.	COMMON BERMUDA GRASS	Cynodon dactylon	Seed	Drilled


NOTE

- CONSTRUCTION OF SANITARY SEWER SEE SHEET 4-10
- CONSTRUCTION OF STORM WATER SEWER SEE SHEET 11-15
- CONSTRUCTION OF PAVED CHANNEL SEE SHEET 16-23
- CONSTRUCTION OF PAVED CUL-DE-SACS SEE SHEET 24-33
- CONSTRUCTION OF PEDESTRIAN BRIDGE SEE SHEET 41-42
- CONSTRUCTION OF SIDEWALK/PATHWAY SEE SHEET 34-40

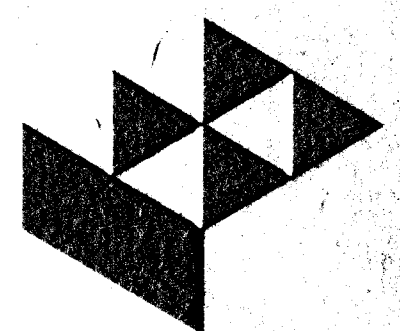

GossinLivingston


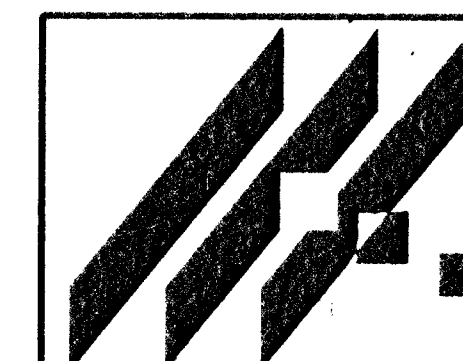

MID-KANSAS ENGINEERING
CONSULTANTS, INC.
411 N WEBB ROAD
WICHITA, KS. 67206
316-684-9600

AREA "K" 3RD. STREET CHANNEL
PROJECT NAME

LANDSCAPE PLAN
SHEET TITLE

TDM, JRS
DESIGN BY: TDM, JRS
DRAWN BY: CHECKED BY:
JUNE 98 19331_B4 48/77
DATE JOB NO. SHEET OF