


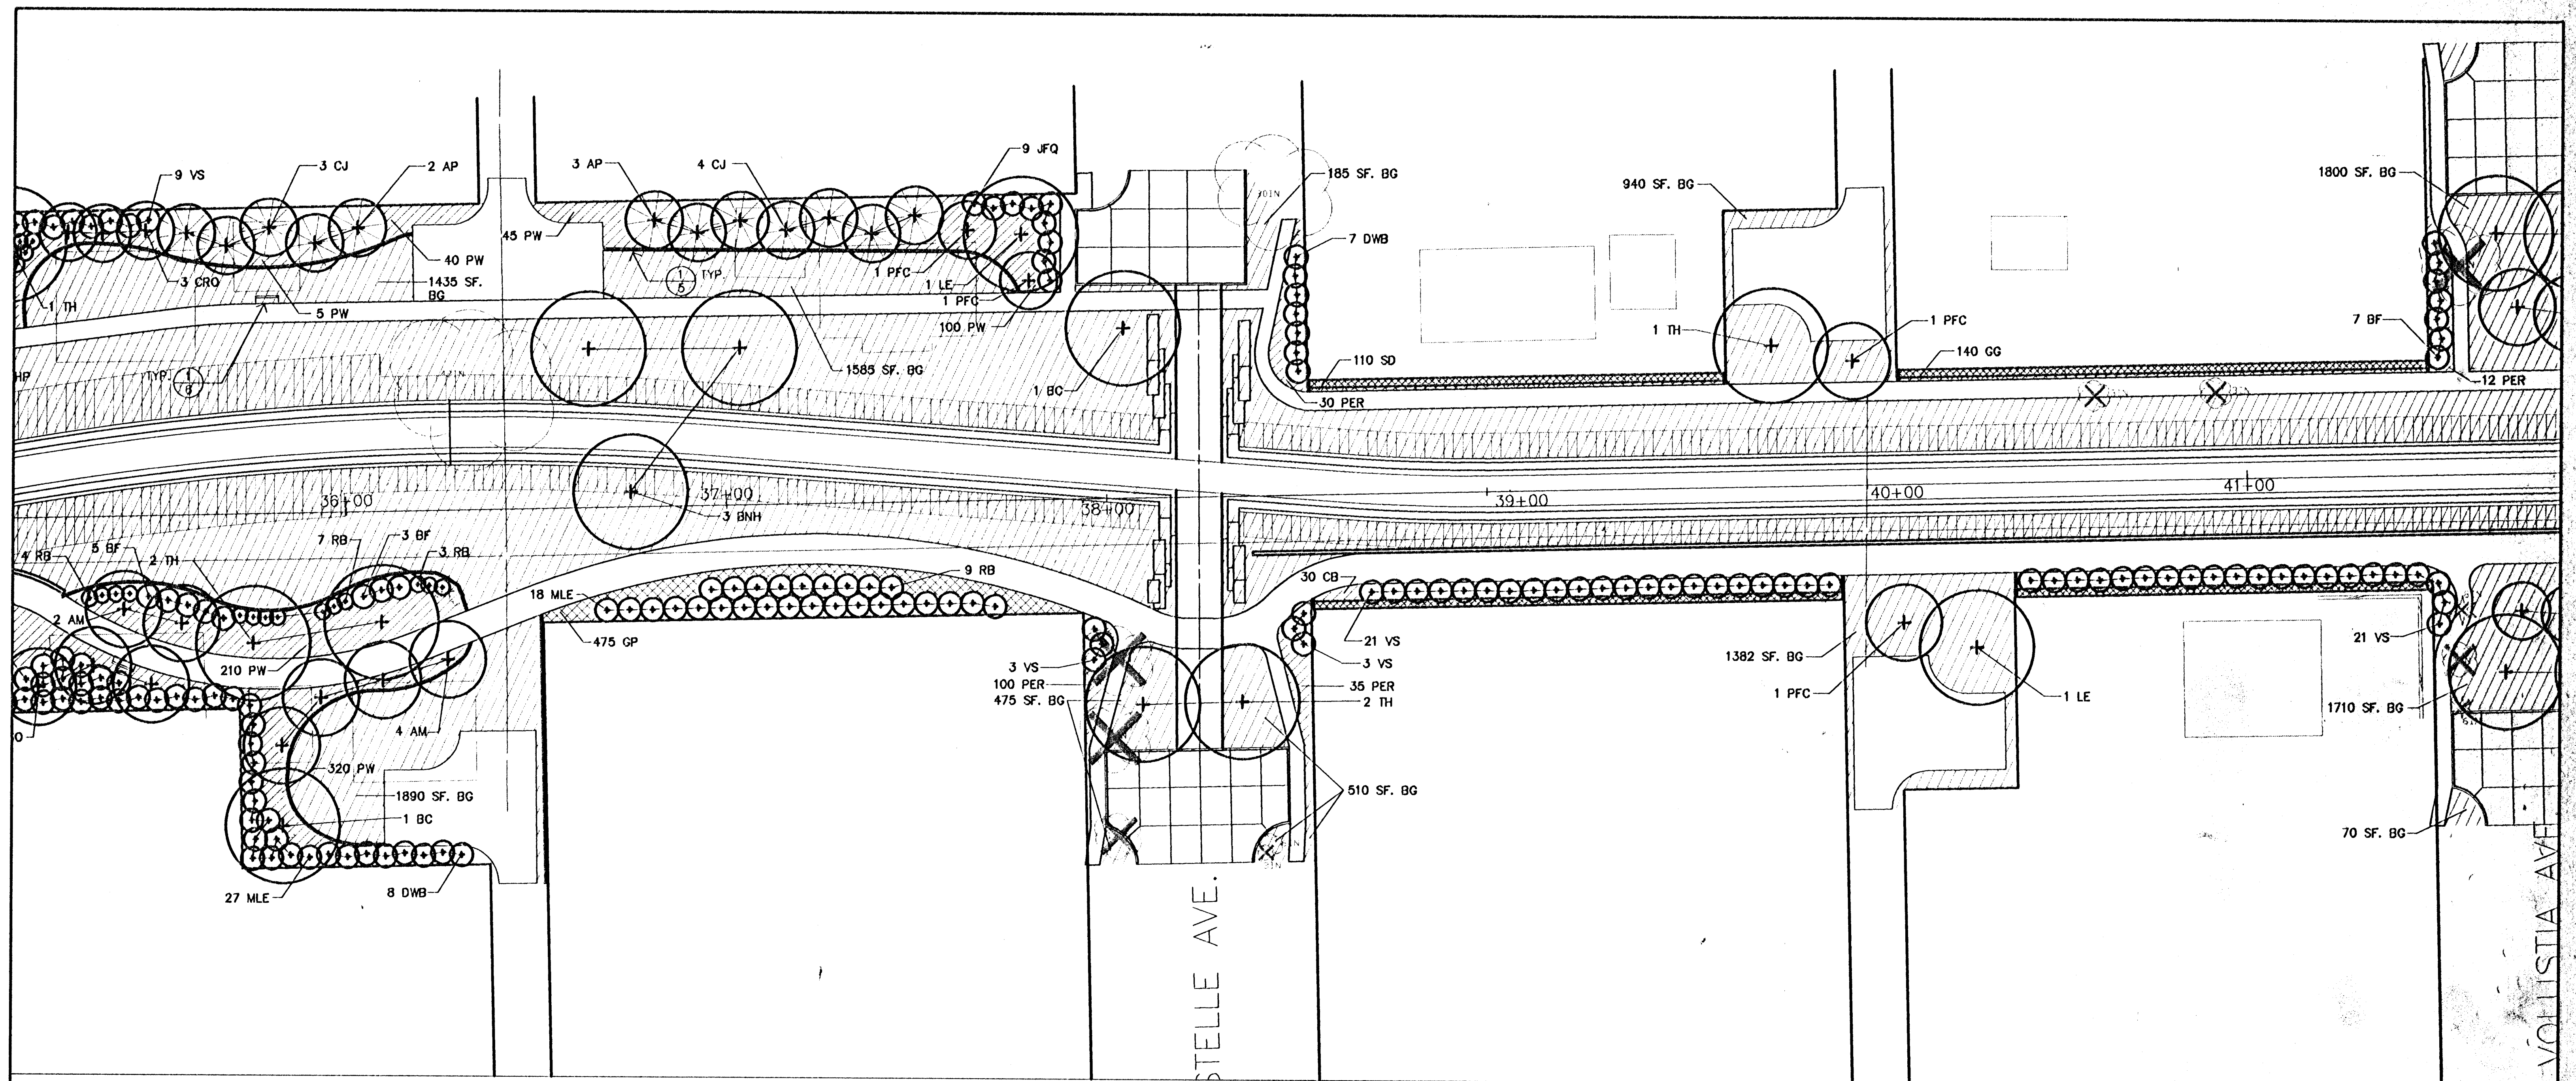

A STATION 35+00.00 TO STATION 41+00.00

0' 10' 20' 1"=20'-0"

N


PLANT LIST FOR THIS SHEET

KEY	QTY.	COMMON NAME	BOTANICAL NAME	SIZE	CONDITION
LARGE DECIDUOUS TREES					
BNH	3	RIVER BIRCH	<i>Betula nigra</i> 'Heritage'	2" to 2 1/2" cal.	Balled-in-Burlap
TH	6	THORNLESS HONEYLOCUST	<i>Gleditsia triacanthos</i> 'Shademaster'	2" to 2 1/2" cal.	Balled-in-Burlap
LE	2	LACEBARK ELM	<i>Ulmus parvifolia</i>	2" to 2 1/2" cal.	Balled-in-Burlap
BC	2	BALD CYPRESS	<i>Taxodium distichum</i>	2" to 2 1/2" cal.	Balled-in-Burlap
SMALL TO MEDIUM DECIDUOUS TREES					
AM	6	AMUR MAPLE	<i>Acer ginnala</i> 'Flame'	2" to 2 1/2" cal.	Balled-in-Burlap
CRO	3	OKLAHOMA REDBUD	<i>Cercis reniformis</i> 'Oklahoma'	2" to 2 1/2" cal.	Balled-in-Burlap
PFC	4	FLOWERING CRABAPPLE	<i>Malus spp.</i> 'Prairifire'	2" to 2 1/2" cal.	Balled-in-Burlap
SMALL TO MEDIUM BROADLEAF EVERGREEN TREES					
CJ	7	CANAERT JUNIPER	<i>Juniperus virginiana</i> 'Canaertii'	2" to 2 1/2" cal.	Balled-in-Burlap
AP	5	AUSTRIAN PINE	<i>Pinus nigra</i>	2" to 2 1/2" cal.	Balled-in-Burlap
MEDIUM TO LARGE DECIDUOUS SHRUBS					

RB	23	REDLEAF BARBERRY	<i>Berberis thunbergii</i> 'atropurpurea'	5 gal.	Container
JFQ	9	JAPANESE FLOWERING QUINCE	<i>Chaenomeles japonica</i>	5 gal.	Container
DWB	15	DWARF WINGED BURNING BUSH	<i>Euonymus alatus</i> 'compacta'	5 gal.	Container
MLE	45	MEDIUM LEAF EUONYMUS	<i>Euonymus klatschovicus</i>	5 gal.	Container
BF	15	BORDER FORSYTHIA	<i>Forsythia x intermedia</i>	5 gal.	Container
VS	57	VANHOUTT SPIREA	<i>Spiraea x vanhouttei</i>	5 gal.	Container
GROUND COVERS					
PW	720	PURPLELEAF WINTERCREEPER	<i>Euonymus fortunei</i> 'coloratus'	1 gal., 24" O.C.	Container
PER	177	PERIWINKLE	<i>Vinca minor</i>	1 gal., 24" O.C.	Container
PERENNIALS					
GG	140	BLANKET FLOWER	<i>Gaillardia grandiflora</i>	2 1/4" pot, 18" O.C.	Container
CB	30	COREL BELLS	<i>Heuchera sanguinea</i>	2 1/4" pot, 18" O.C.	Container
SD	110	SHASTA DAISY	<i>Chrysanthemum superbum</i>	2 1/4" pot, 18" O.C.	Container
GP	475	GARDEN PHLOX	<i>Phlox paniculata</i>	4" pot, 18" O.C.	Container
GRASS					
BG	11982 SF.	COMMON BERMUDA GRASS	<i>Cynodon dactylon</i>	Seed	Drilled

NOTE

- CONSTRUCTION OF SANITARY SEWER SEE SHEET 4-10
- CONSTRUCTION OF STORM WATER SEWER SEE SHEET 11-15
- CONSTRUCTION OF PAVED CHANNEL SEE SHEET 16-23
- CONSTRUCTION OF PAVED CUL-DE-SACS SEE SHEET 24-33
- CONSTRUCTION OF PEDESTRIAN BRIDGE SEE SHEET 41-42
- CONSTRUCTION OF SIDEWALK/PATHWAY SEE SHEET 34-40

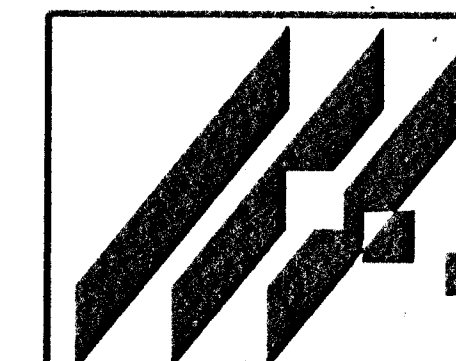


MID-KANSAS ENGINEERING
CONSULTANTS, INC.
411 N. WEBB ROAD
WICHITA, KS. 67206
316-684-9600

AREA "K" 3RD. STREET CHANNEL
PROJECT NAME

LANDSCAPE PLAN
SHEET TITLE

DESIGN BY: **IDM, JRS** DRAWN BY: **IDM, JRS** CHECKED BY: **IDM, JRS**
DATE: **JUNE 96** JOB NO.: **9331-B5** SHEET OF: **47, 77**

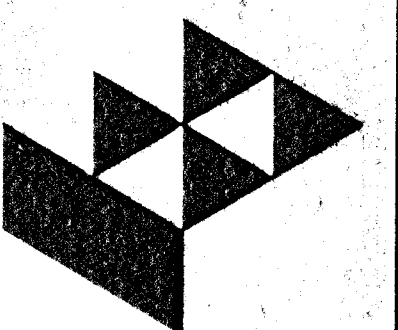

GossenLivingston
Landscape Architecture
411 N. WEBB ROAD
WICHITA, KS. 67206
316-684-9600