



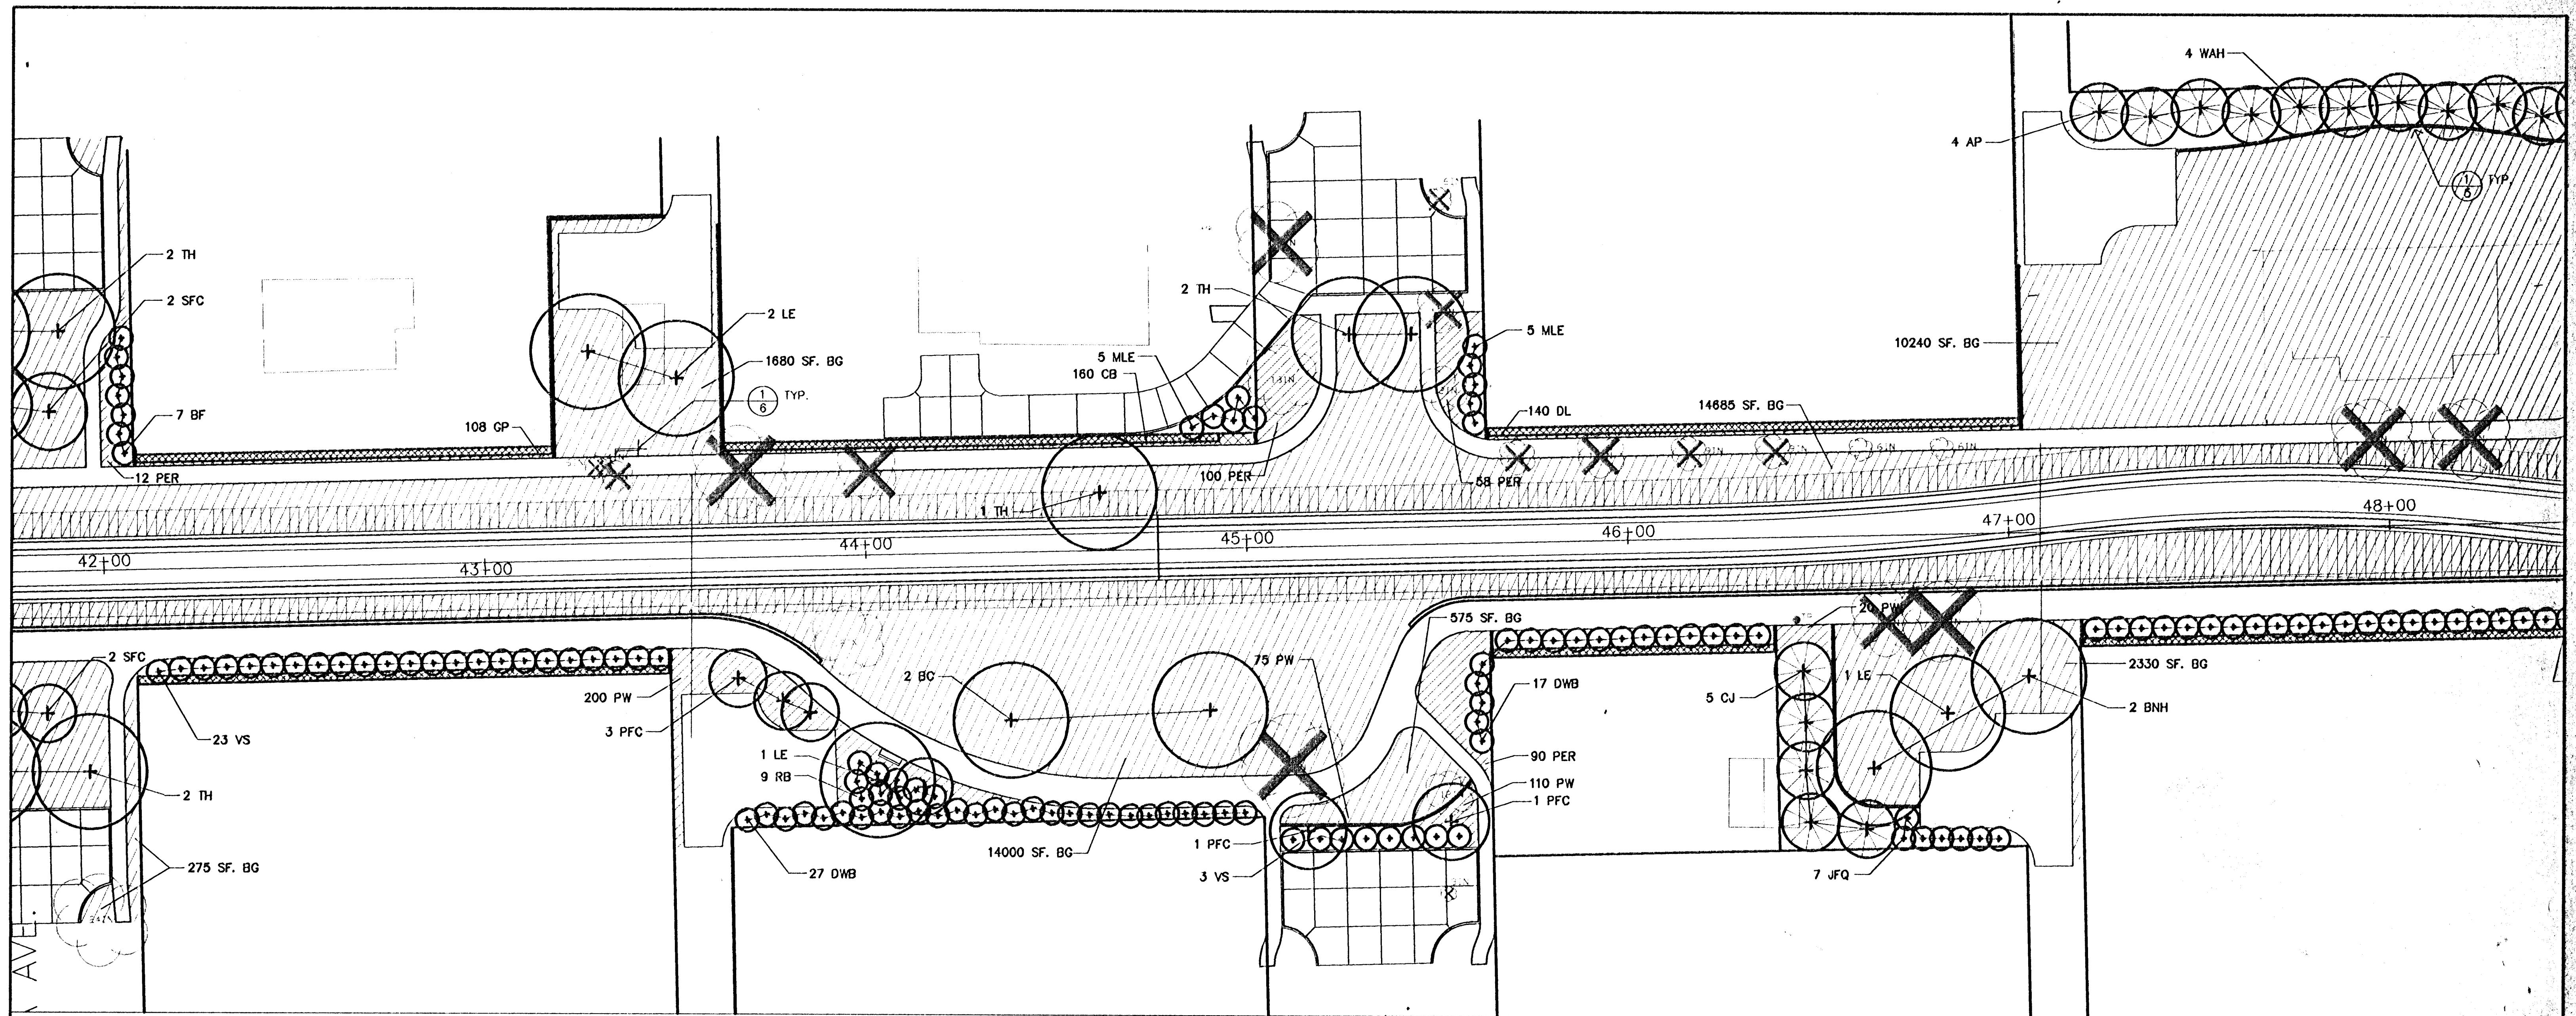

A STATION 41+00.00 TO STATION 48+00.00

0' 10' 20' 1"=20'-0"

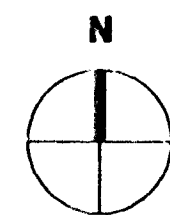


PLANT LIST FOR THIS SHEET

KEY	QTY.	COMMON NAME	BOTANICAL NAME	SIZE	CONDITION
LARGE DECIDUOUS TREES					
BNH	2	RIVER BIRCH	Betula nigra 'Heritage'	2" to 2 1/2" cal.	Balled-in-Burlap
TH	7	THORNLESS HONEYLOCUST	Gleditsia triacanthos 'Shademaster'	2" to 2 1/2" cal.	Balled-in-Burlap
LE	4	LACEBARK ELM	Ulmus parvifolia	2" to 2 1/2" cal.	Balled-in-Burlap
BC	2	BALD CYPRESS	Taxodium distichum	2" to 2 1/2" cal.	Balled-in-Burlap
SMALL TO MEDIUM DECIDUOUS TREES					
WAH	4	WASHINGTON HAWTHORN	Crataegus phaenopyrum 'Select'	2" to 2 1/2" cal.	Balled-in-Burlap
PFC	5	FLOWERING CRABAPPLE	Malus spp. 'Prairifire'	2" to 2 1/2" cal.	Balled-in-Burlap
SFC	4	FLOWERING CRABAPPLE	Malus spp. 'Spring Snow'	2" to 2 1/2" cal.	Balled-in-Burlap
SMALL TO MEDIUM BROADLEAF EVERGREEN TREES					
CJ	5	CANAERT JUNIPER	Juniperus virginiana 'Canaertii'	2" to 2 1/2" cal.	Balled-in-Burlap
AP	4	AUSTRIAN PINE	Pinus nigra	2" to 2 1/2" cal.	Balled-in-Burlap
MEDIUM TO LARGE DECIDUOUS SHRUBS					
RB	9	REDLEAF BARBERRY	Berberis thunbergii 'atropurpurea'	5 gal.	Container


JFQ	7	JAPANESE FLOWERING QUINCE	Chaenomeles japonica	5 gal.	Container
DWB	44	DWARF WINGED BURNING BUSH	Euonymus alatus 'compacta'	5 gal.	Container
MLE	10	MEDIUM LEAF EUONYMUS	Euonymus klatschovicus	5 gal.	Container
BF	7	BORDER FORSYTHIA	Forsythia x intermedia	5 gal.	Container
VS	26	VANHOUTT SPIREA	Spiraea x vanhouttei	5 gal.	Container
GROUNDCOVERS					
PW	405	PURPLELEAF WINTERCREEPER	Euonymus fortunei 'coloratus'	1 gal., 24" O.C.	Container
PER	280	PERIWINKLE	Vinca minor	1 gal., 24" O.C.	Container
PERENNIALS					
GG	45	BLANKET FLOWER	Gaillardia grandiflora	2 1/4" pot, 18" O.C.	Container
CB	180	COREL BELLS	Heuchera sanguinea	2 1/4" pot, 18" O.C.	Container
GP	108	GARDEN PHLOX	Phlox paniculata	4" pot, 18" O.C.	Container
GRASS					
BG	43785 SF.	COMMON BERMUDA GRASS	Cynodon dactylon	Seed	Drilled

NOTE

- CONSTRUCTION OF SANITARY SEWER SEE SHEET 4-10
- CONSTRUCTION OF STORM WATER SEWER SEE SHEET 11-15
- CONSTRUCTION OF PAVED CHANNEL SEE SHEET 16-23
- CONSTRUCTION OF PAVED CUL-DE-SACS SEE SHEET 24-33
- CONSTRUCTION OF PEDESTRIAN BRIDGE SEE SHEET 41-42
- CONSTRUCTION OF SIDEWALK/PATHWAY SEE SHEET 34-40

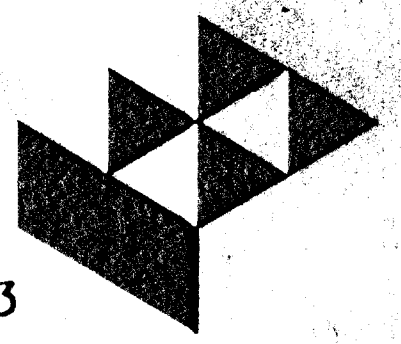

GosselinLivingston
Architectural

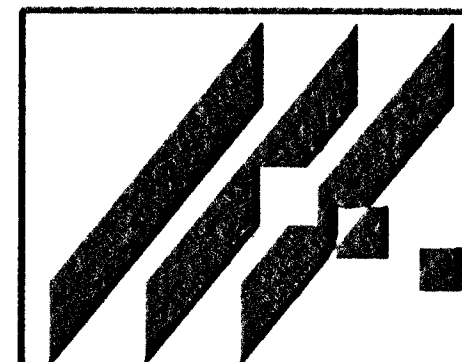

MID-KANSAS ENGINEERING
CONSULTANTS, INC.
411 N. WEBB ROAD
WICHITA, KS. 67206
316-684-9600

AREA "K" 3RD. STREET CHANNEL
PROJECT NAME
LANDSCAPE PLAN
SHEET TITLE
TDM, JRS
DESIGN BY: TDM, JRS
DRAWN BY: CHECKED BY:
JUNE 96 9331_B6 48/77
DATE JOB NO. SHEET/OF