


BENCHMARKS:

BM #3 - "□" Cut on South Edge of Concrete Entrance to Lift Station, 0.5'± East of East Edge of Manhole Adjacent to Northwest Corner of Lot 1, Block 5 in the Hickory Creek Addition.
Elev. = 1343.00 (MSL Datum)

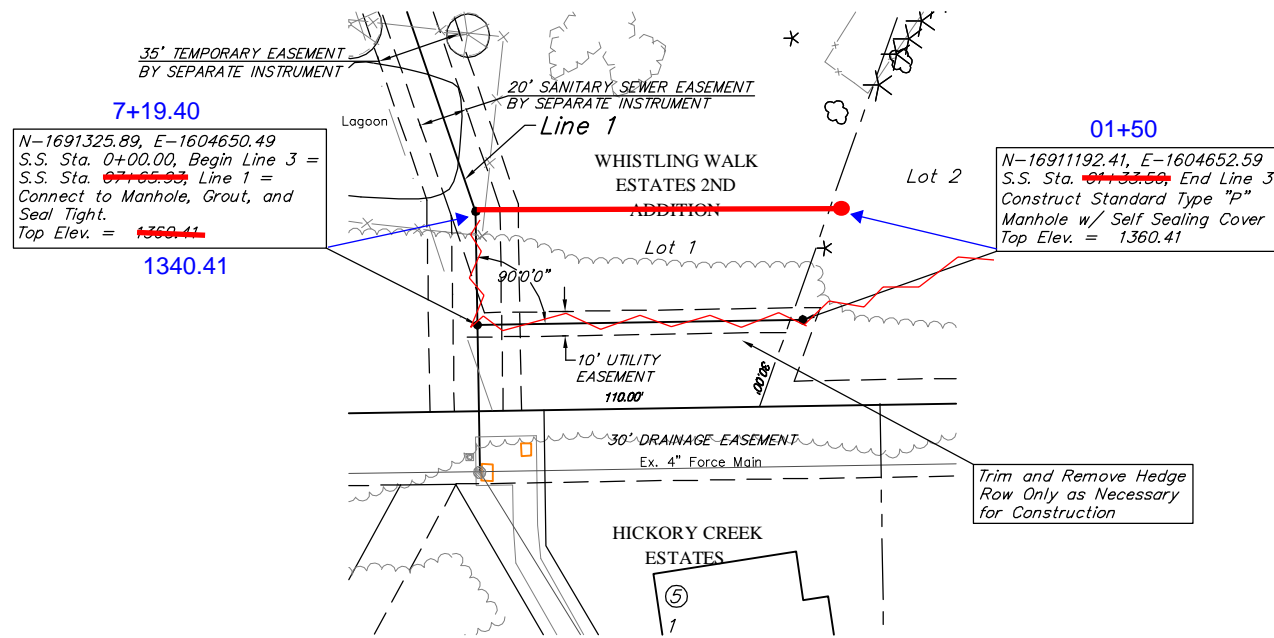

SCALE:
1" = 40' HORIZONTAL
1" = 5' VERTICAL



BENCHMARKS:

BM #3 - "□" Cut on South Edge of Concrete Entrance to Lift Station, 0.5'± East of East Edge of Manhole Adjacent to Northwest Corner of Lot 1, Block 5 in the Hickory Creek Addition.
Elev. = 1343.00 (MSL Datum)



SCALE:
1" = 40' HORIZONTAL
1" = 5' VERTICAL

