Revised Plan
Intersection
Alt for
Vassar-Ave
1961

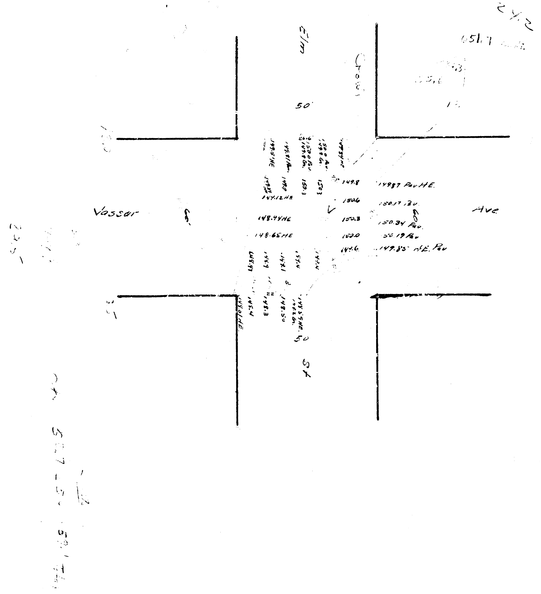
Vassar
Ave
50'
C/L
Curb
Curb
