


Pine- Intersection of Stackman

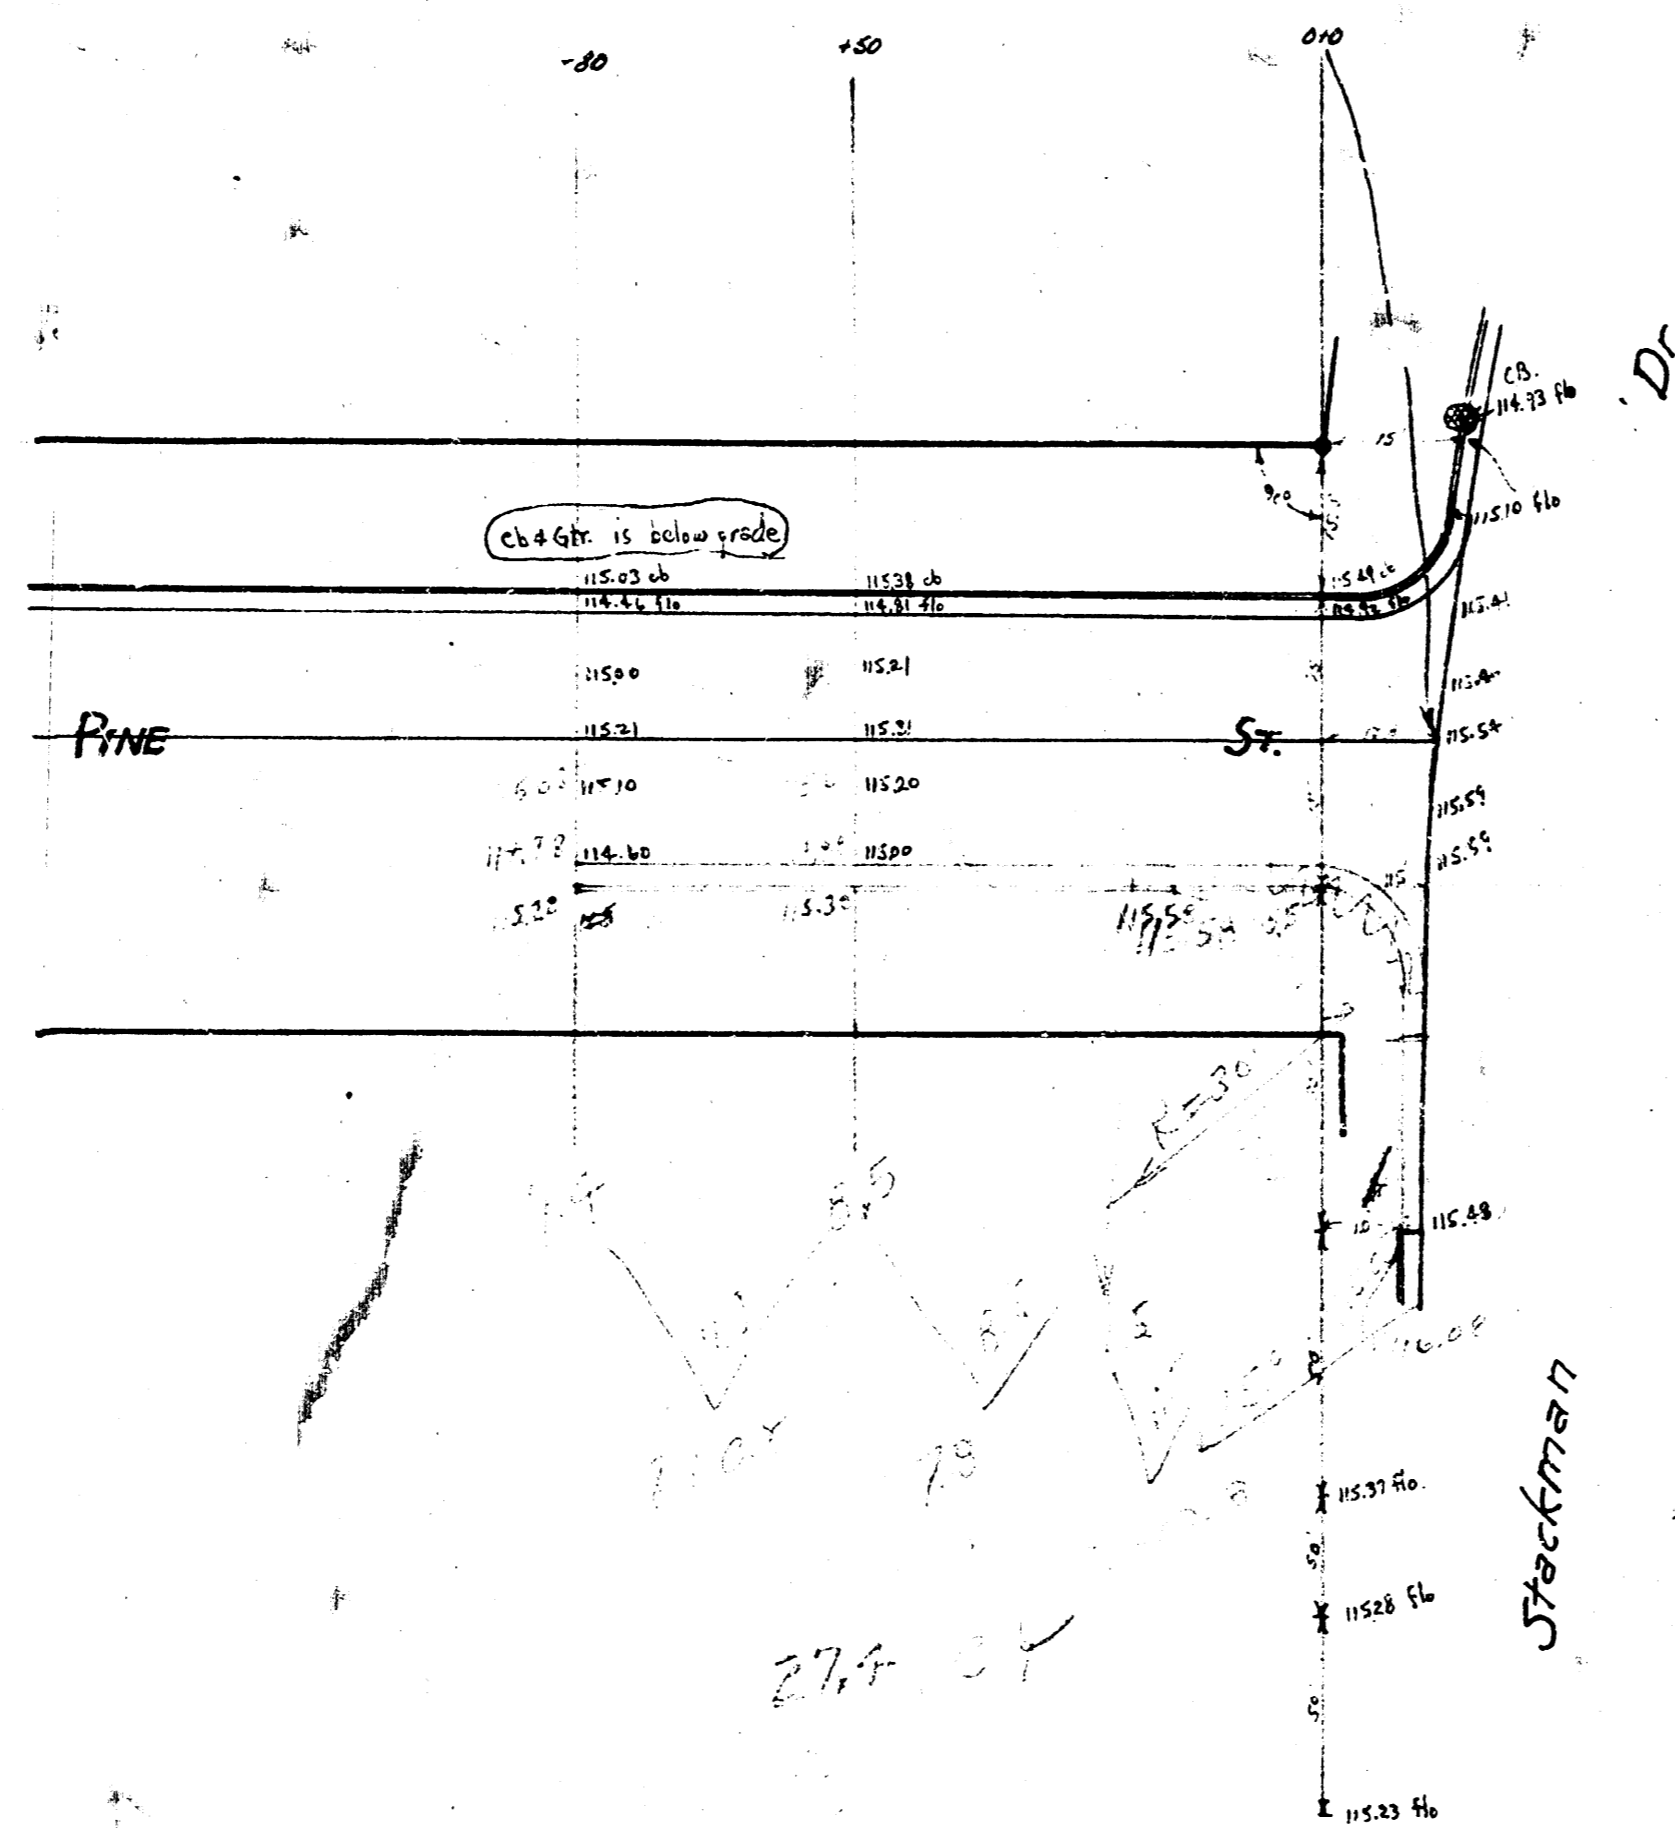

B.M. Elev. 115.70 'X' on walk @ curb NW cor Stackman Dr. & Pine