



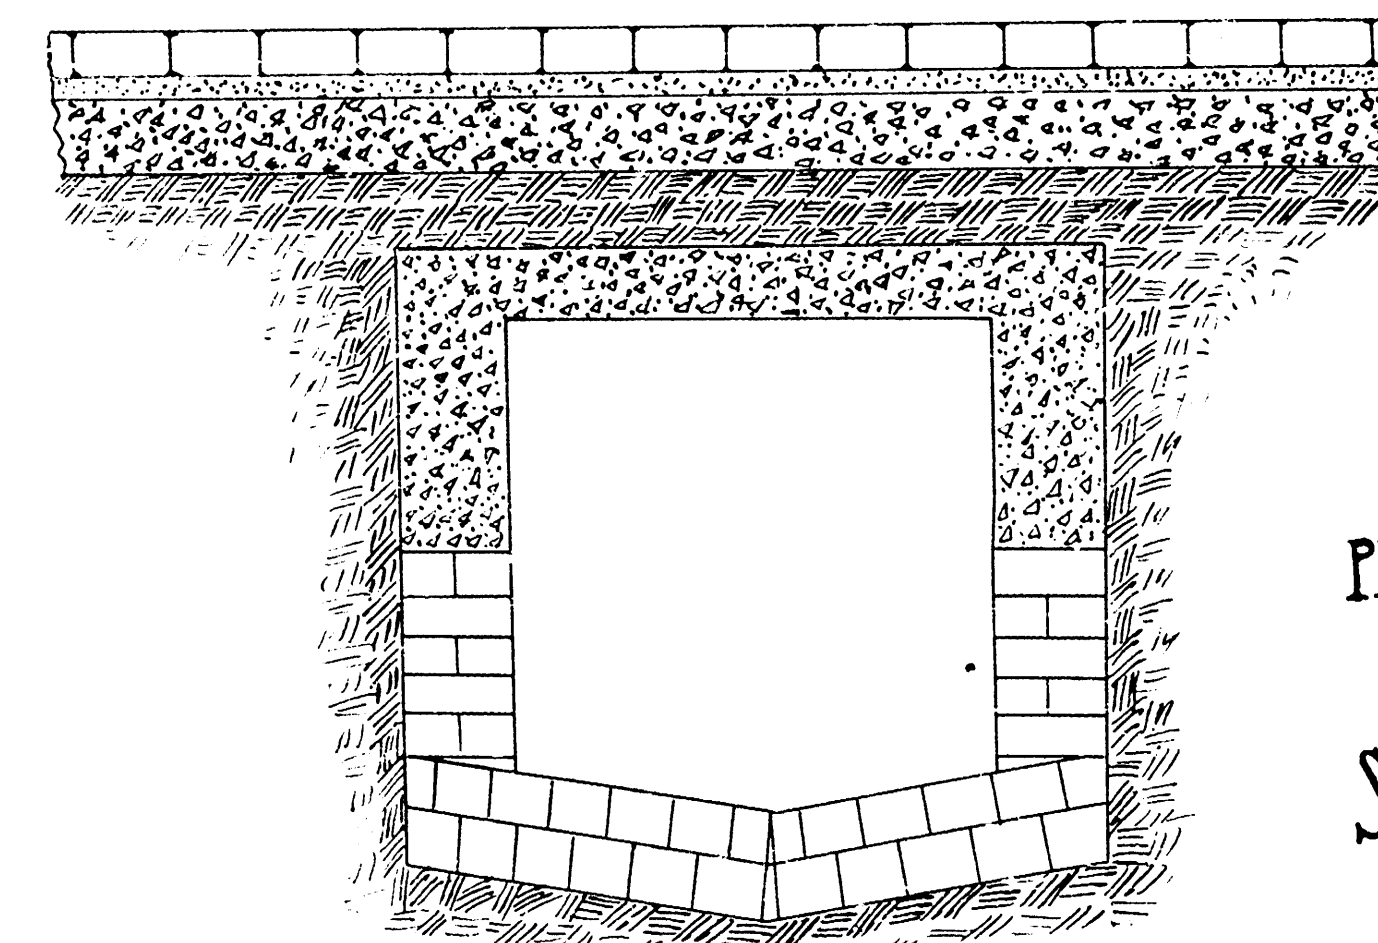


CROSS SECTION
BETWEEN TRACKS


PROPOSED CHANGE
OF
STORM SEWER
AT
MOSLEY & FIRST

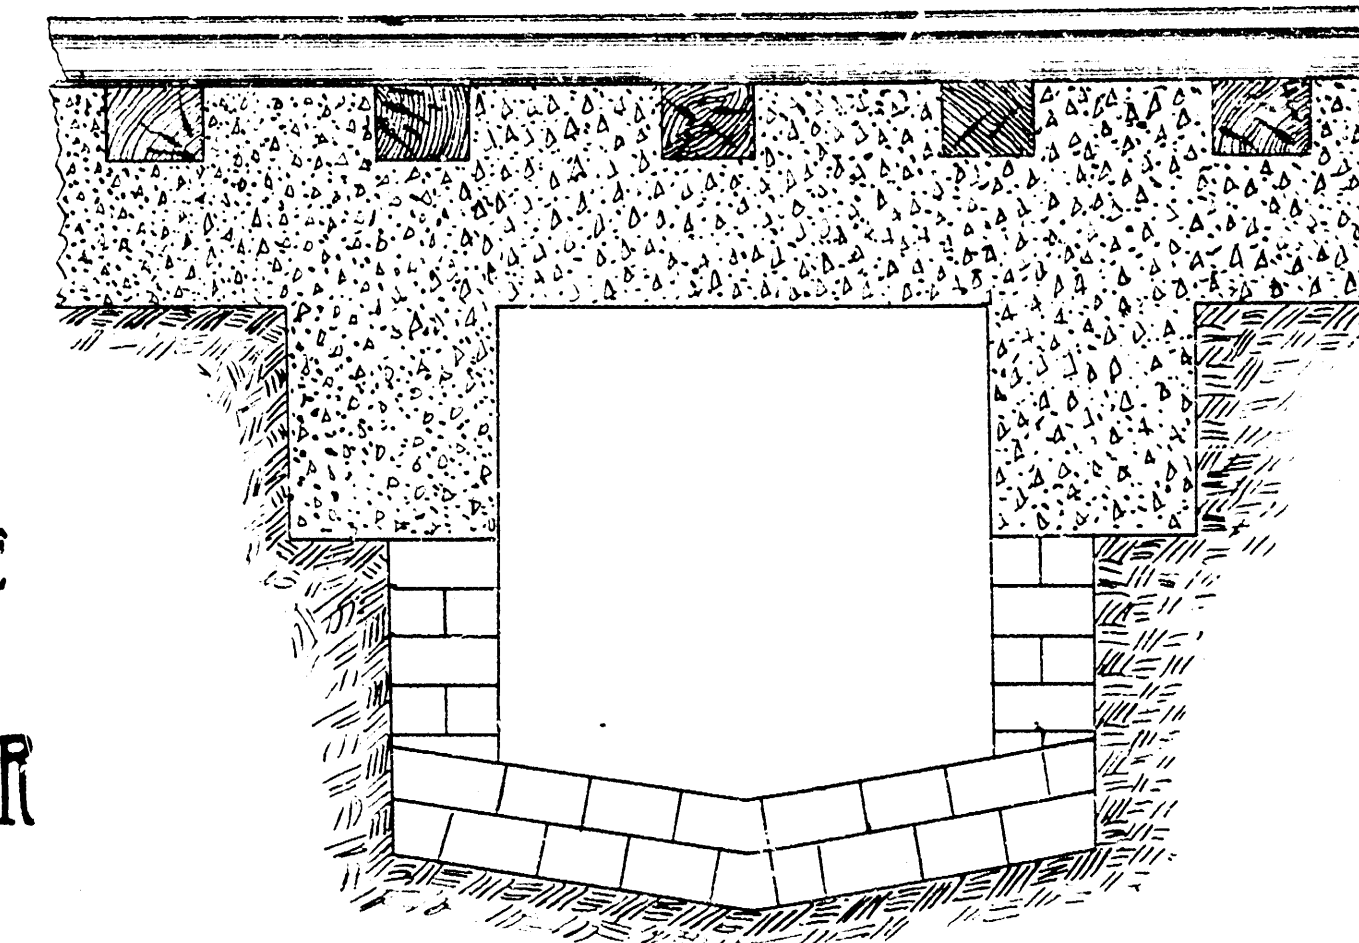

CROSS SECTION
UNDER TRACKS

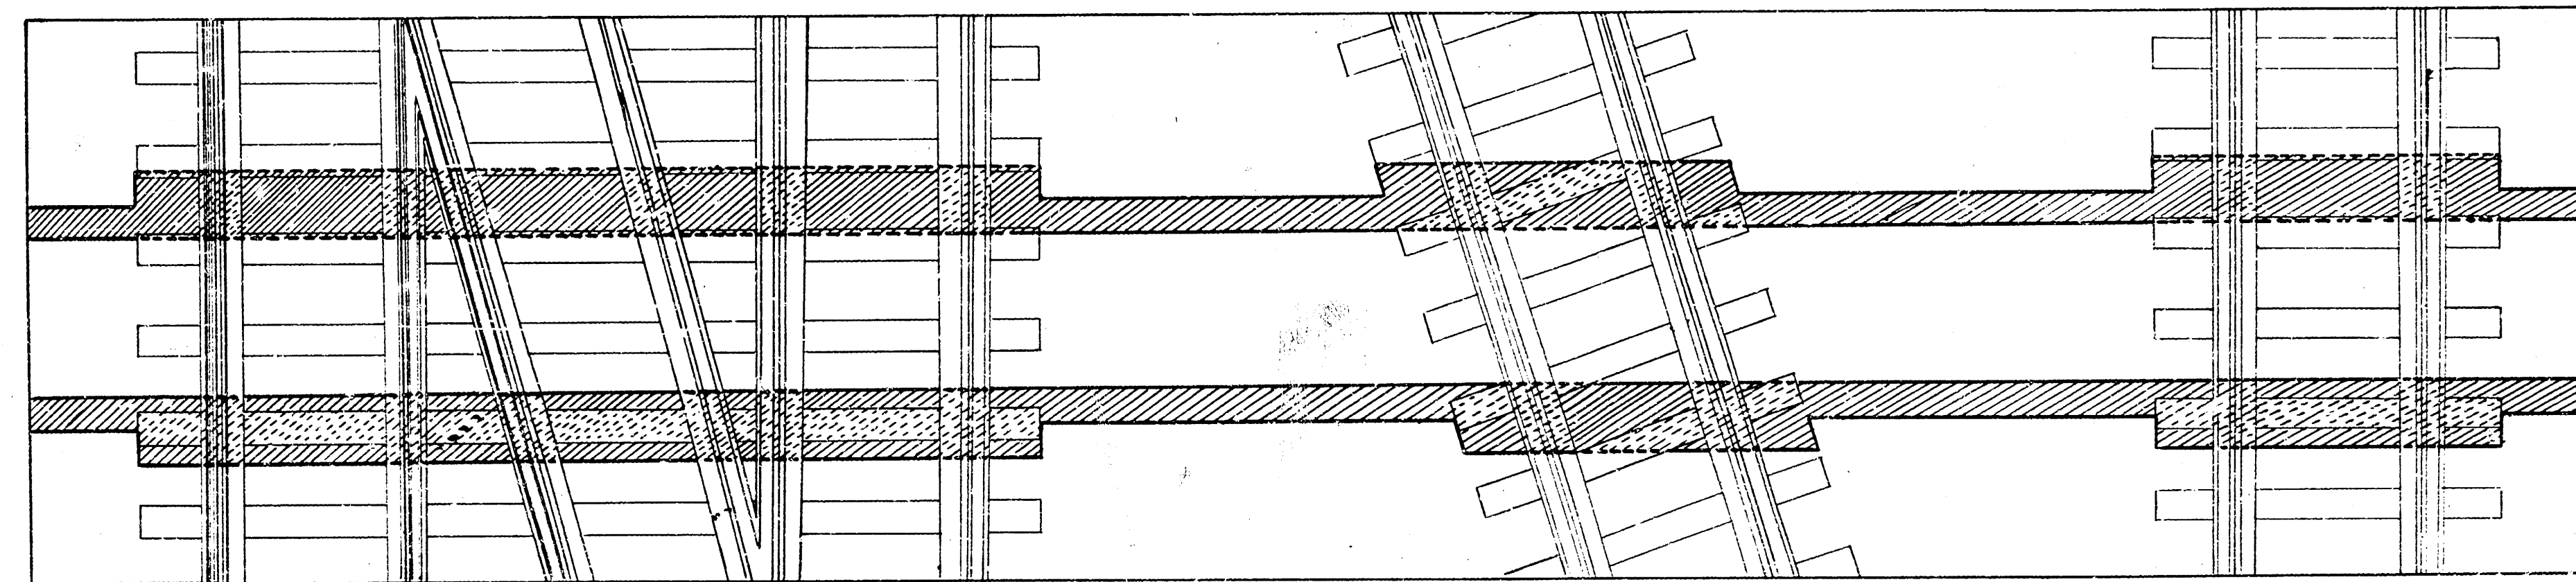

PLAN

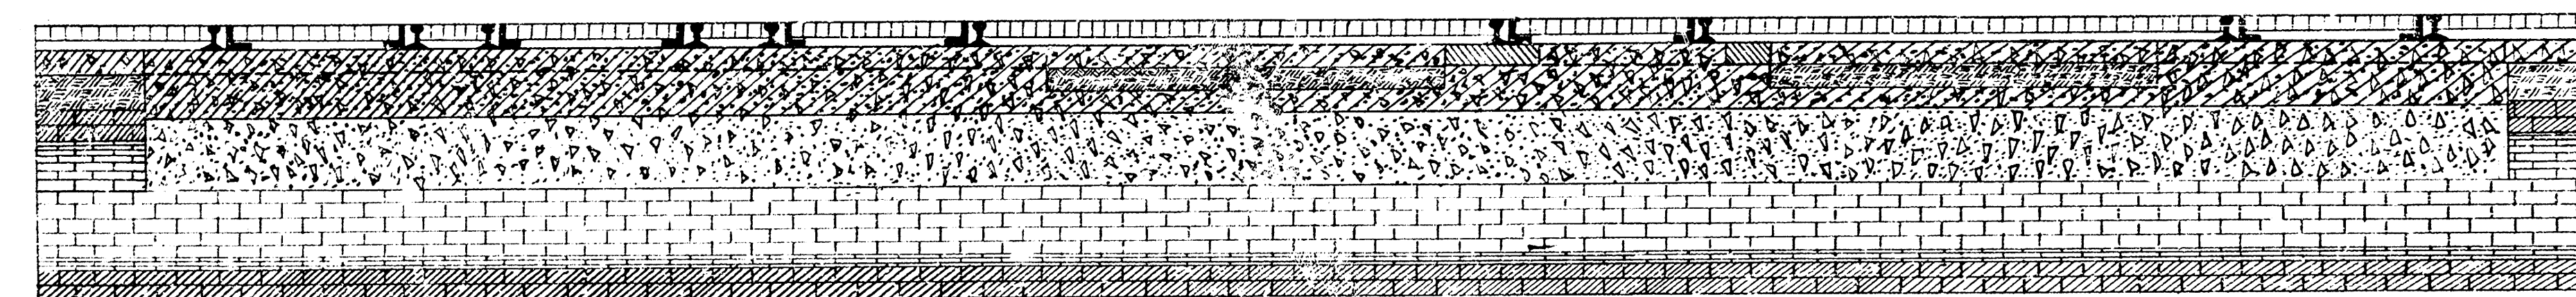

ELEVATION

