


STORM WATER SEWER NO. 104

CHERRY CREEK HILLS

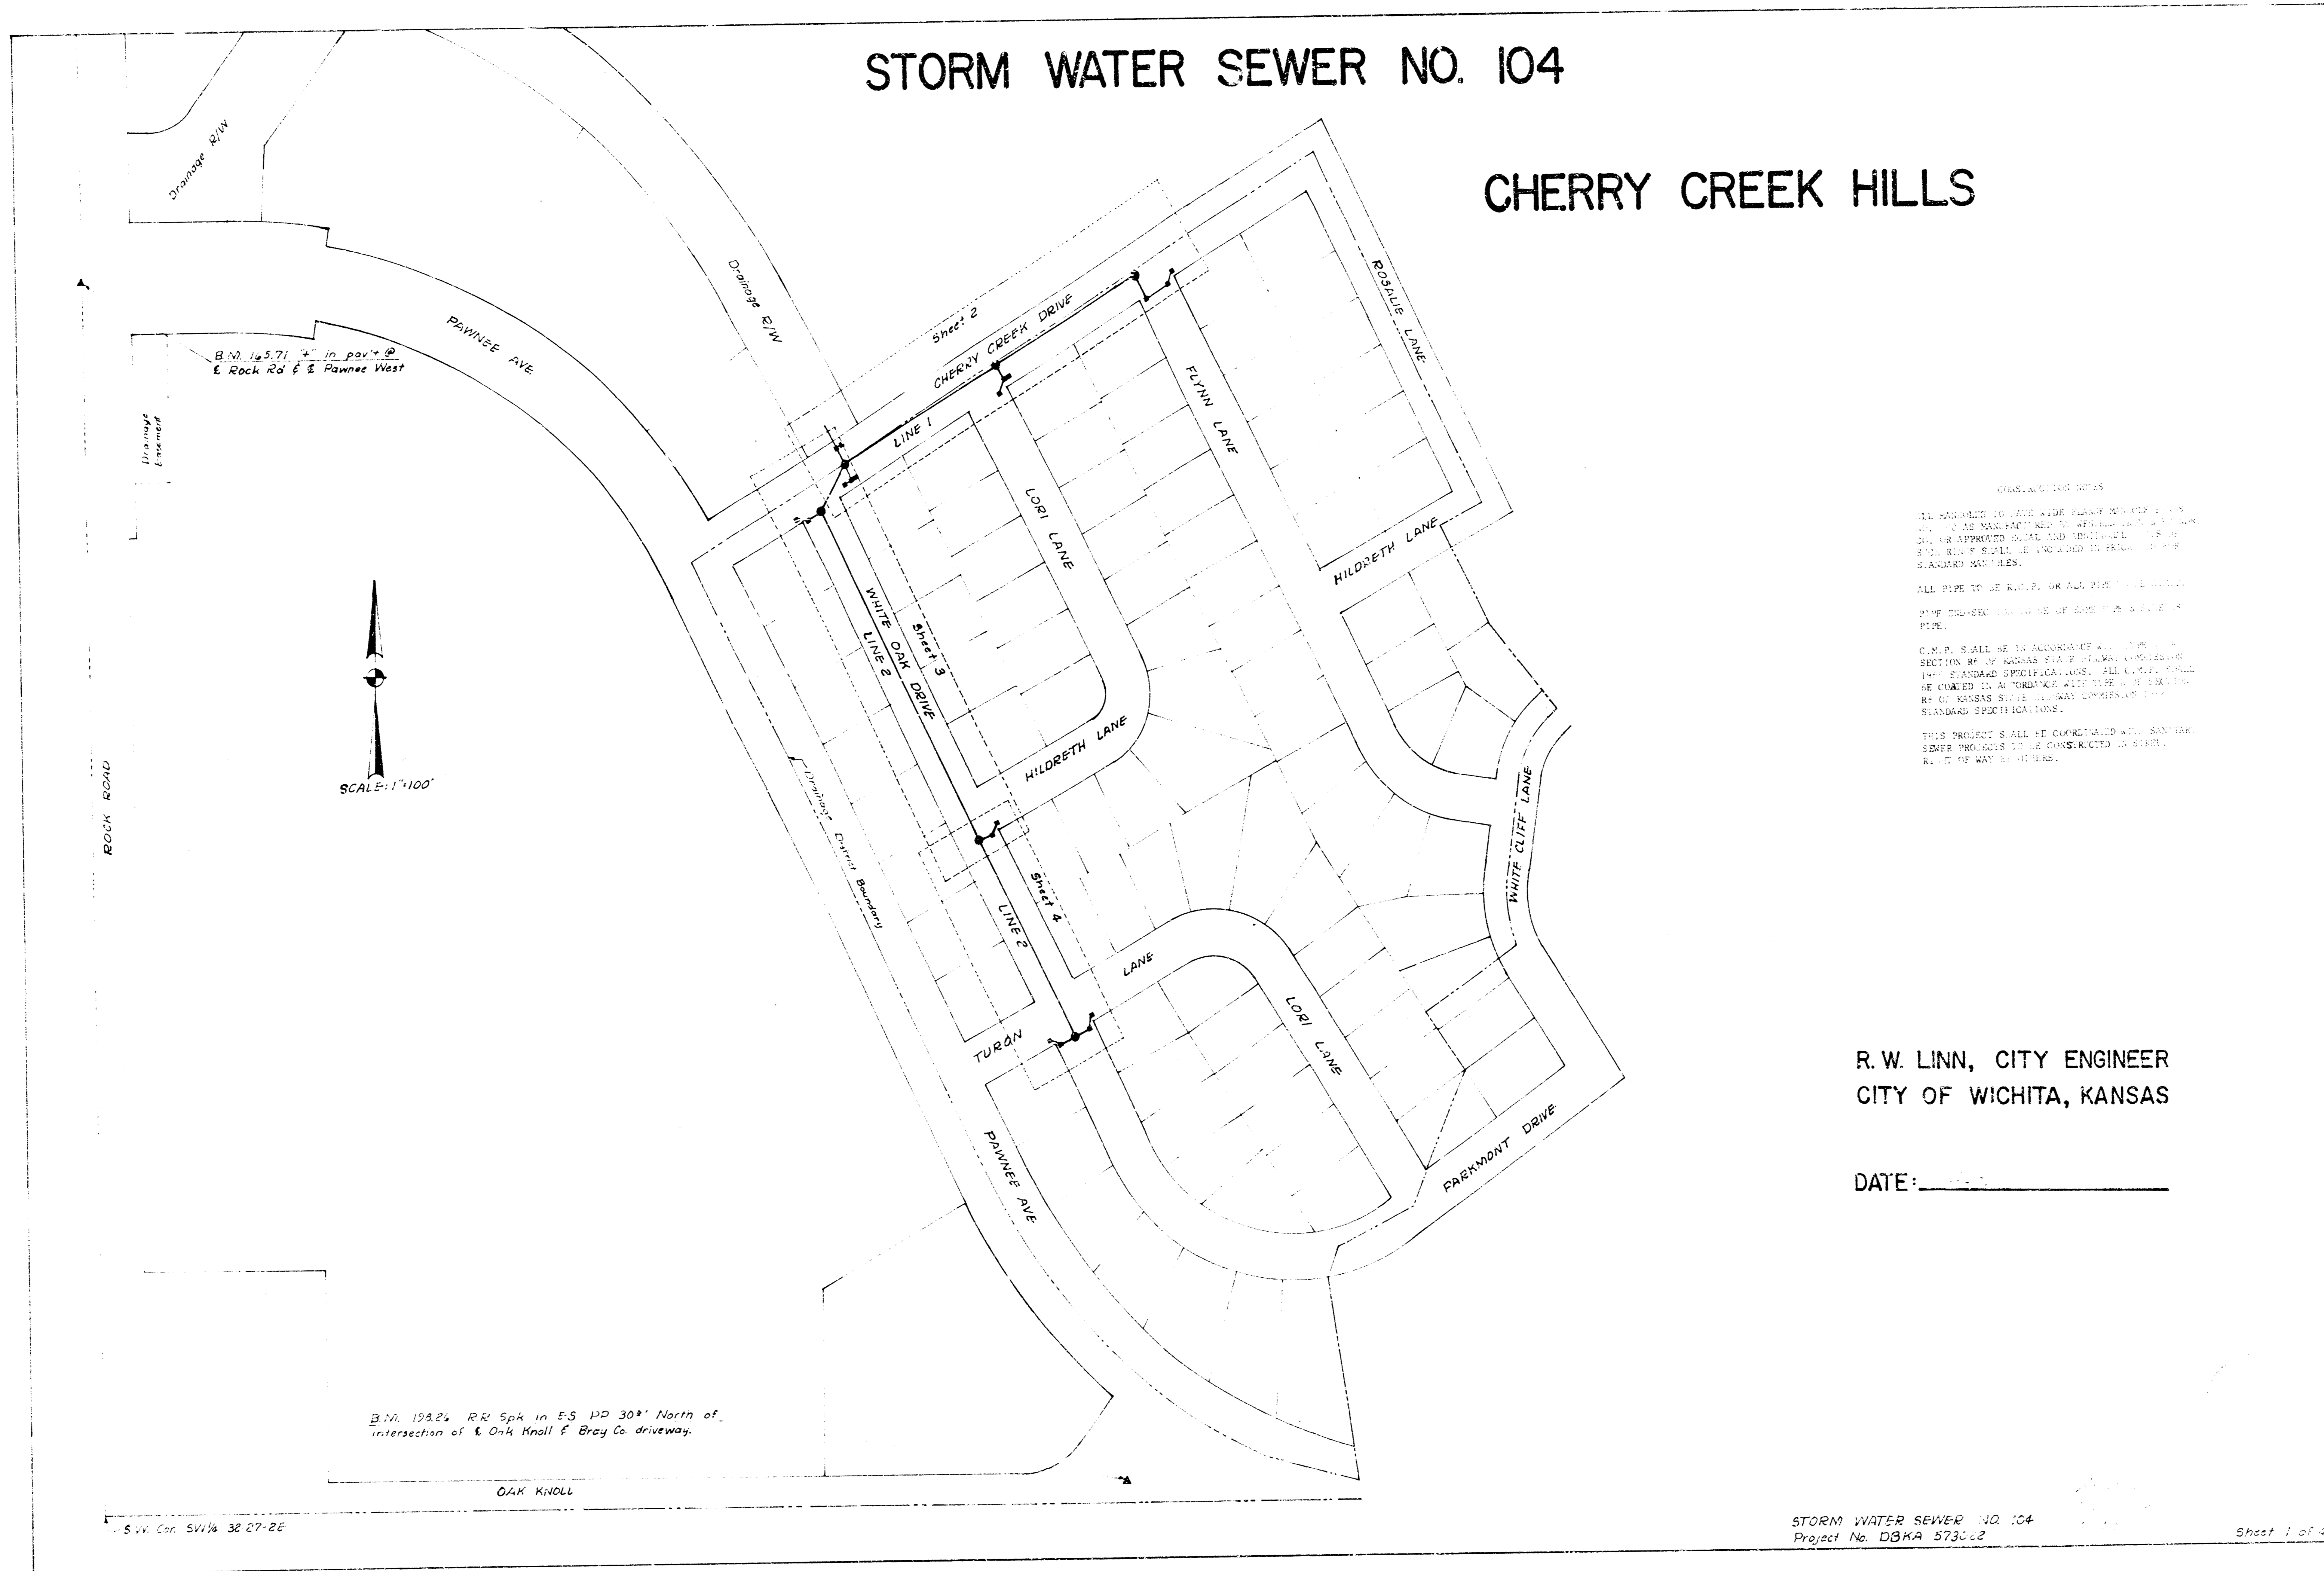

CONSTRUCTION NOTES






R. W. LINN, CITY ENGINEER
CITY OF WICHITA, KANSAS

DATE: _____

B.N. See Sheet 1

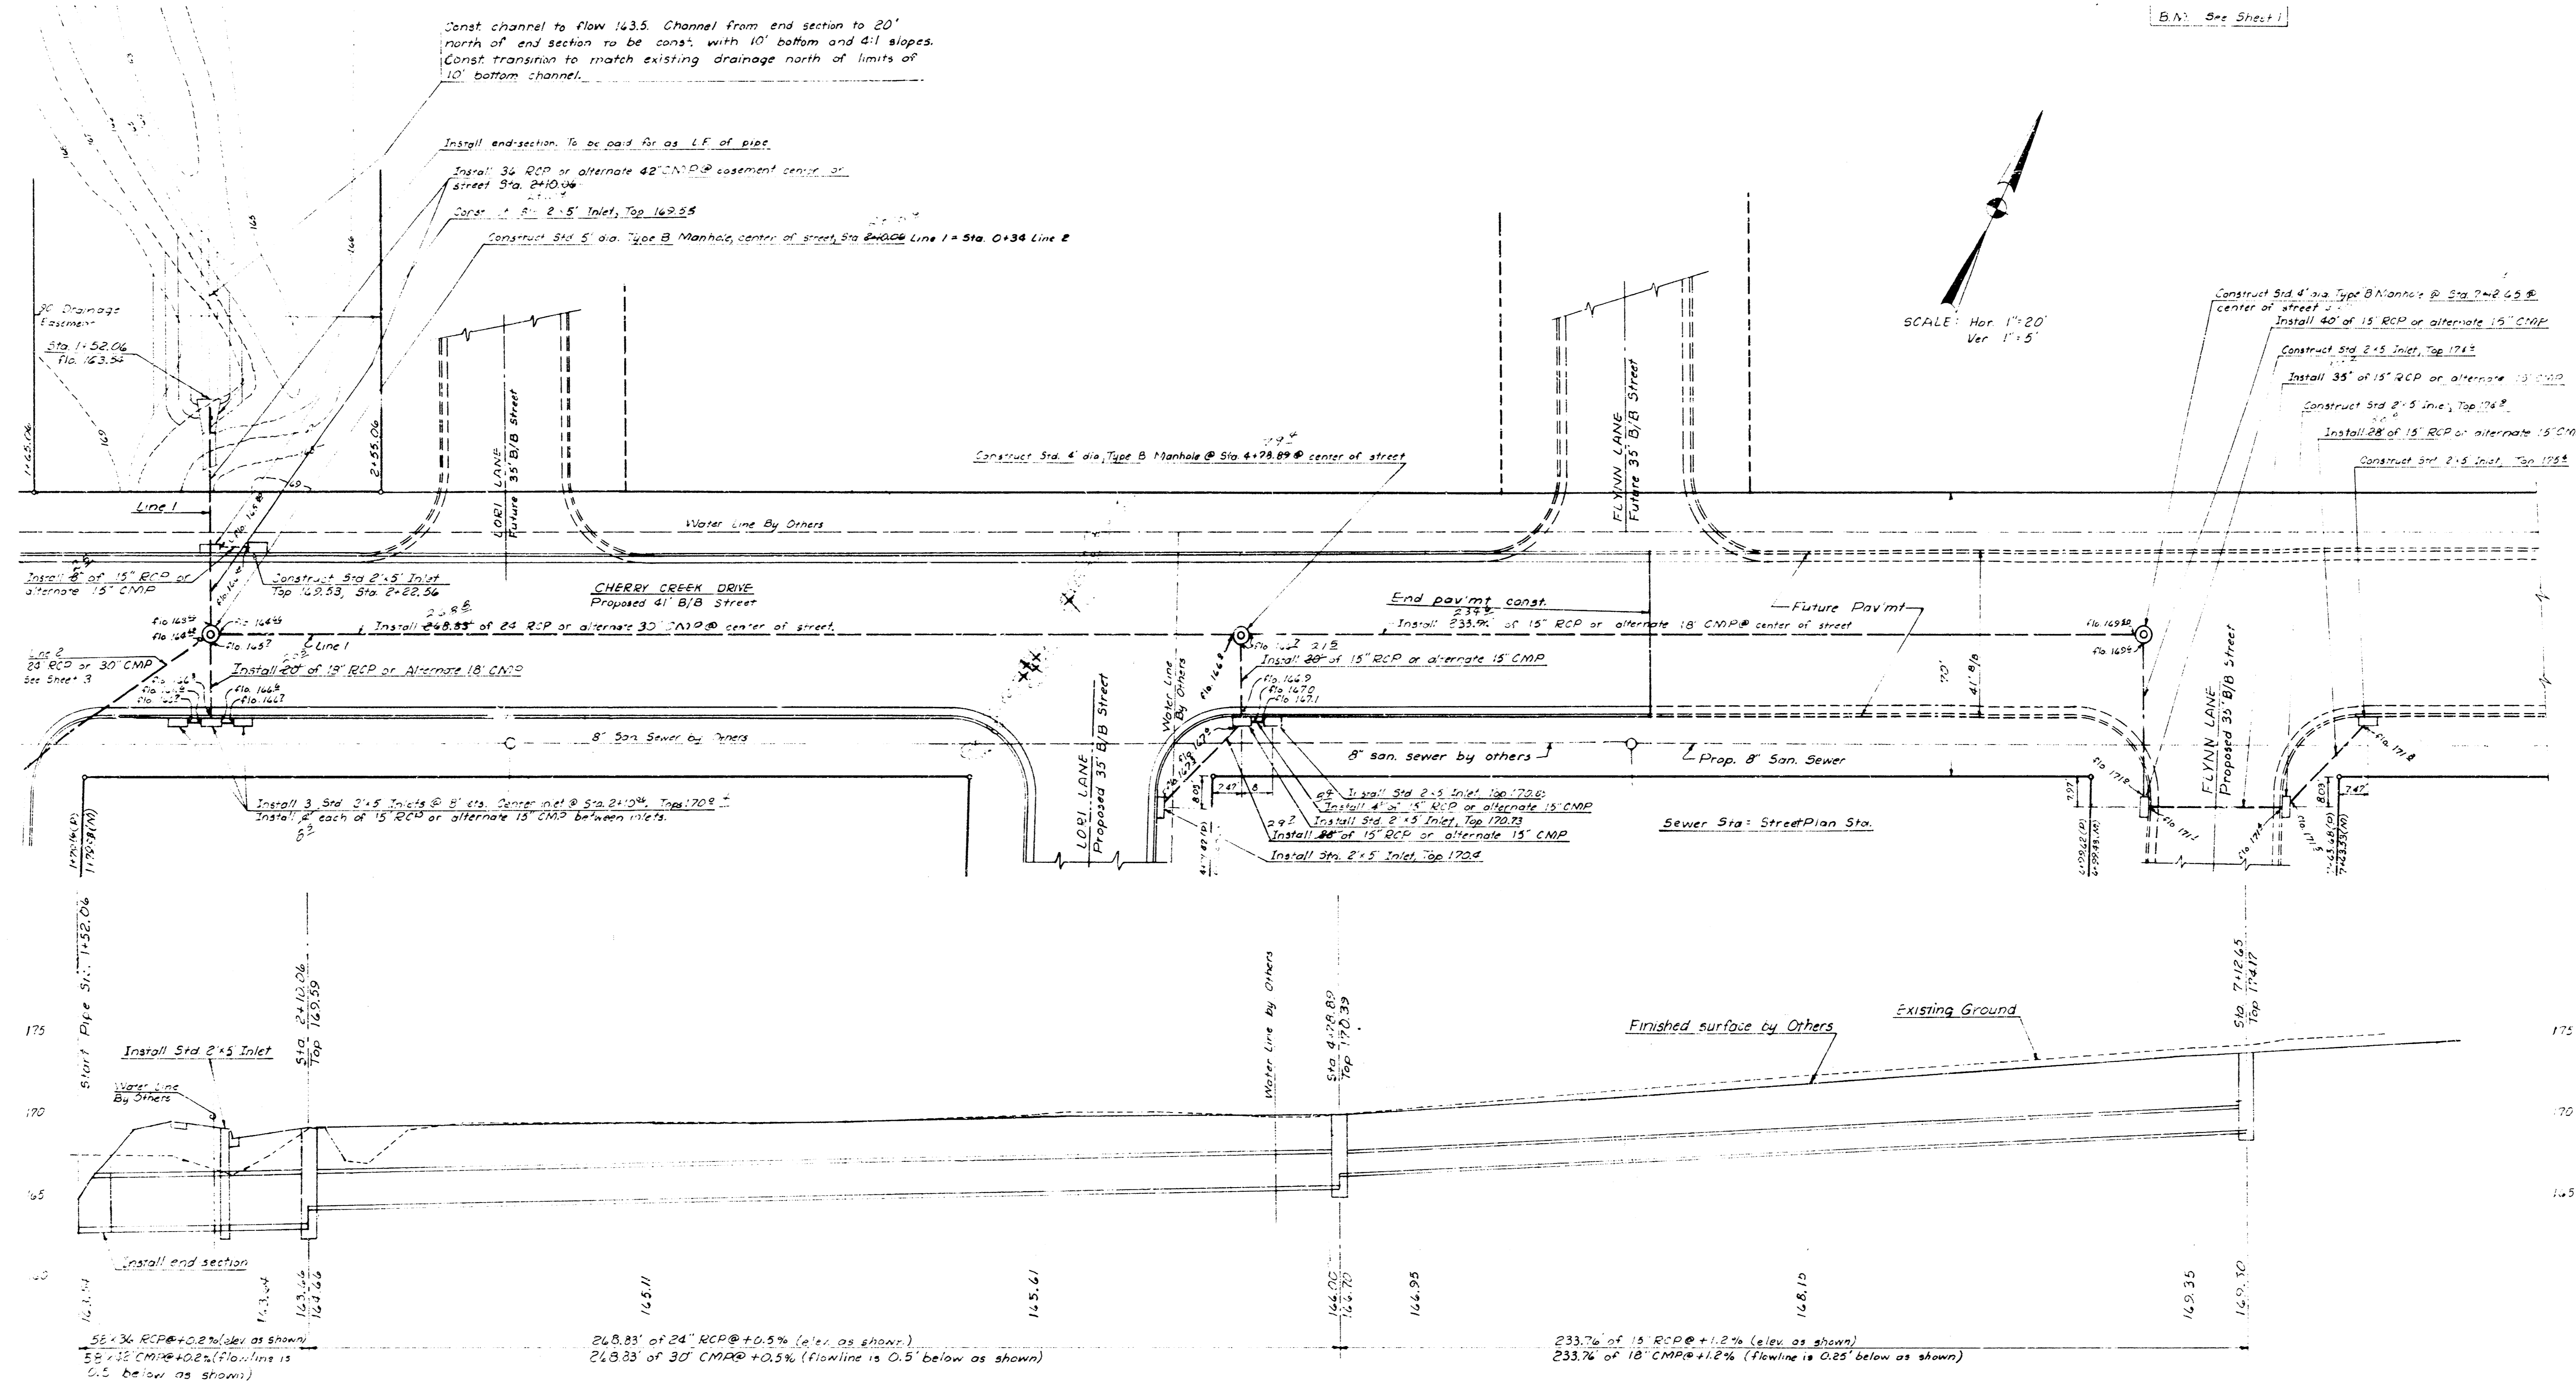

SCALE: Hor 1"=20'
Ver 1"=5'

LINE 1

2

3

4



5

6


7

STORM WATER SEWER NO. 104
Project No. DAKA 573022

Sheet 2 of 4

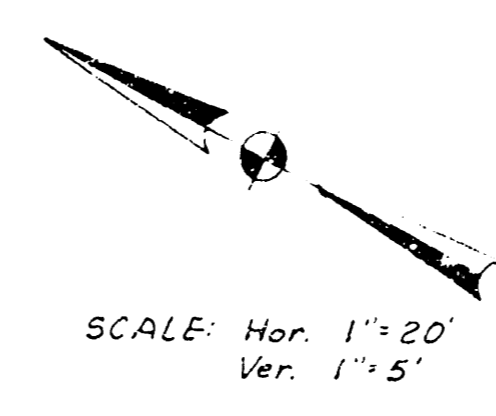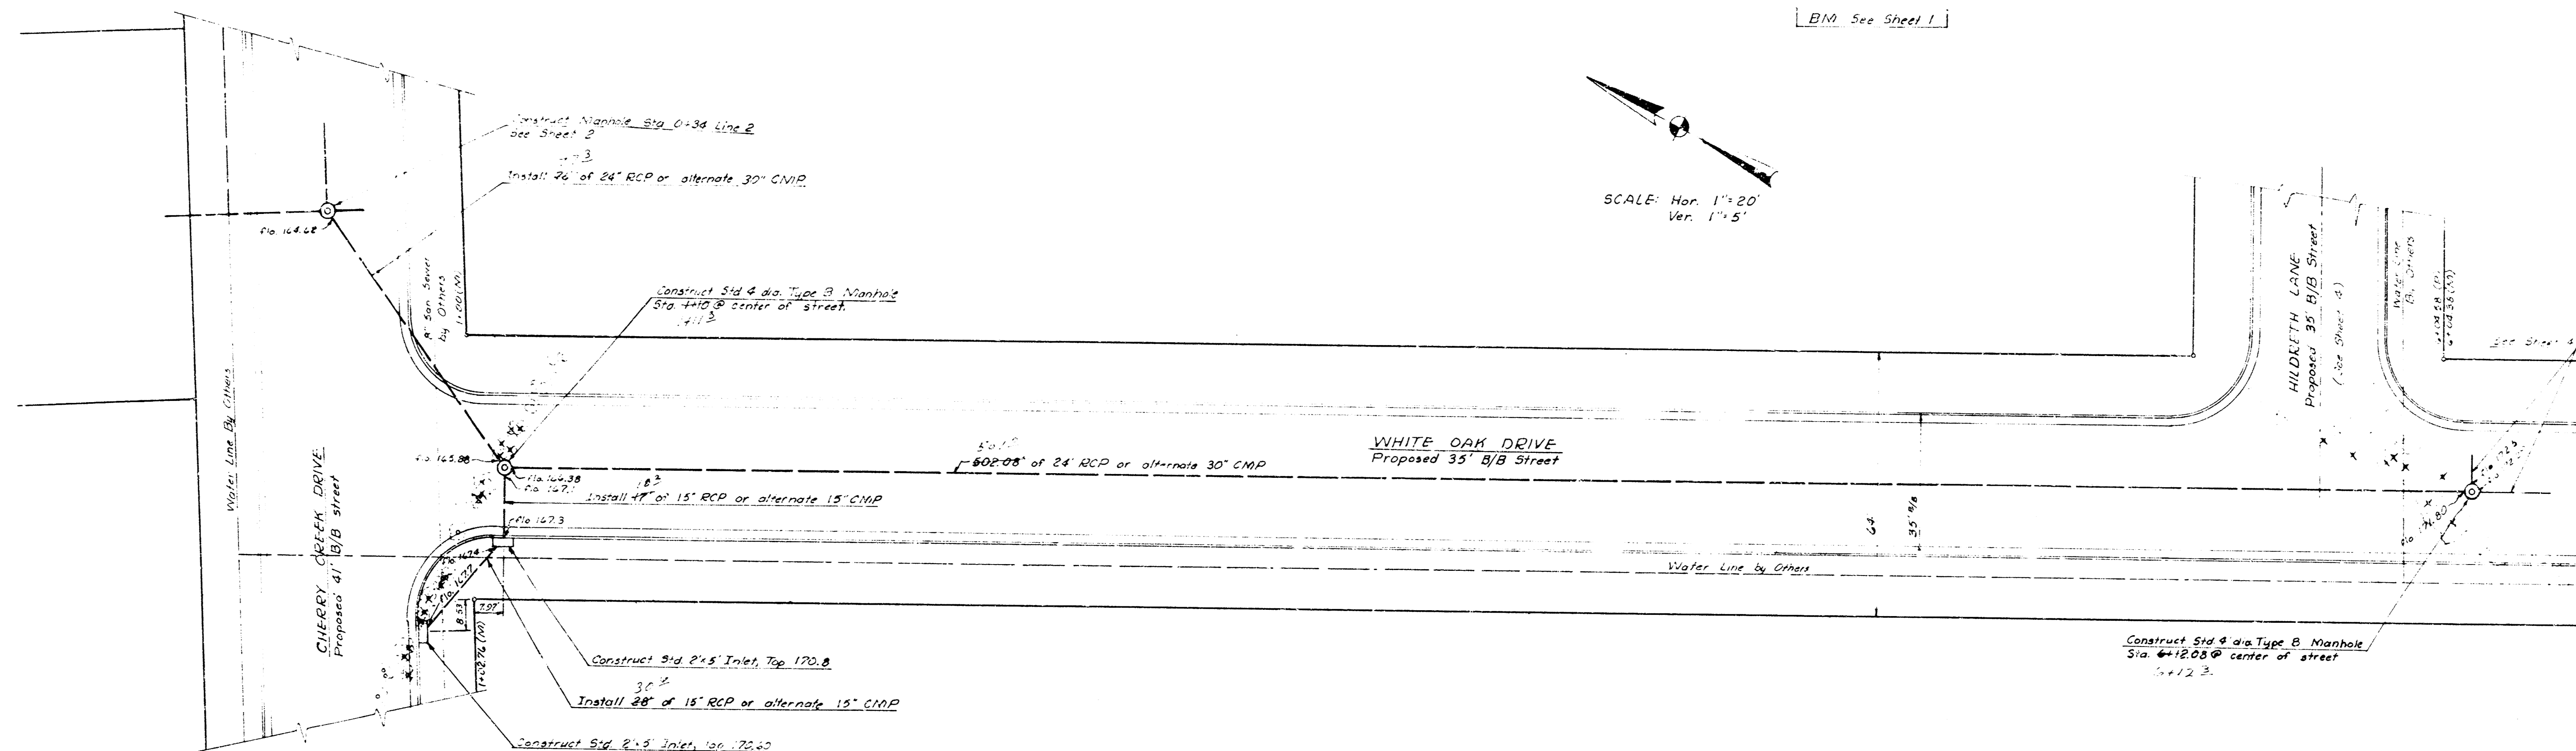


Sewer Sta = Street Plan Sta + 100'

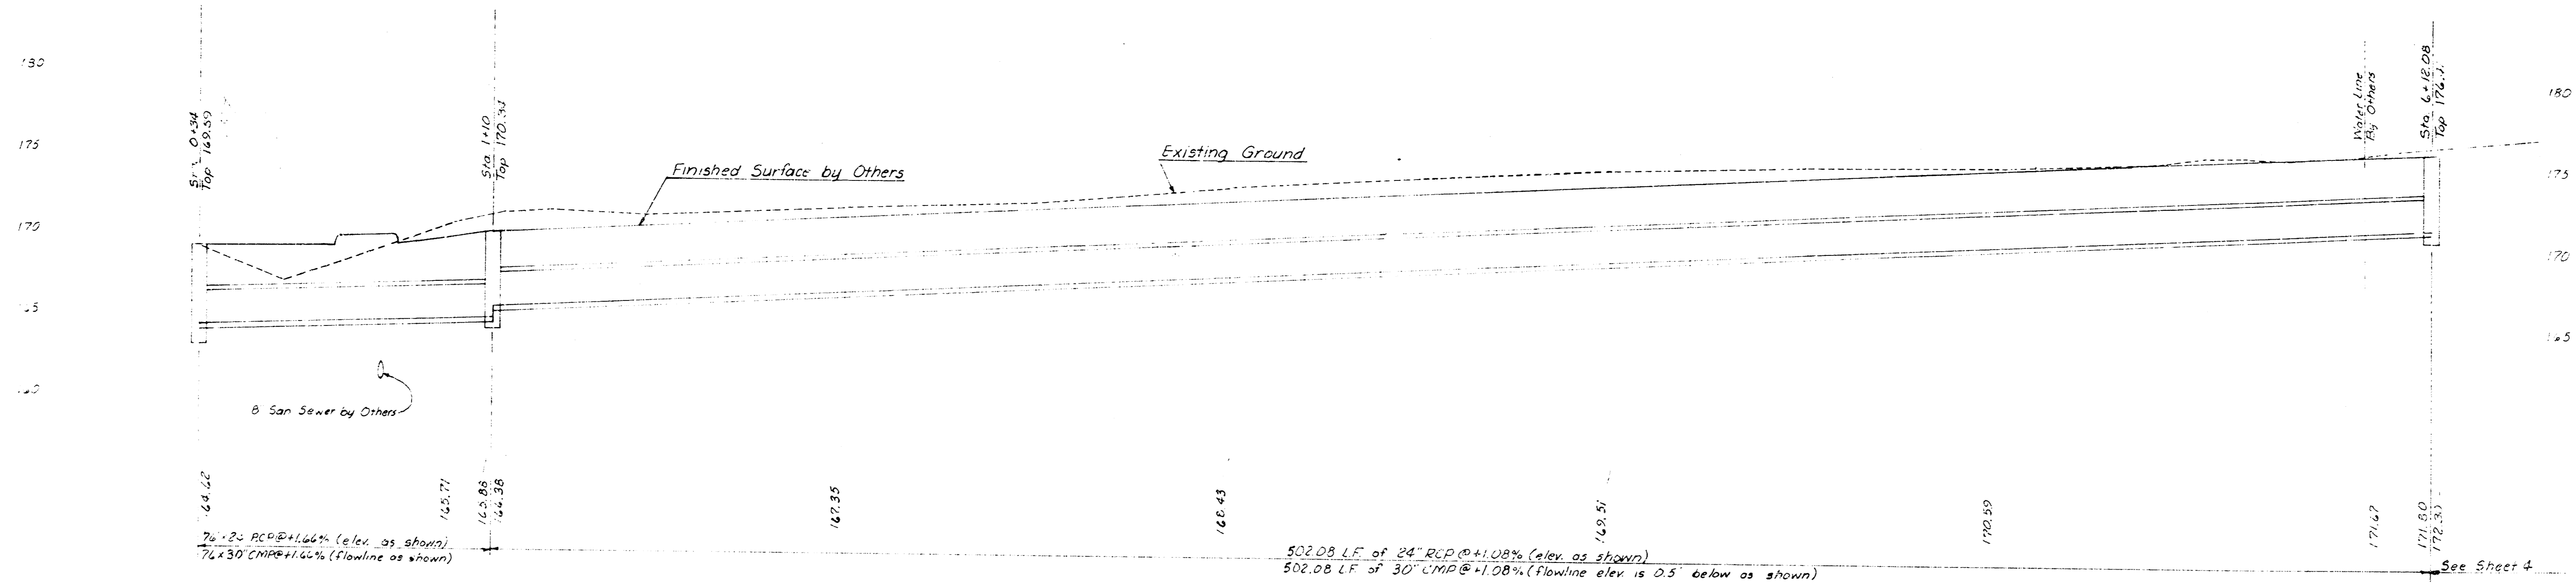

LINE 2

B.M. See Sheet 1

SCALE: Hor. 1"=20'
Ver. 1"=5'

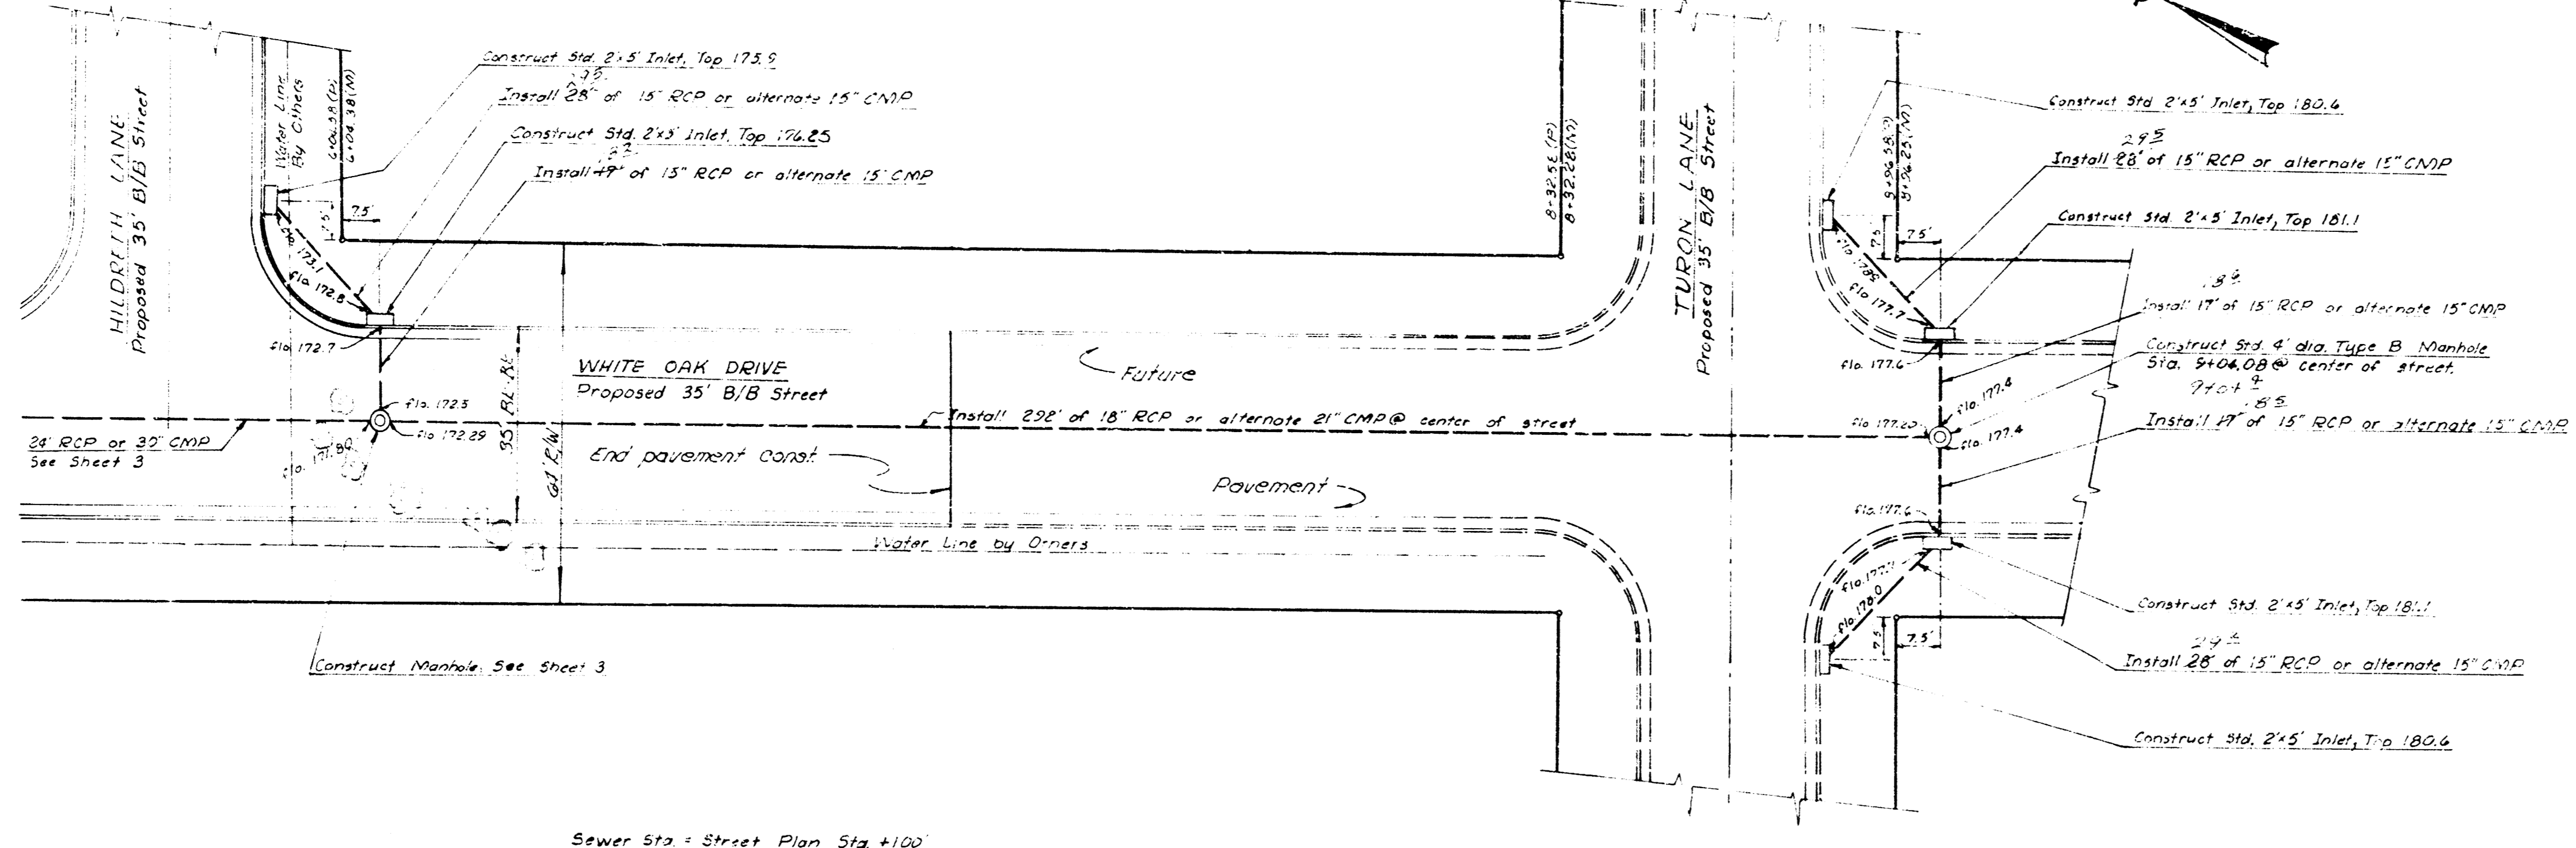

Sewer Sta. + Street Plan Sta +100

