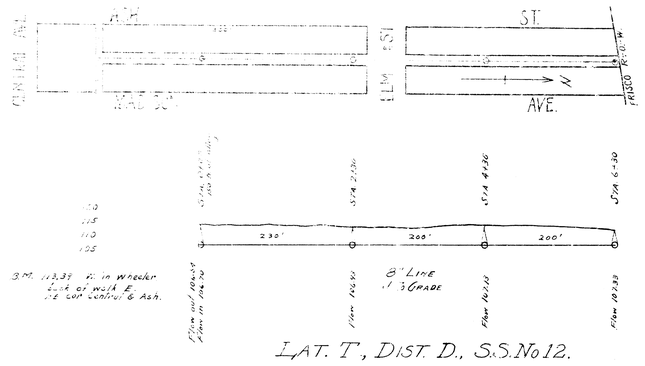

LAT. T, DIST. D., S.S. No 12.

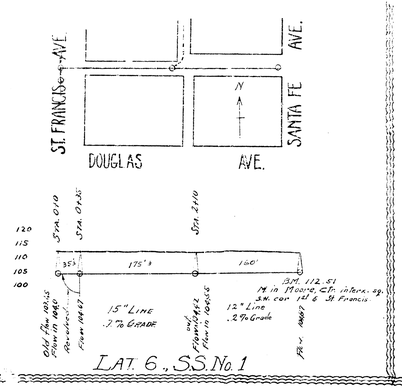

LAT. 6., S.S. No. 1

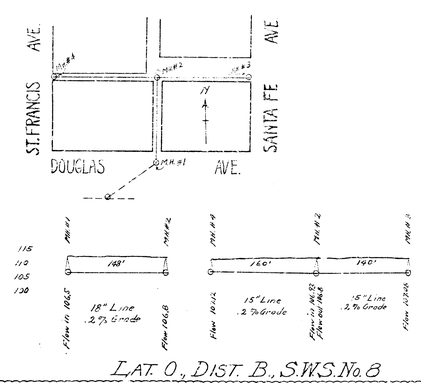

LAT. O, DIST. B., S.W.S. No. 8

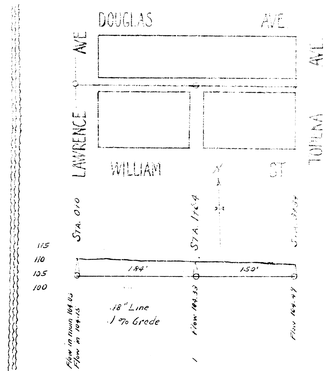

LAT. P., DIST. B.,

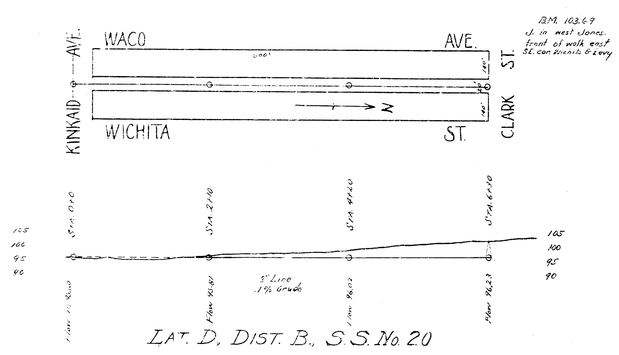

LAT. D. DIST. B., S.S. No. 20

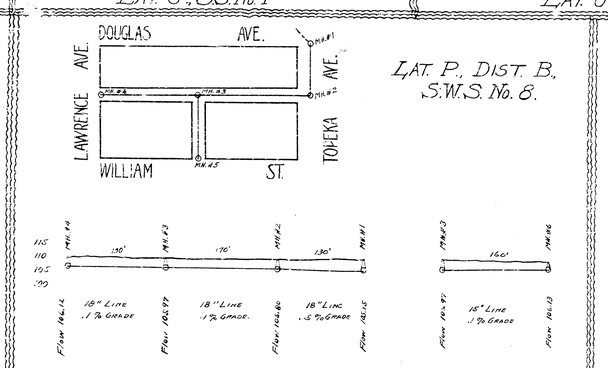

LAT. P., DIST. B.,
S.W.S. No. 8.