Laclede Ave- N.L. University to S.L. Maple.

C. & G. Replacement.

B.M. Iron in thim. S.S. Maple St + C. Laclede, 108.30

B.M. " " " N.S. Laclede. + C. University, 107.35
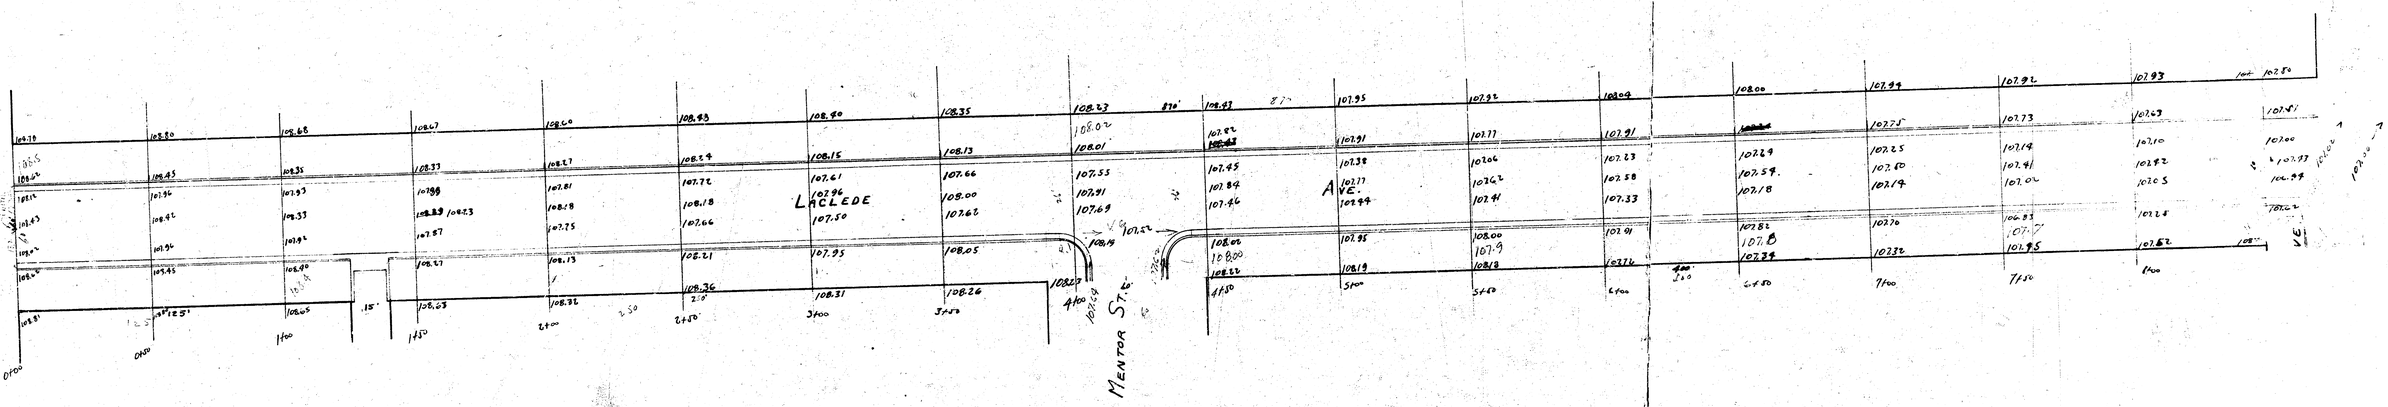
N