



P.C.S.	C.D.
437	11.8
473	11.2
150	21.6
93.0	24.7
82.9	11.7
18.6	18.1
416.1	71.7
10.1	119.9
4577	

Survey 1/20
Plan 100'
Checked
B.E. SMITH

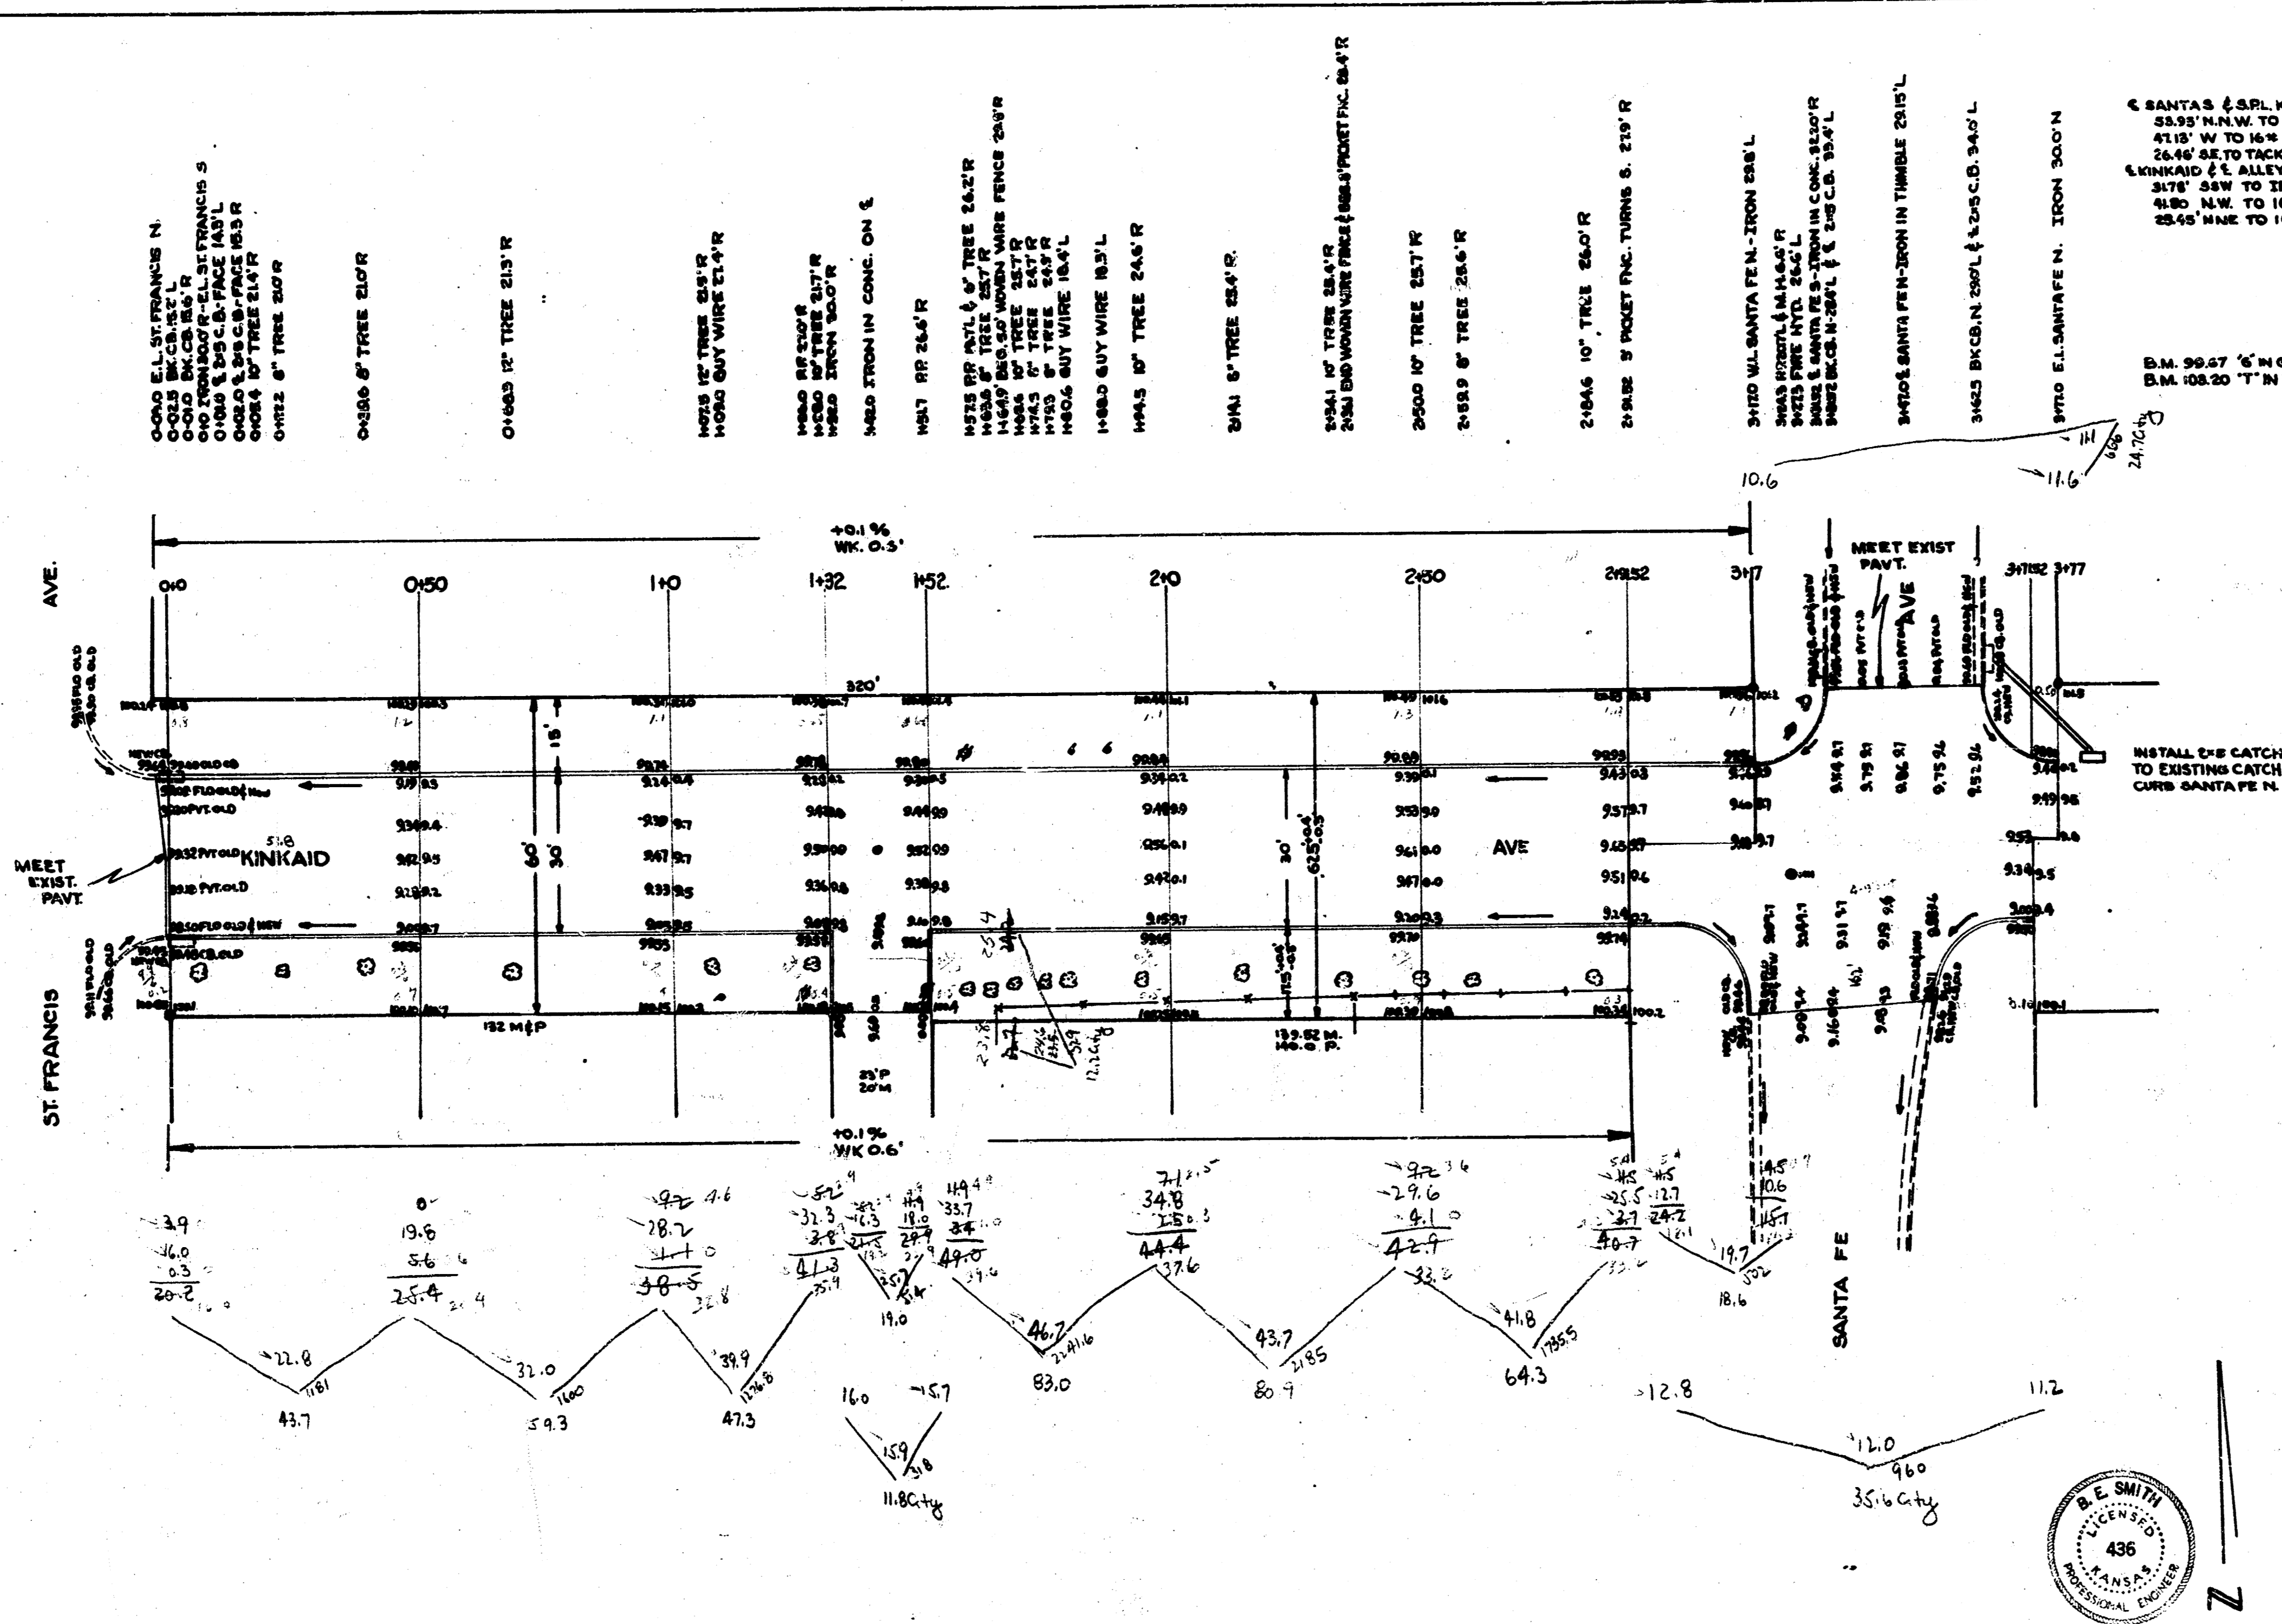


TIES TO IRONS
 C. SANTA FE & S.P.L. KINKAID -
 53.95' N.W. TO 16" SPIKE E.S. PP.

 B.M. 108.20 "T" IN TROY FIRE HYD. NW COR. SANTA FE & KINKAID

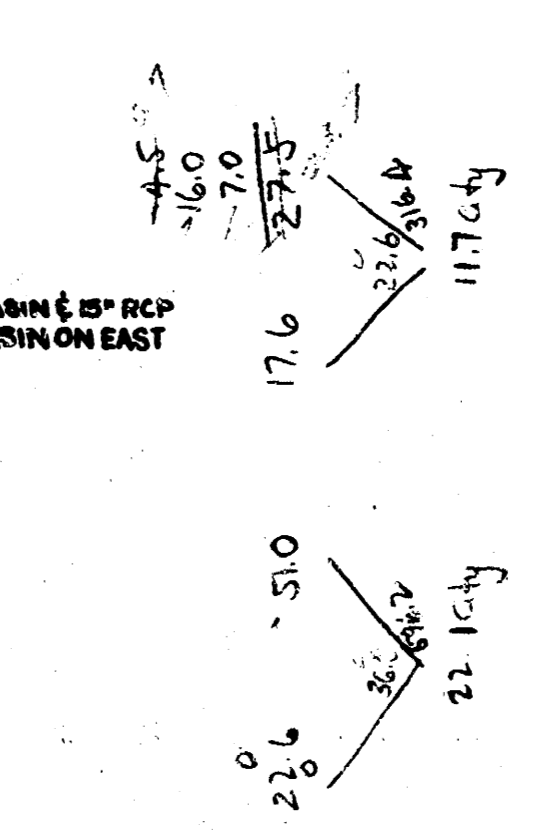

KINKAID AVE.
 E.L. ST. FRANCIS TO E.L. SANTA FE
 30' CONC. & C.B.

CITY OF WICHITA, KANSAS
 B.E. SMITH CITY ENGINEER
 APRIL 1953 PROJ. NO. C-12-239

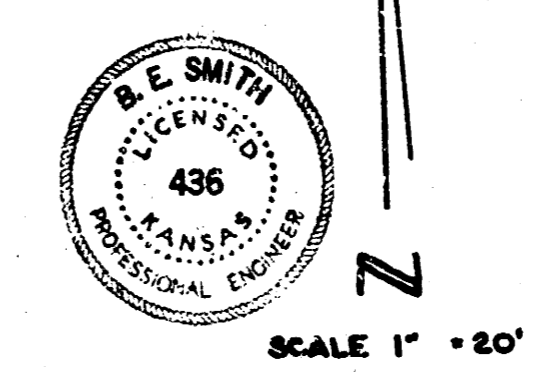

