


NOTE TO FIELD ENGINEER & CONTRACTOR
Grade, parking and clear right-of-way for proposed sidewalk. Compact fill in sidewalk area. TO BE CONSTRUCTED BY "OTHERS".

NOTE: ELEVATIONS SHOWN ON THIS PLAN ARE MEAN SEA LEVEL DATUM. B.M. 1367.58 IS A CORNER POINT OF THE MAINS GATE. 130' FROM THE MAINS GATE. CITY DATUM: 179.95

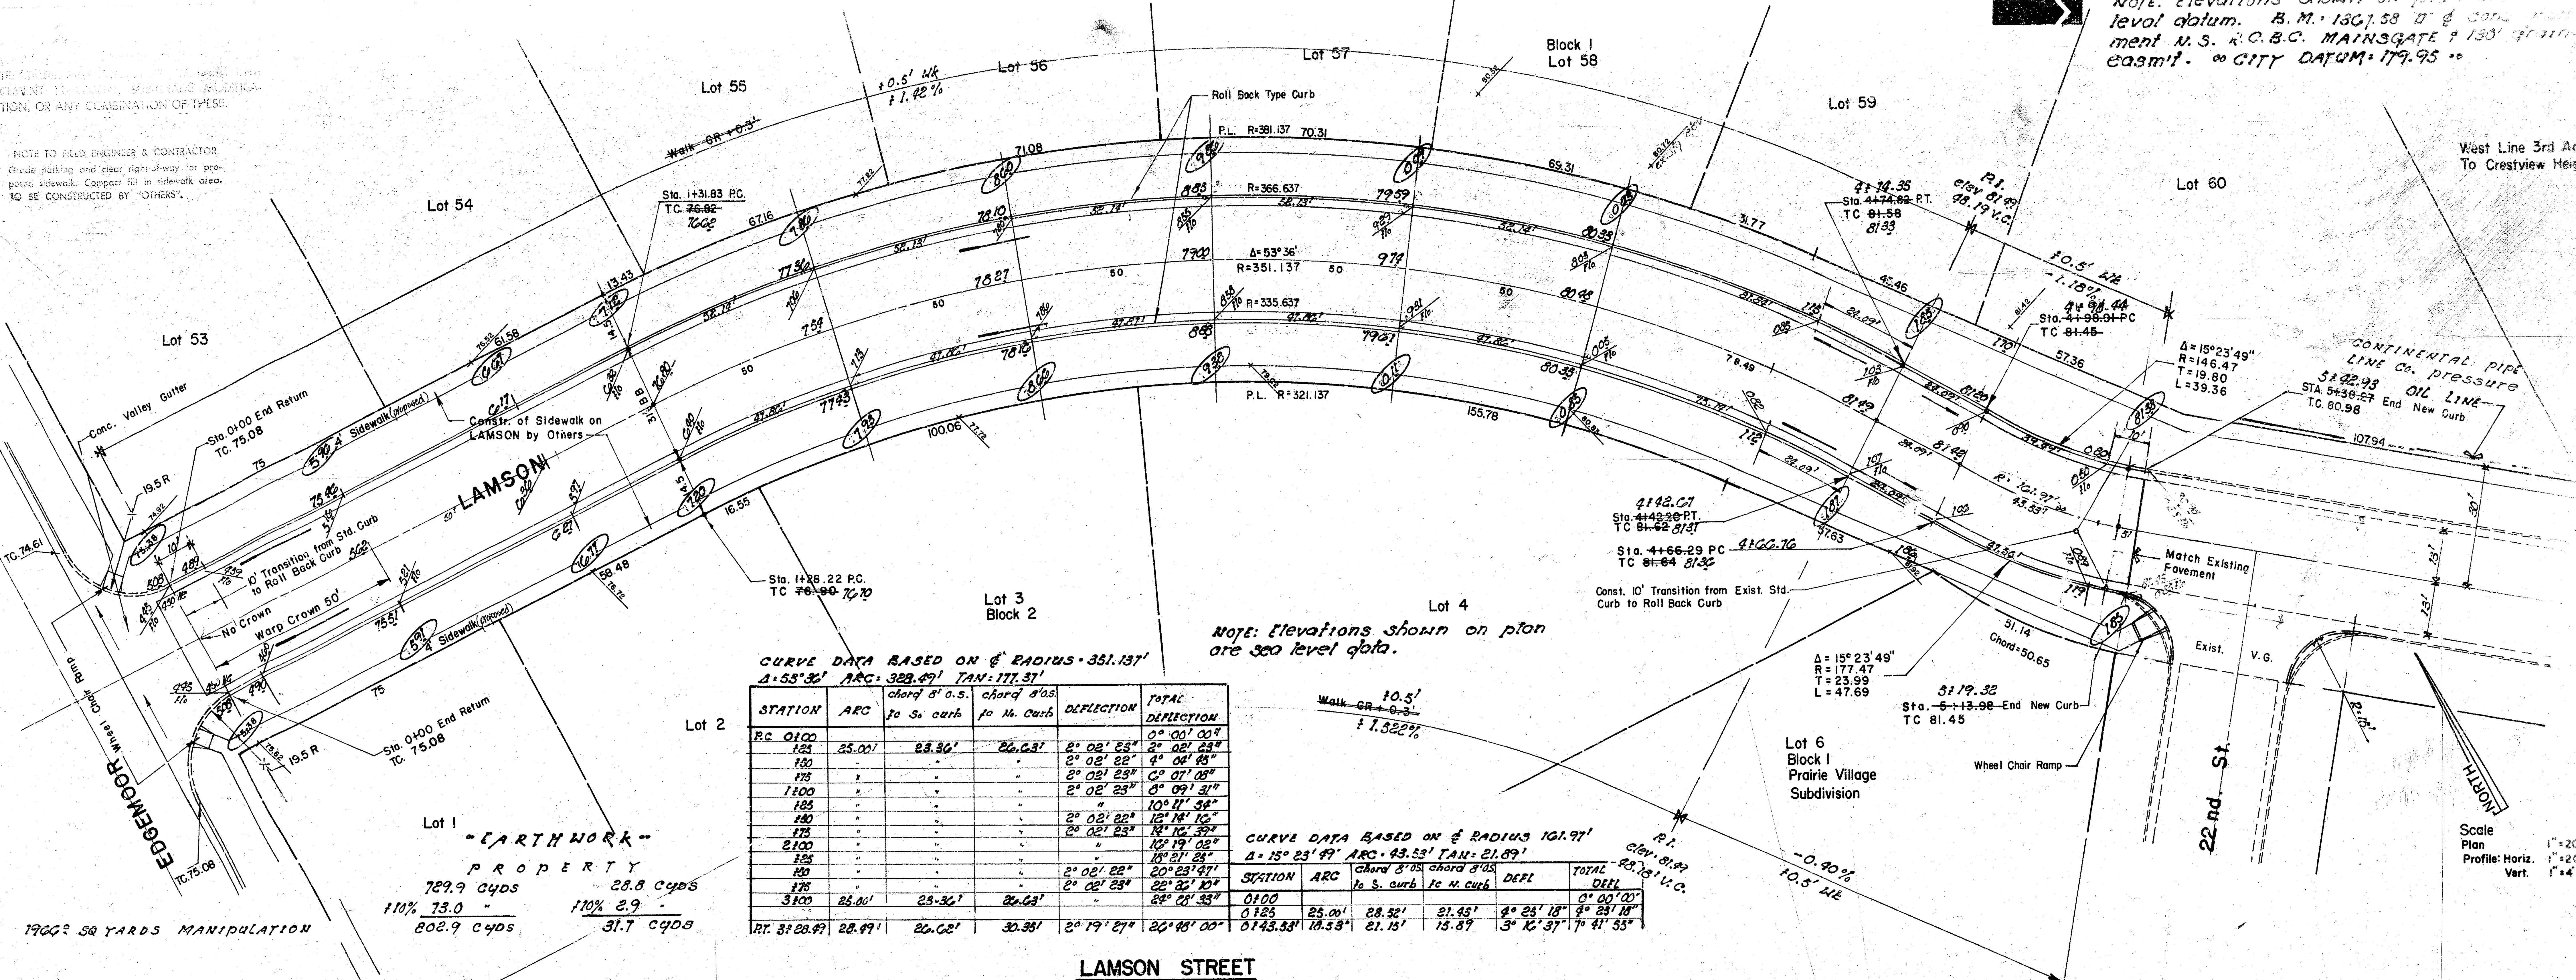


CURVE DATA BASED ON Δ RADIUS 351.137'
 $\Delta = 55.36'$ ARC = 328.49' TAN = 177.37'

STATION	ARC	Chord 8' o.s. to S. curb	Chord 8' o.s. to N. curb	DEFLECTION	TOTAL DEFLECTION
P.C. 0+00					

CURVE DATA BASED ON Δ RADIUS 101.97'
 $\Delta = 15.23' 49"$ ARC = 43.53' TAN = 21.89'

STATION	ARC	Chord 8' o.s. to S. curb	Chord 8' o.s. to N. curb	DEFL	TOTAL DEFL
0+00					

LAMSON STREET

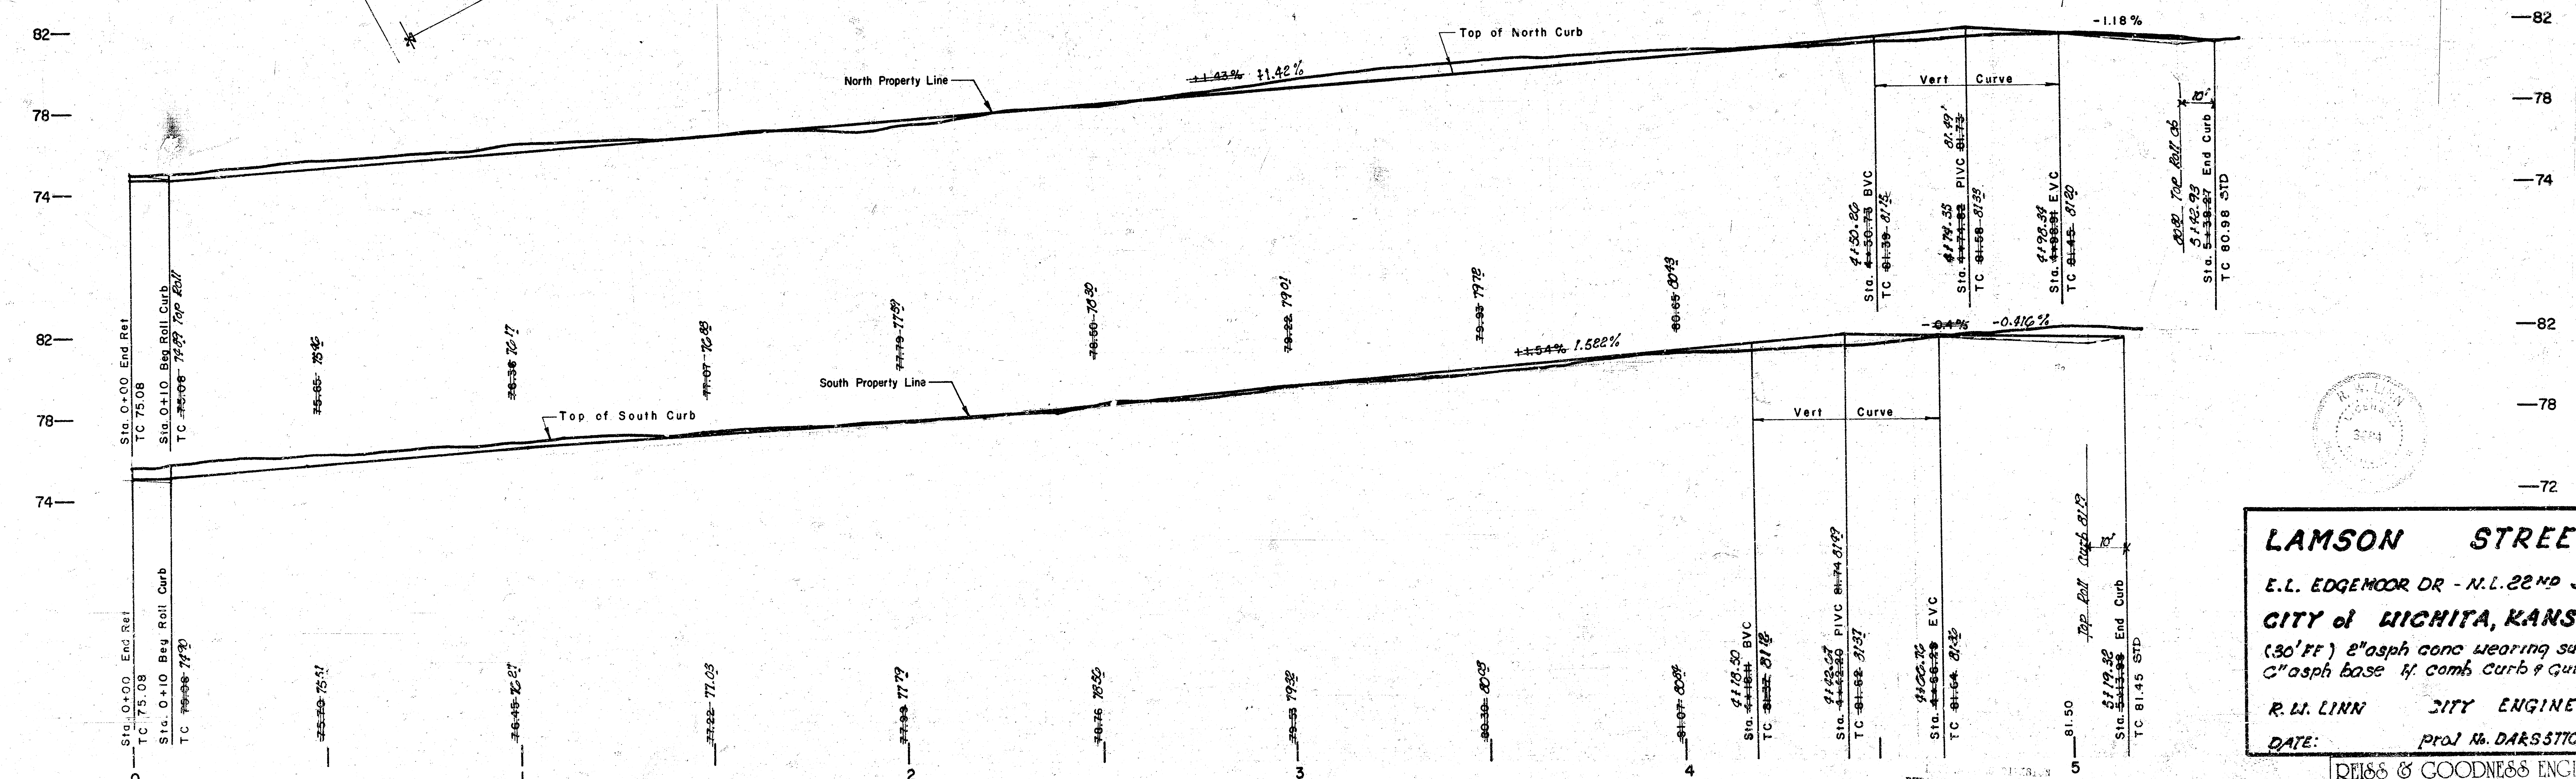

LAMSON STREET

E.L. EDGEWOOD DR - N.L. 22ND

CITY OF WICHITA, KANSAS

(30' FF) 8" asph conc wearing surface

6" asph base 14" comb curb & gutter

R. L. LINN CITY ENGINEER

DATE: PROJ. NO. DARS 5710

REISS & GOODNESS ENGINEERS

2160 WEST 21ST STREET
WICHITA, KANSAS 67204
(316) 832-0213

REVISED SEPT 8, 1977

5+36.18 Existing PWT
Exc. 22.1

Exc. 6.5 cyds.

6+26.13

Exc. 47.4 cyds.

5+00

Exc. 29.6 cyds.

4+82.6 PWT

Exc. 38.5 cyds.

4+58.51 PWT

Exc. 29.9 cyds.
CF. 1.1 cyds.

4+34.42 PWT

Exc. 40.2 cyds.
CF. 1.5 cyds.

4+00

Exc. 74.4 cyds.

3+50

Exc. 70.7 cyds.

3+00

Exc. 42.0 cyds.
CF. 0.5 cyds.

2+50

Exc. 18.1 cyds.
CF. 12.8 cyds.

2+00

Exc. 31.8 cyds.
CF. 0.9 cyds.

1+50

Exc. 101.9 cyds.

1+00

Exc. 108.2 cyds.

0+50

Exc. 104.0 cyds.

0+00

Exc. 104.0 cyds.



LAMSON

SHEET TOTALS
CUT 74.59 CY
FILL 98.4 CY

