



STA ON 9' OFFSET E OF WEST RD 0+00 TO 2+54.31
STA ON W. RD 2+54.31 ON NORTH.

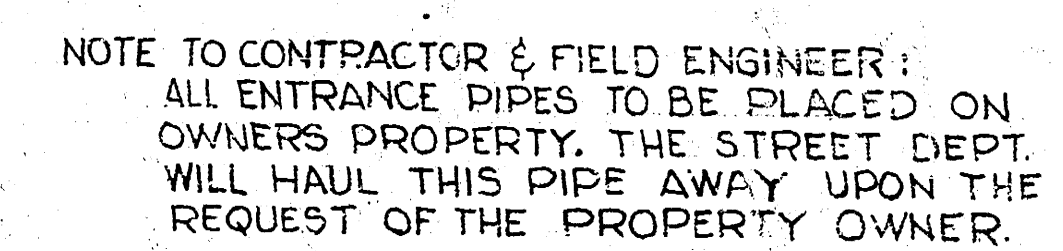

CITY OF WICHITA, KANSAS
B.E. SMITH CITY ENGINEER
JAN. 9, 1952 Proj. No. C12-130

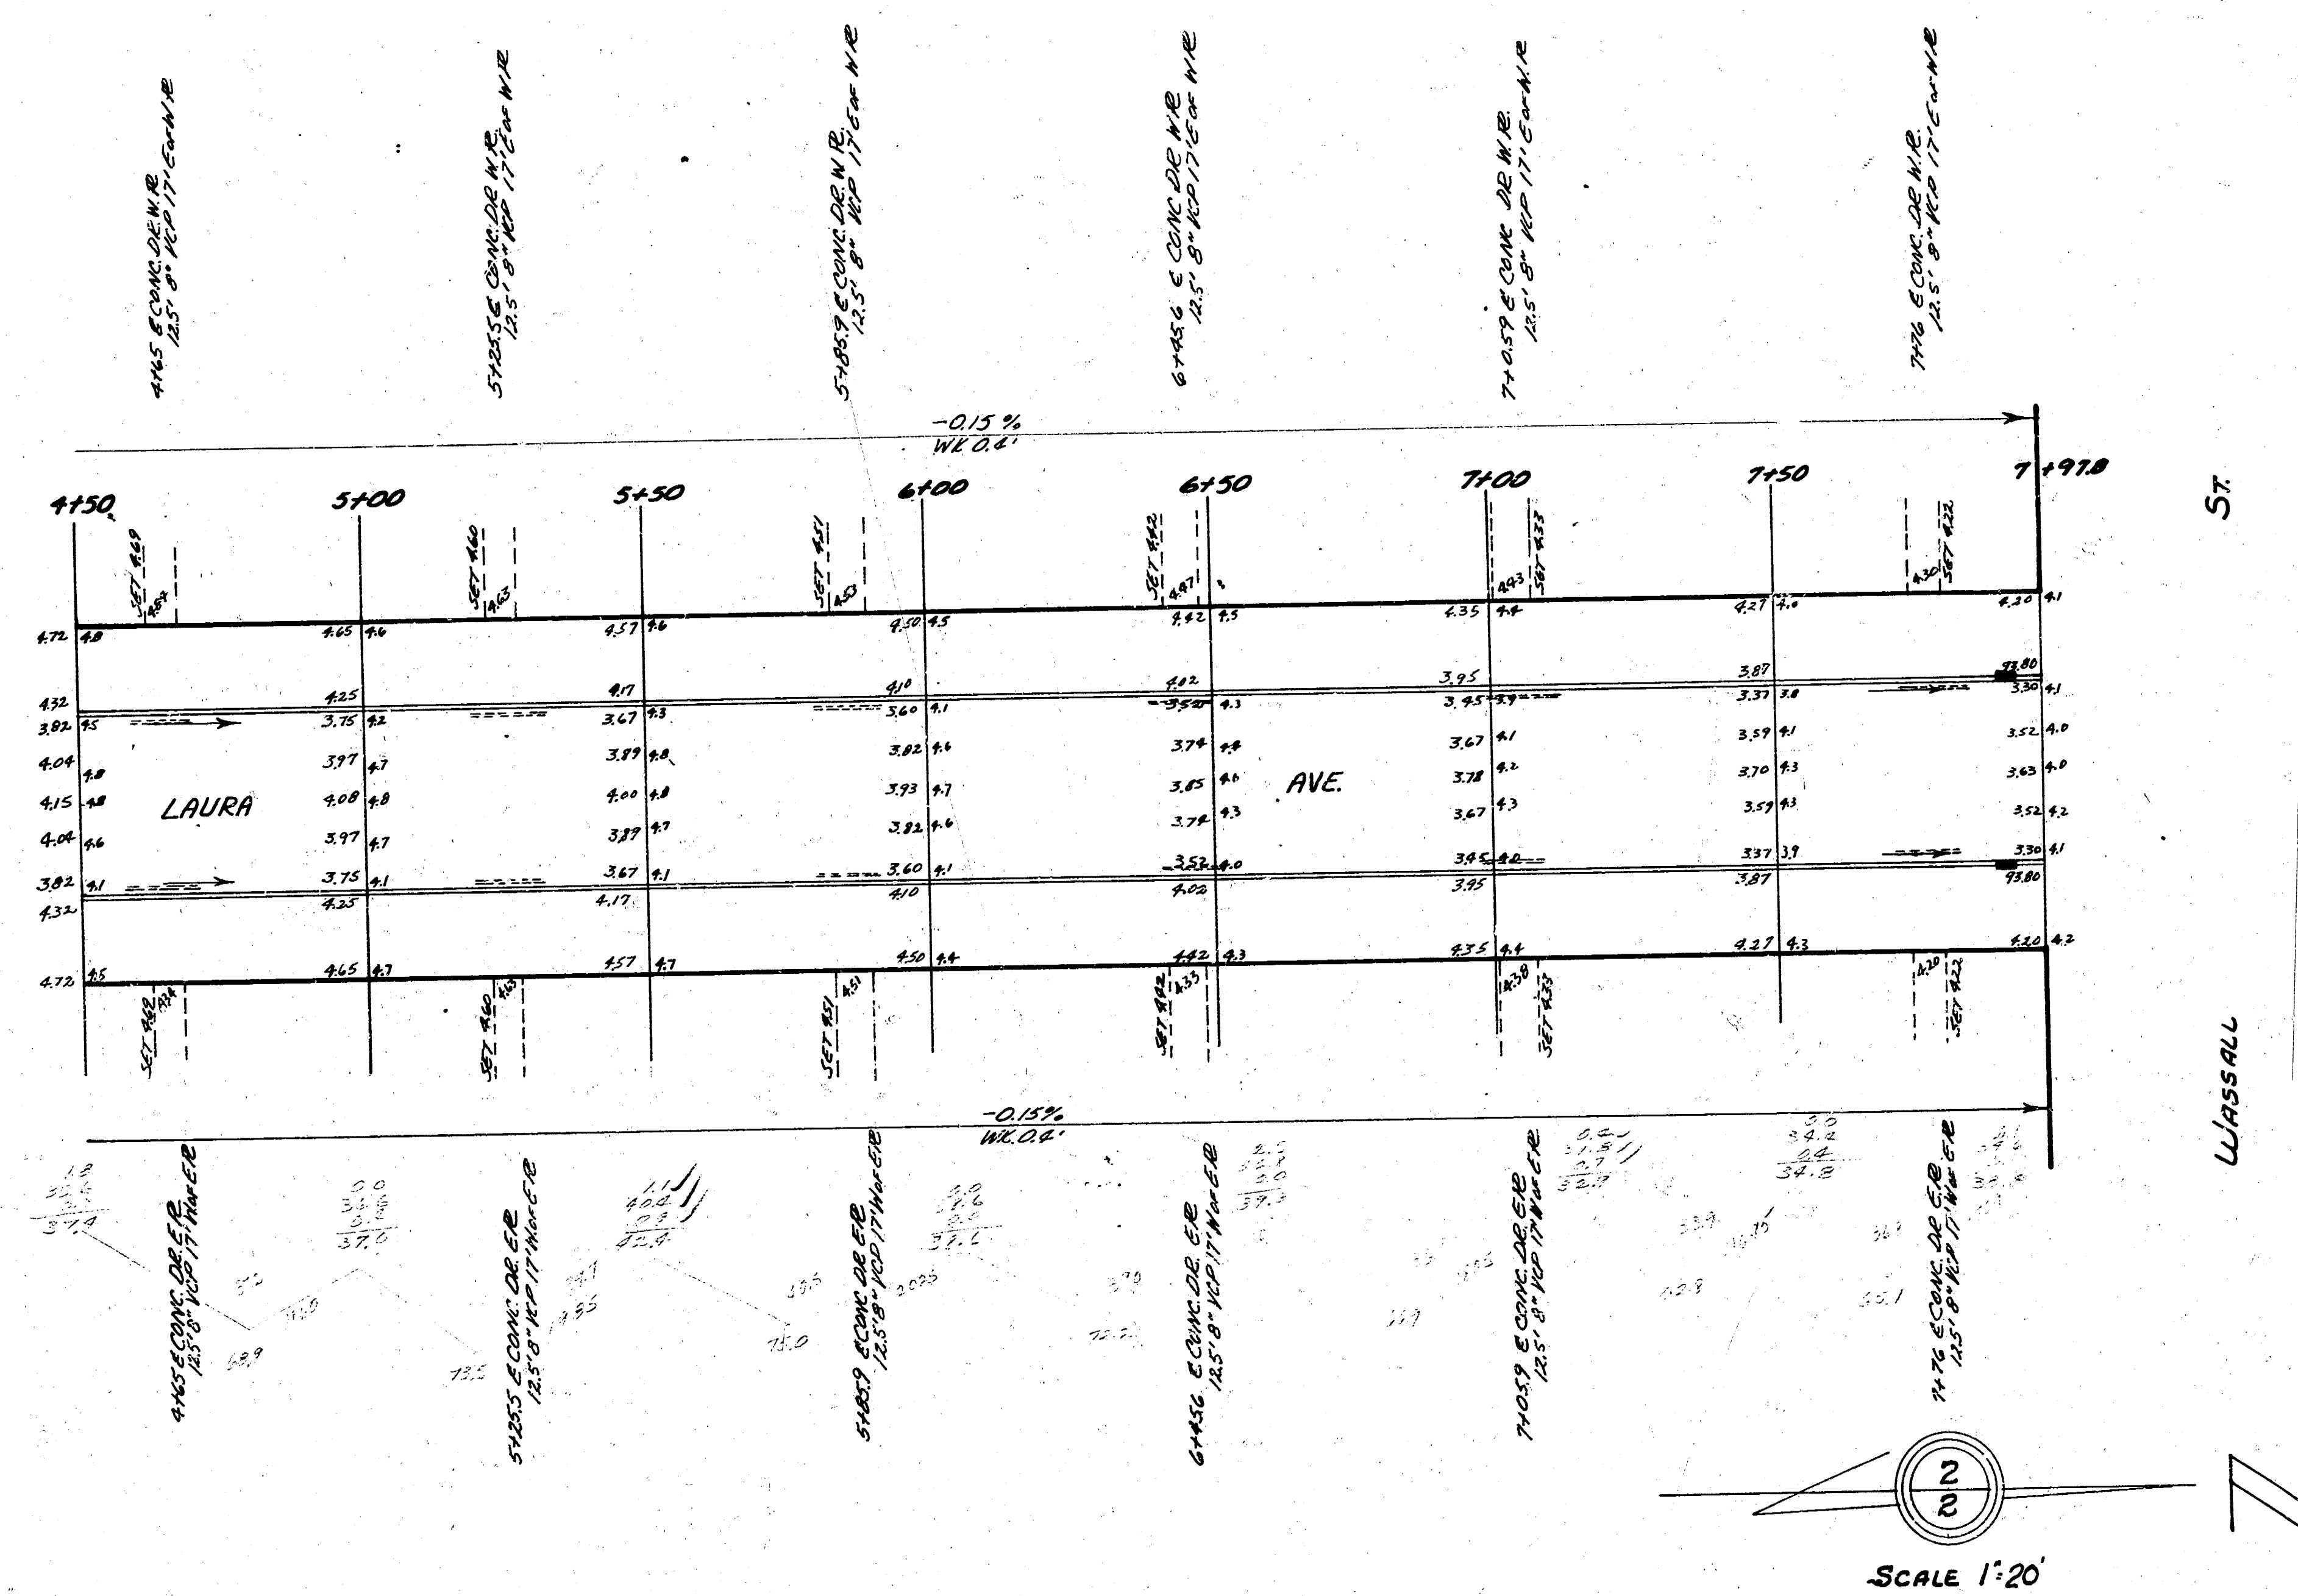

LAURA AVE.