


B.M. 18174 N.E. Cor. Cong. Drive bk. Ho. "1082 Armour"
 B.M. 17116 "B" in Ritech Bros. N. of Lawrence Dr. & E.L. Lawrence Lane.
 Baseline & Stationing as North Property Line.


Surveyed by
 Date
 City Engineer

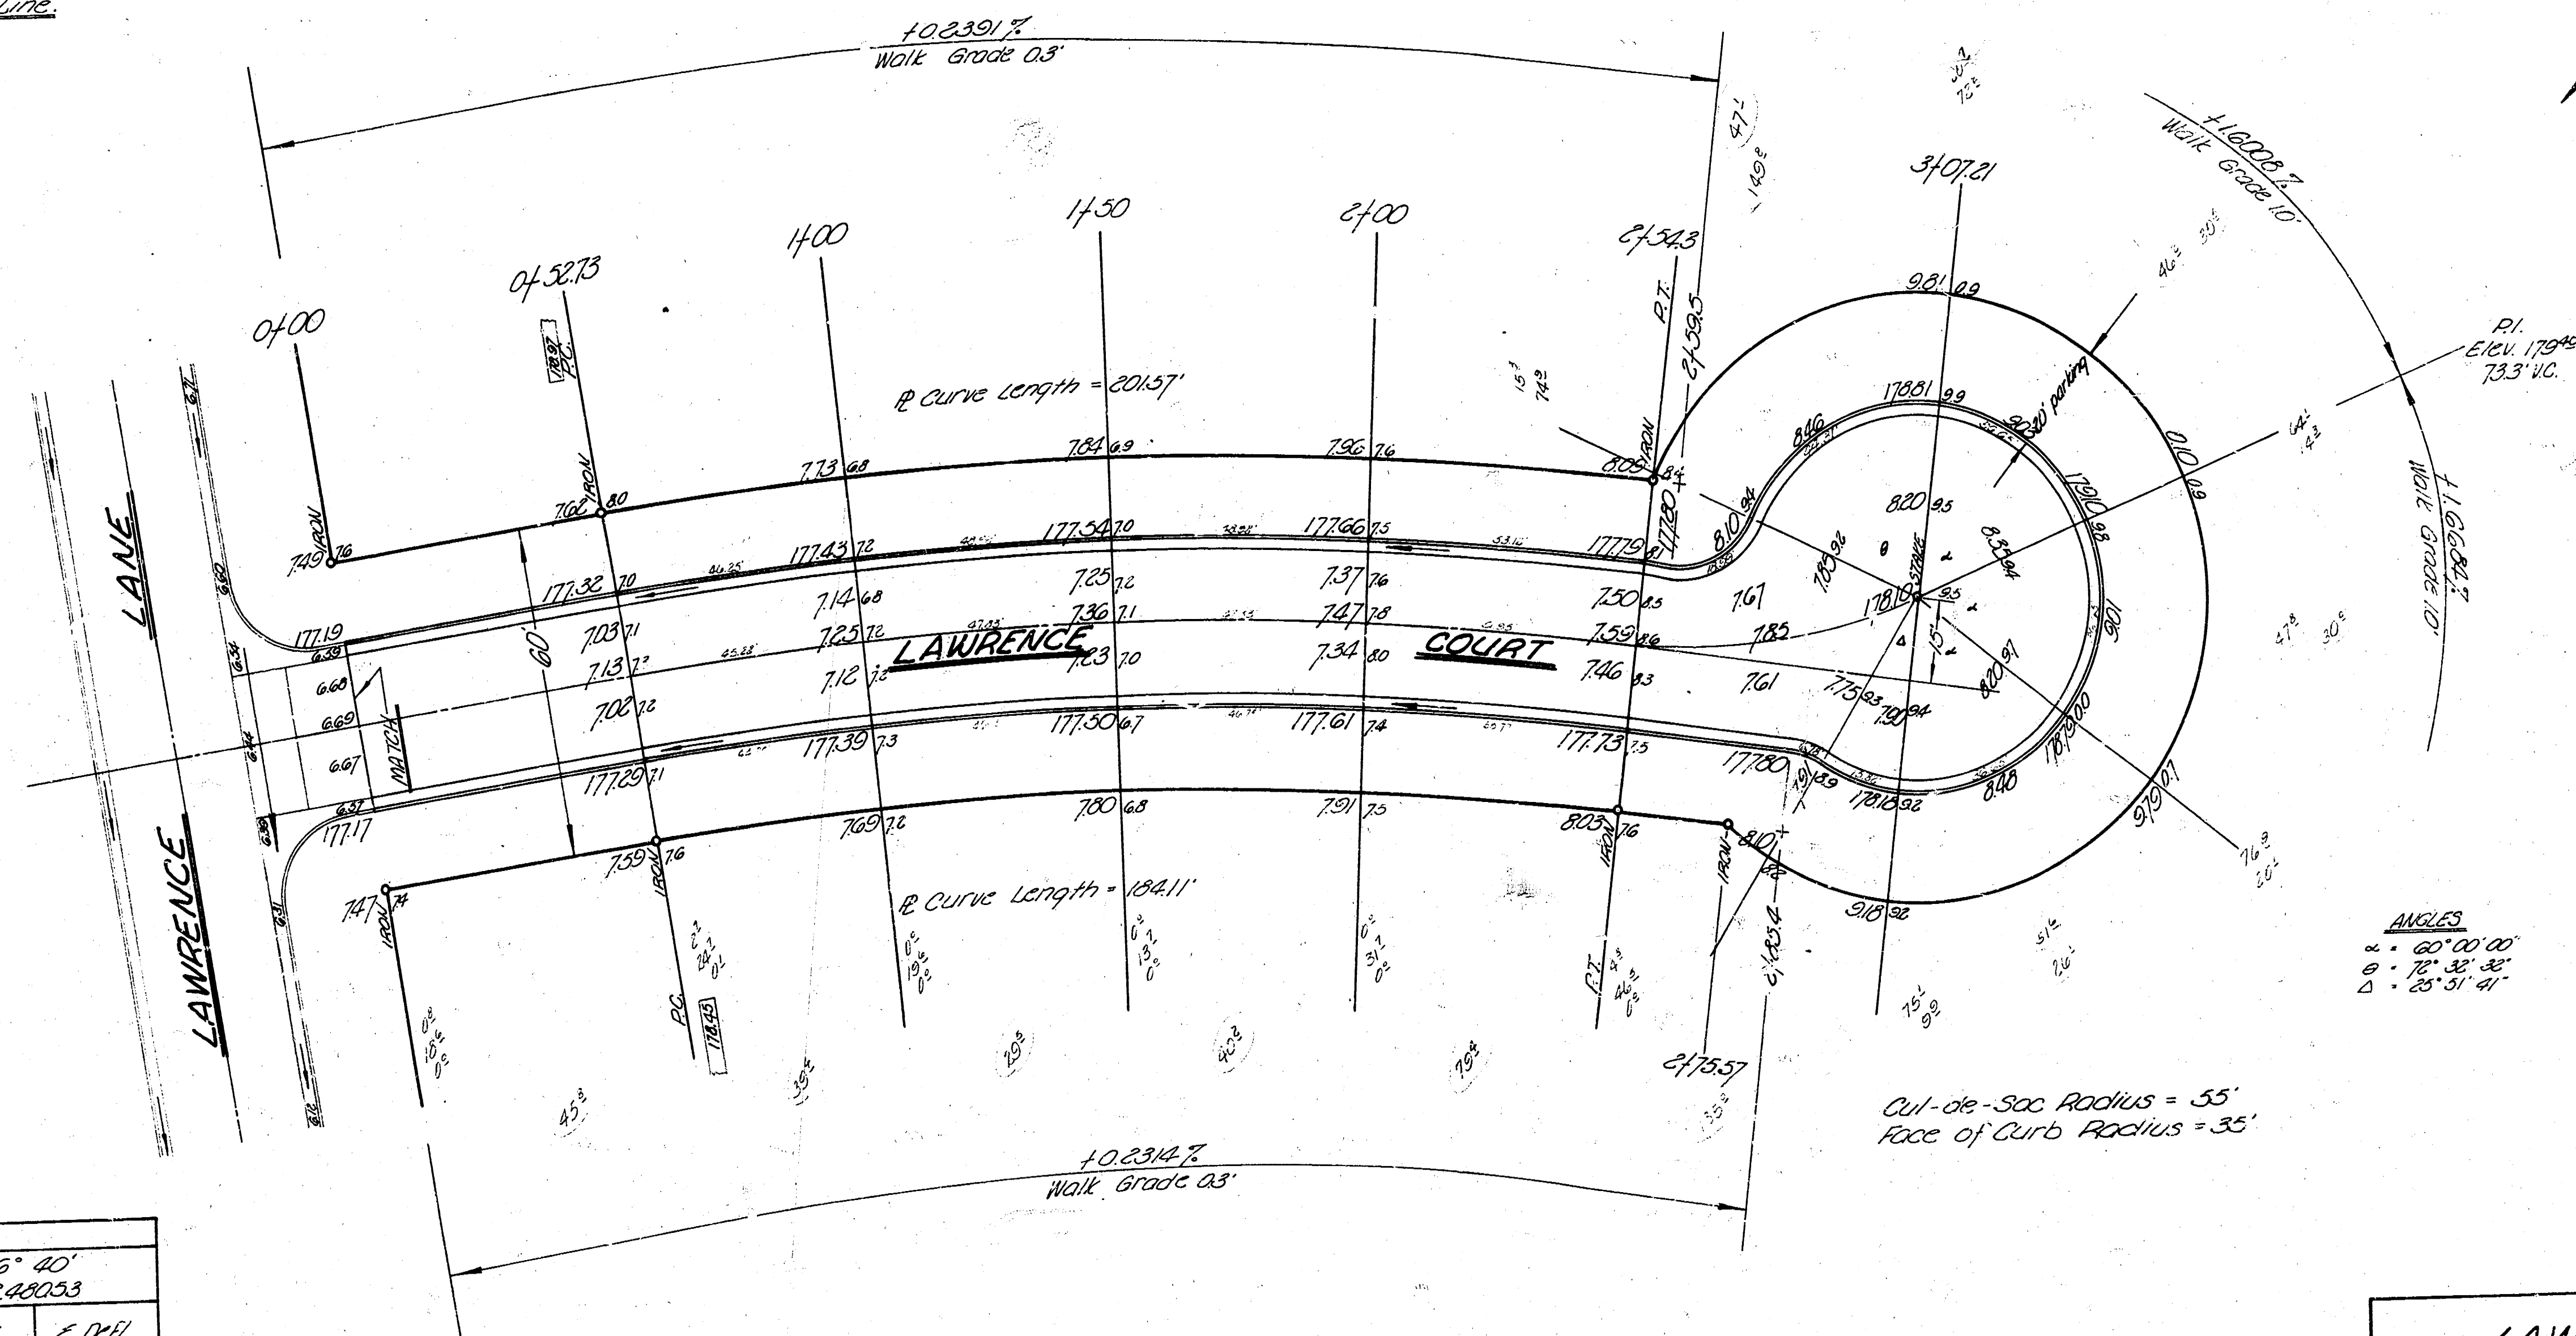

FILE

PLAN OF THE PROPOSED LANE AND COURT


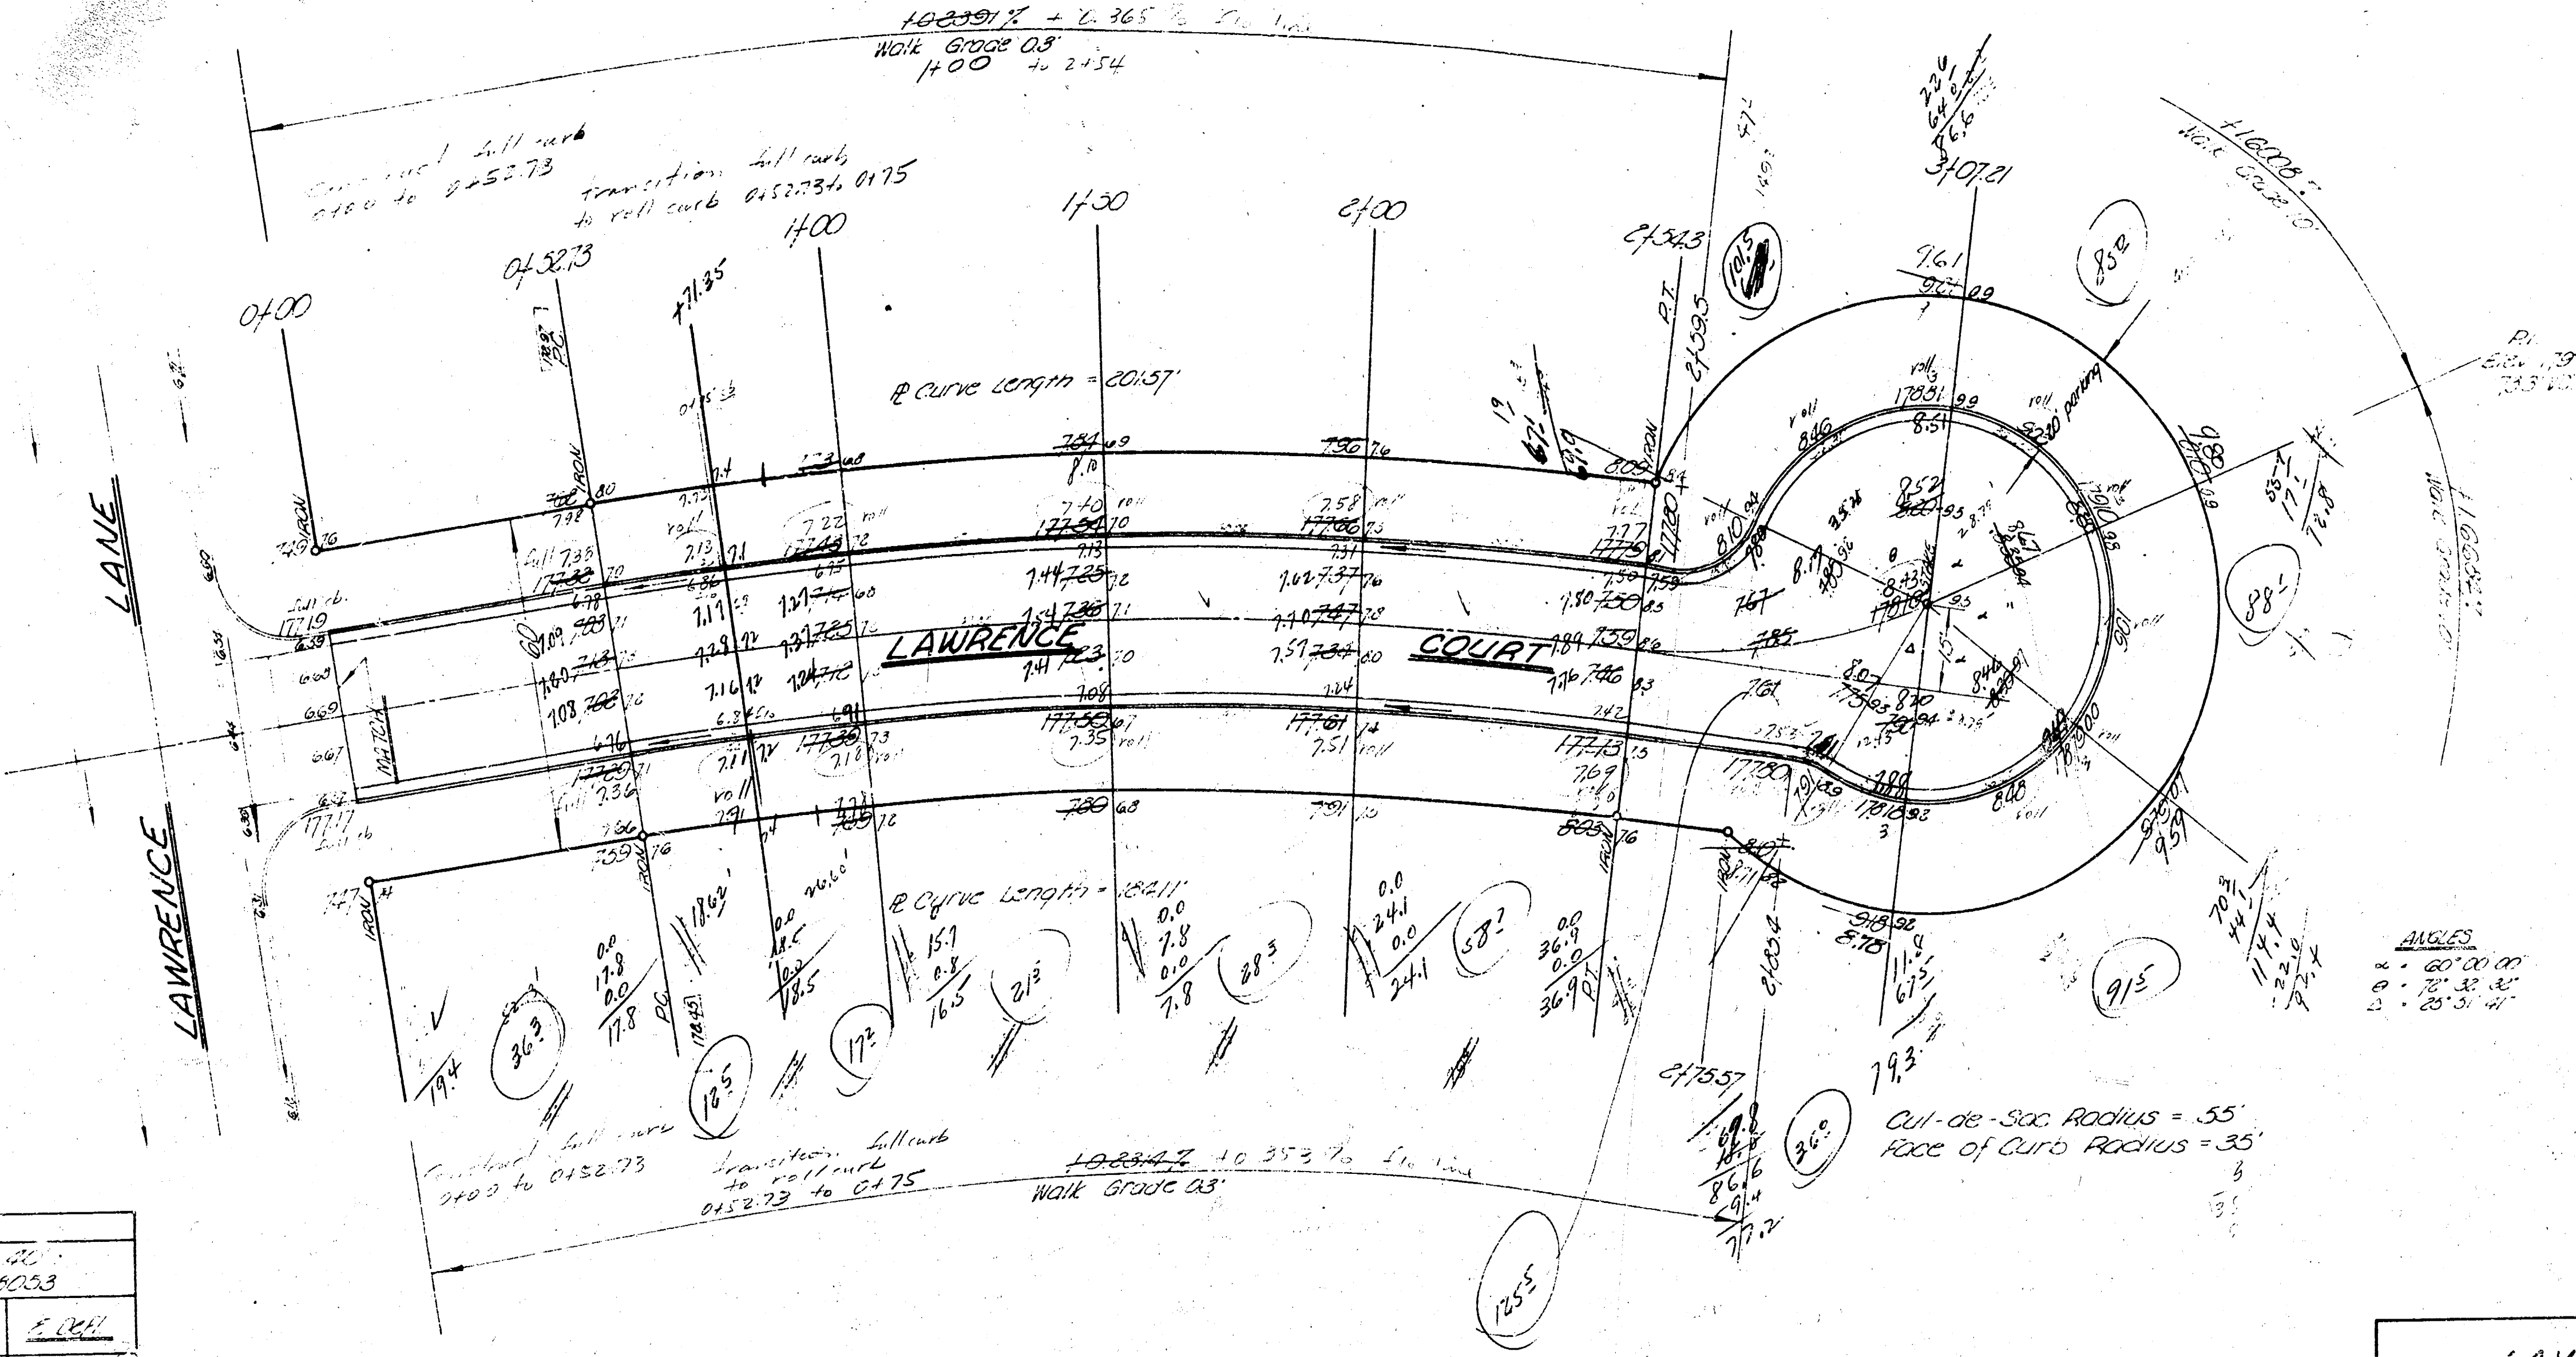

CURVE DATA					

EXCAVATION



LAWRENCE COURT
 86' - 8' - 30' AC.
 B.E. Smith

When standard section
 and top of the road
 use 6' width.