
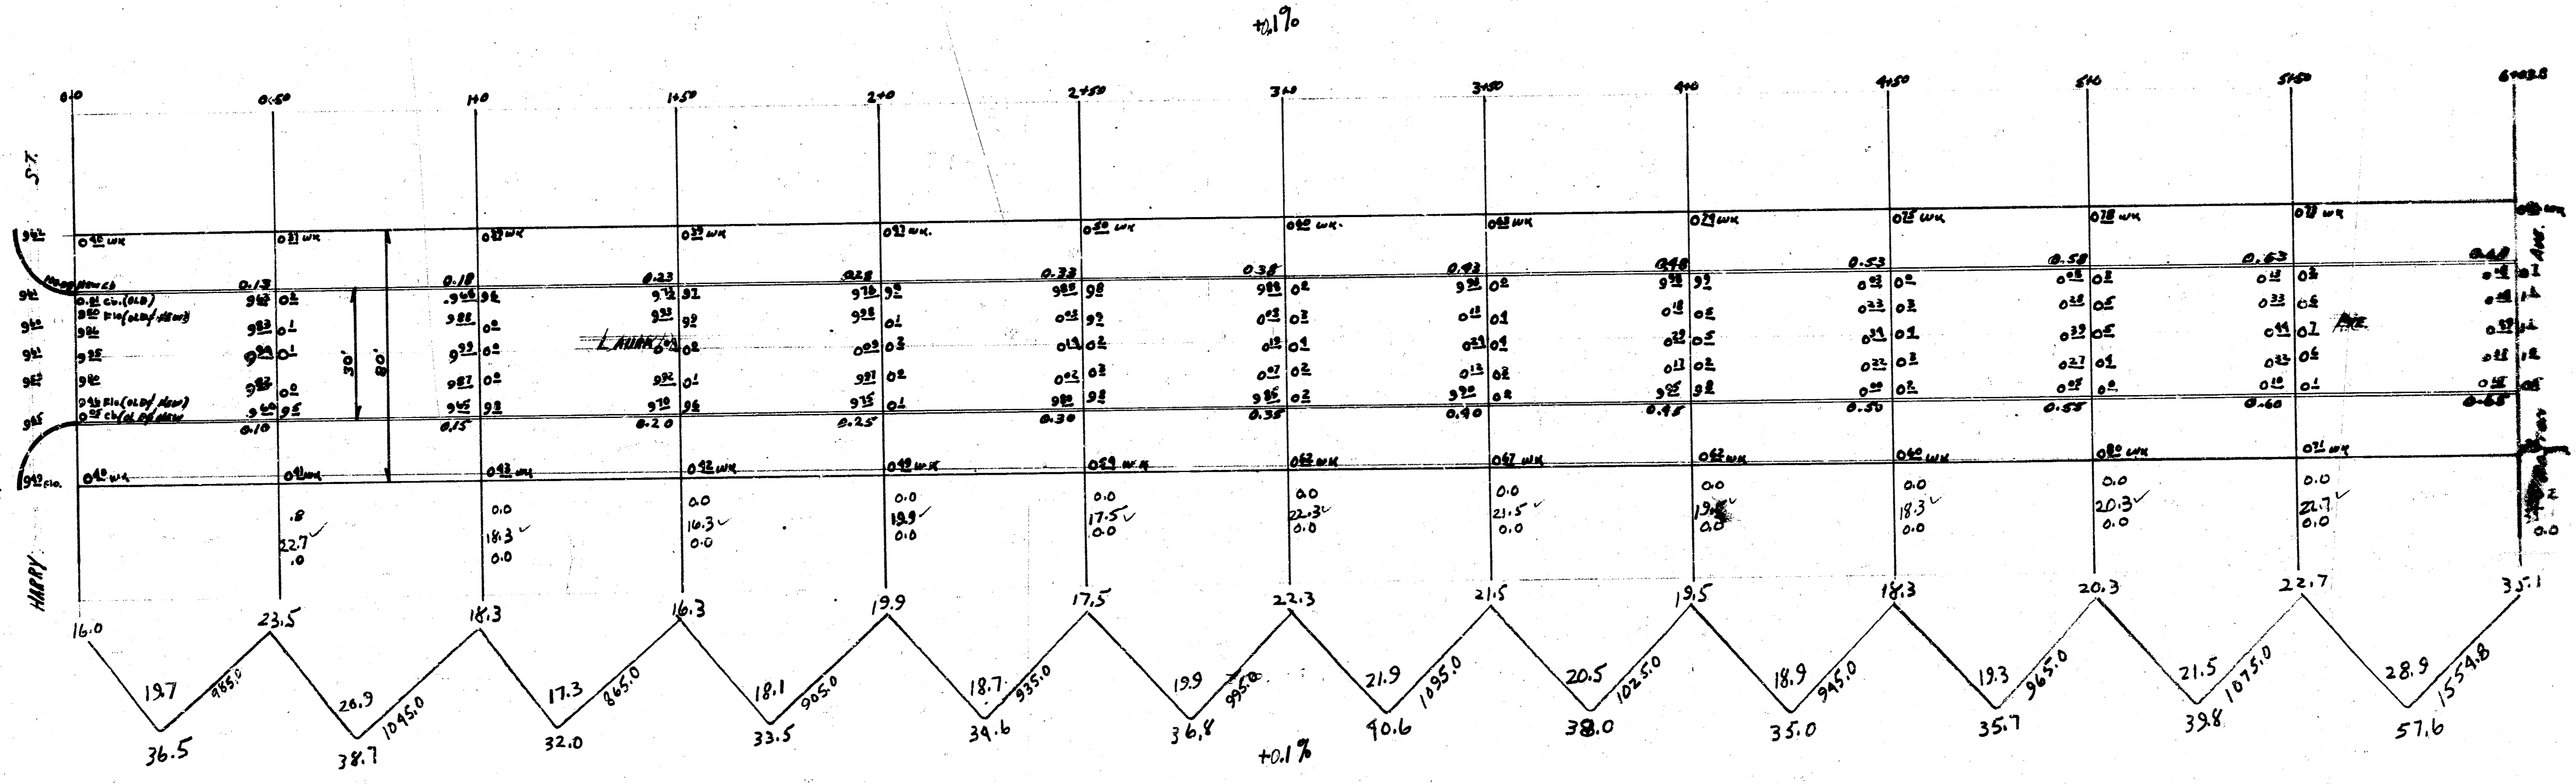


X Sch m  
12000 X"

B.M. 99.21 - Iron in thin S.L. Harry & Laura

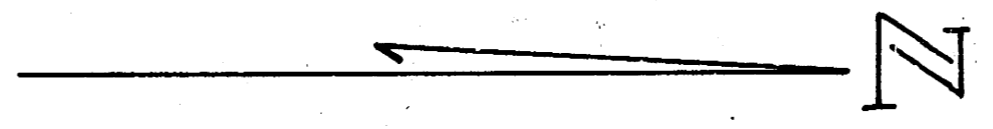

Propped by  
 36.5  
 38.7  
 32.0  
 33.5  
 34.6  
 36.8  
 40.6  
 38.0  
 35.0  
 35.7  
 39.8  
 57.6  
 45.2 + 10%  
 524.7

LAURA AVE.  
 ST. BOSTON TO N.L. HARRY  
 30' CONC. CURB  
 CITY OF WICHITA, KAN  
 ENGINEERING DIV.  
 L.H. WHITE CITY ENGR.  
 JULY 1947