


B.M. 155.50 S.E. Cor. Porch Mos.# 5838 Castle Dr.
NOTE:
Stationing on 9.0' offset N. of S.P.L.

Exc.
PROP. CITY
0
2689.9
+10%
29589 cu. YDS.

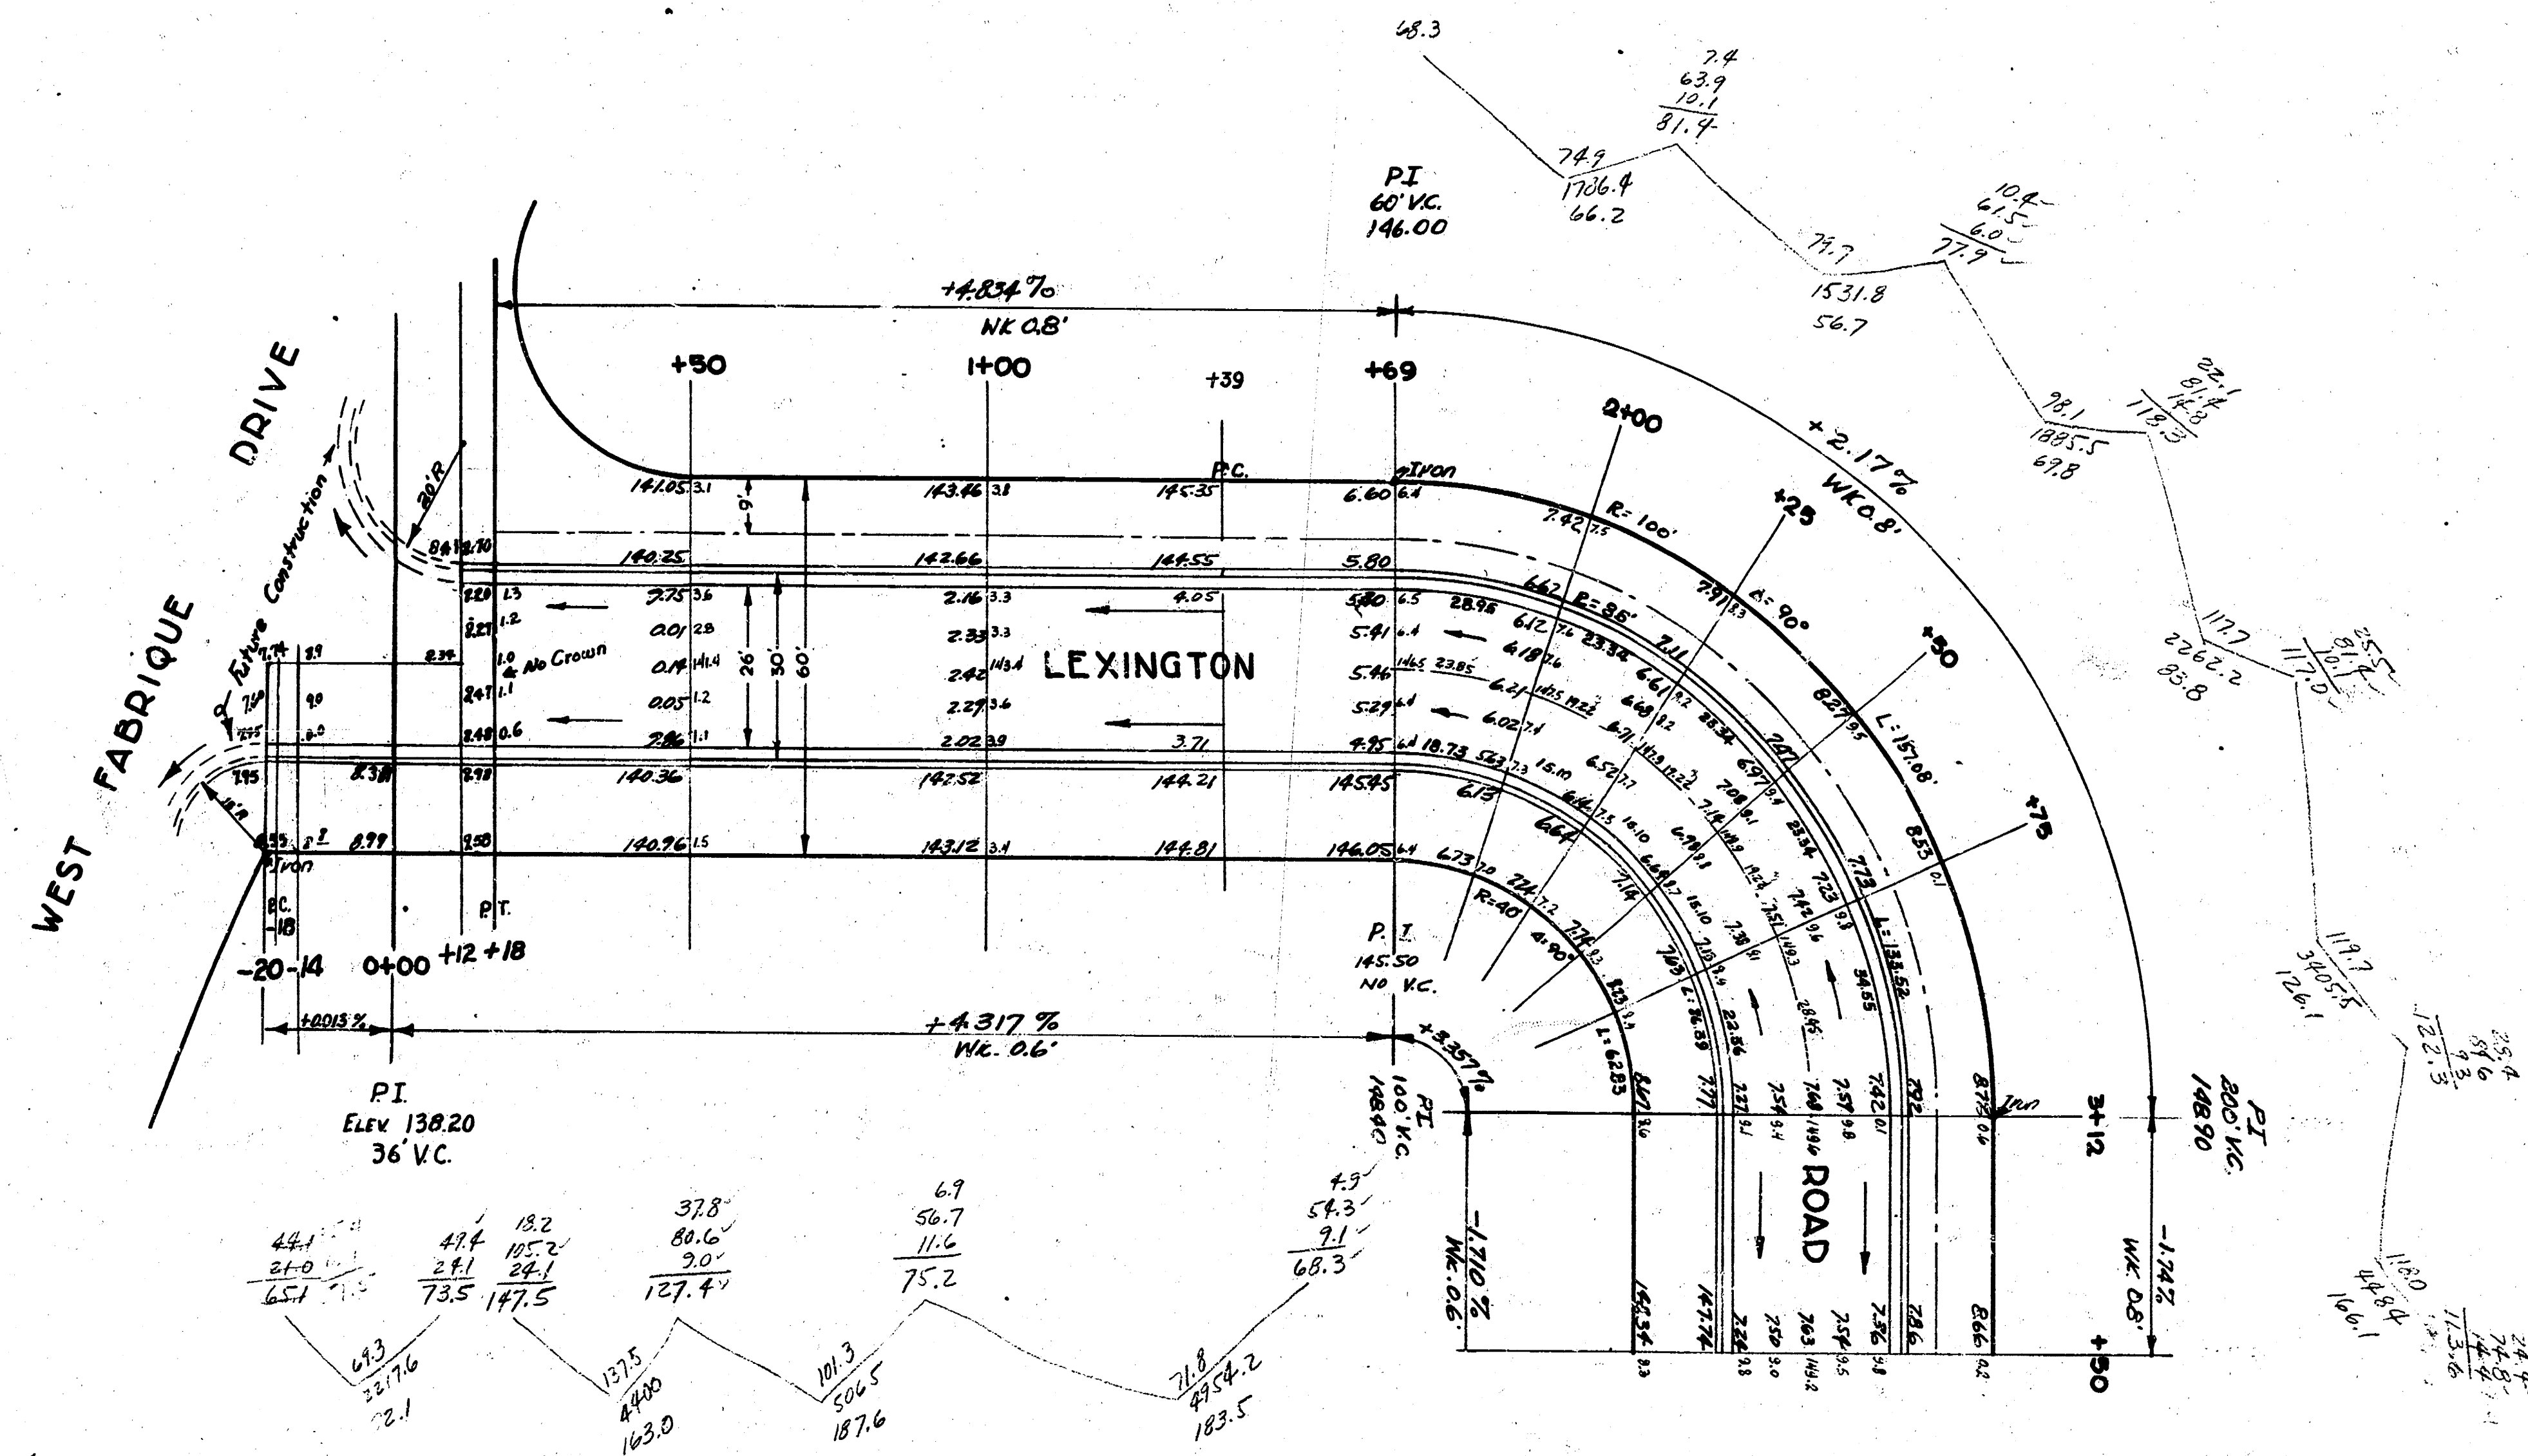


SCALE 1"=20'




 $\frac{1}{2}$

REVISED 1-25-52

LEXINGTON ROAD
WLWEST FABRIQUE TO SL.CASTLE DR
26-2-30 AC.
CITY OF WICHITA, KANSAS
L.K.WHITE CITY ENGINEER
OCT. 1951 PROJ. NO. C11-168

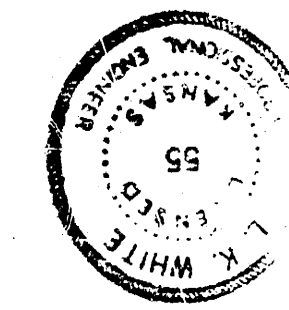

S-4

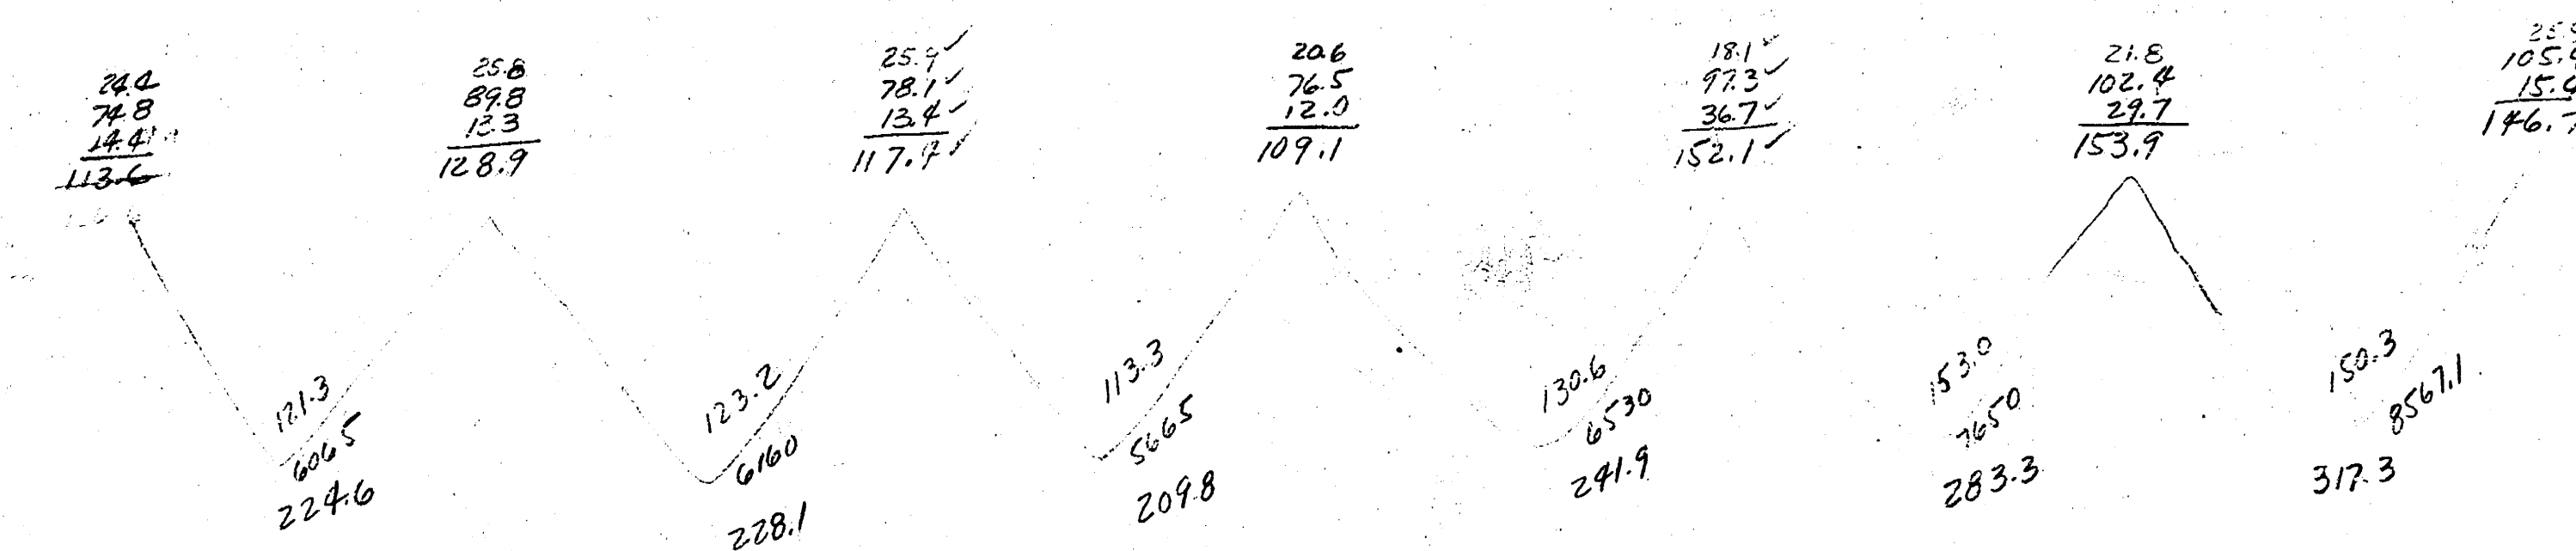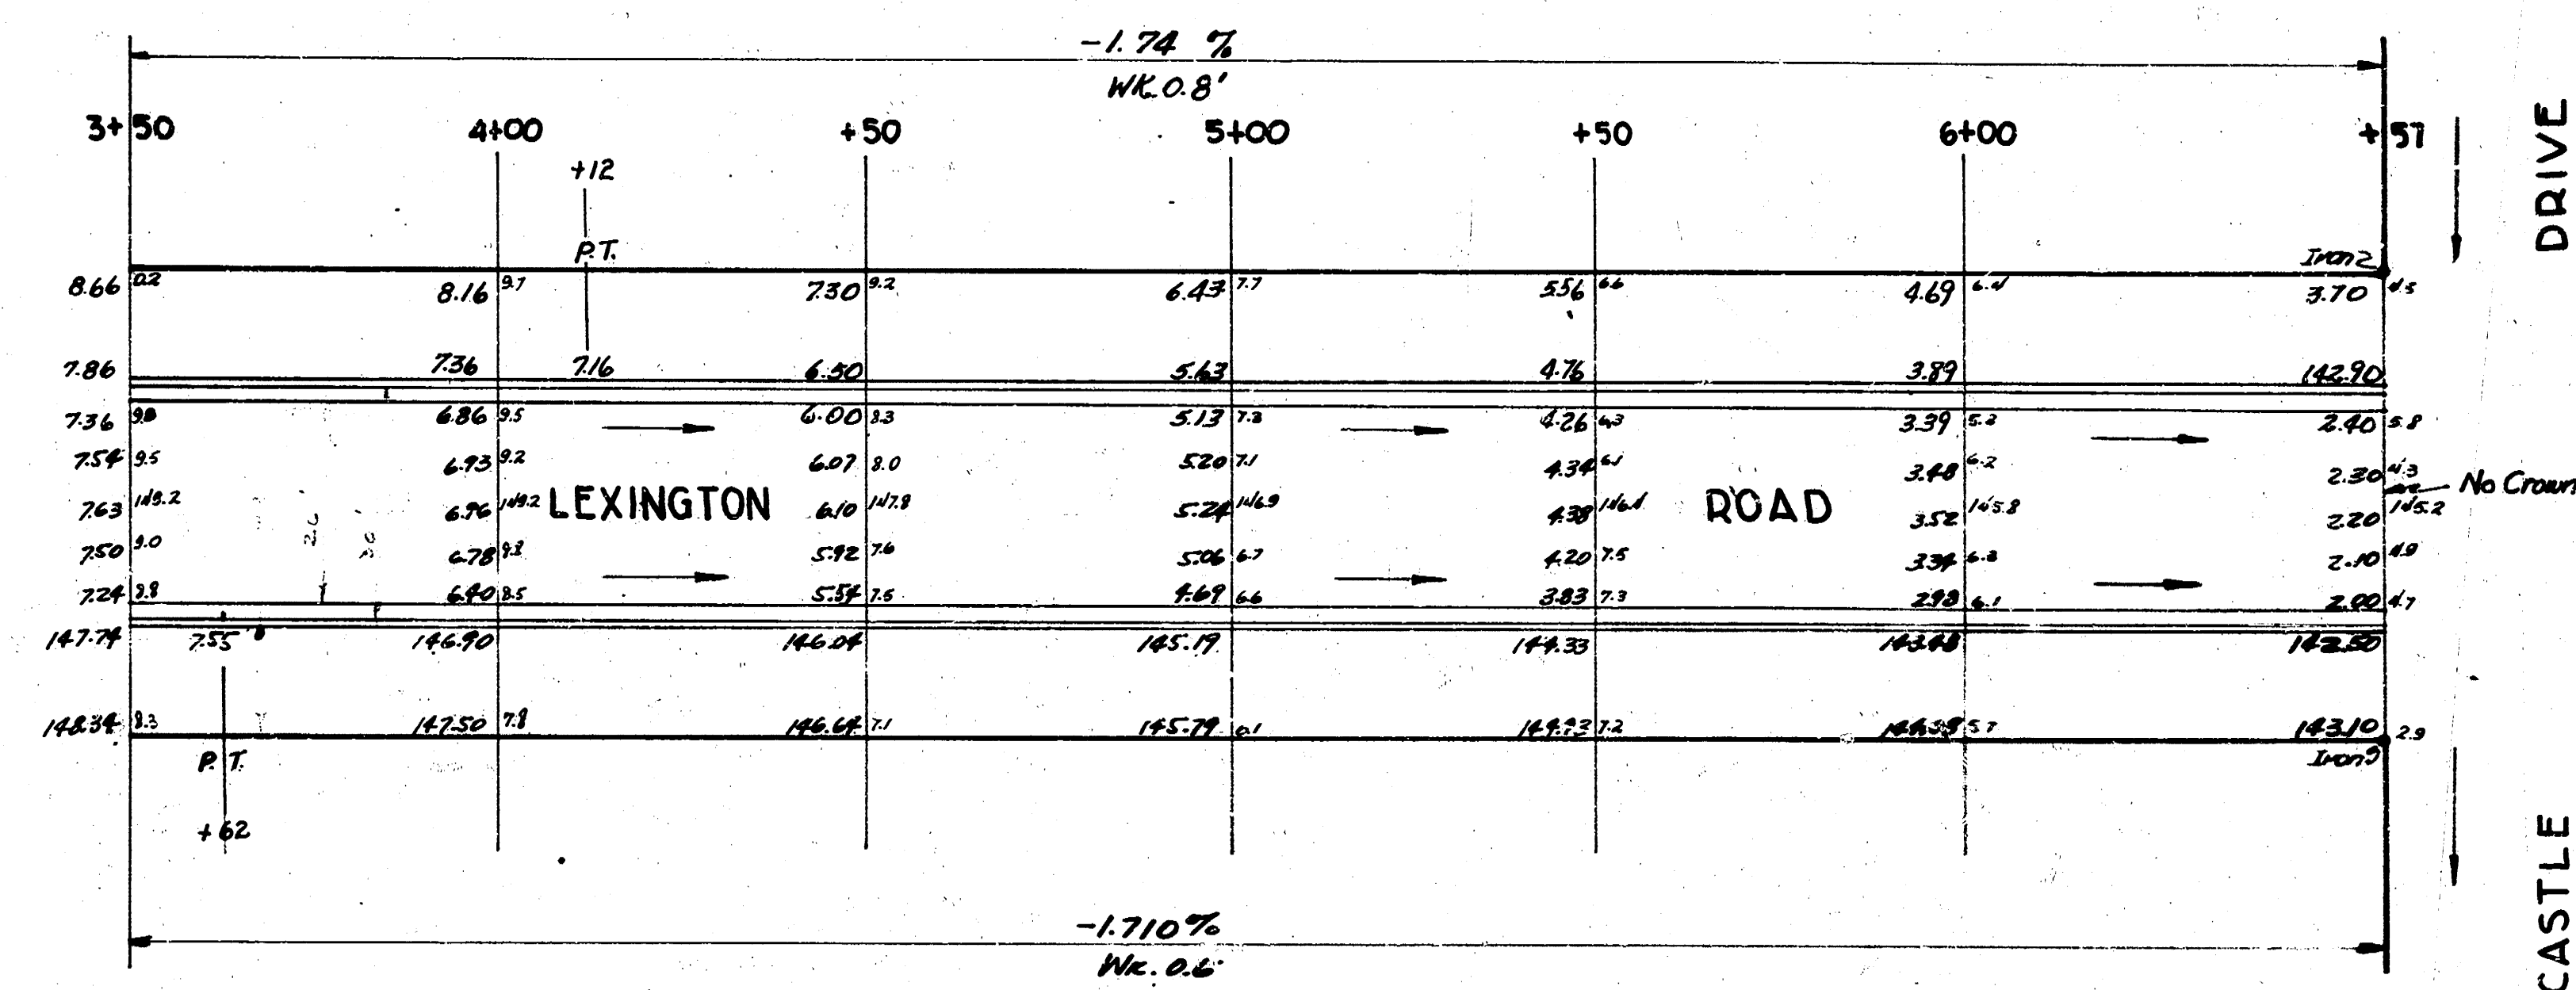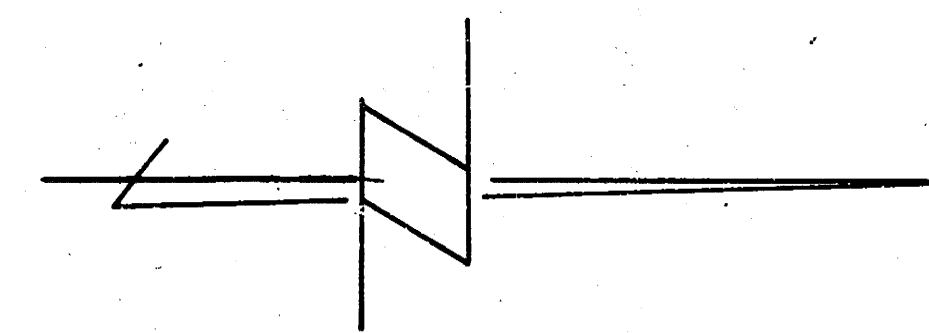

2

2

LEXINGTON ROAD