

LONGFELLOW LANE
Proj. No. C 14-167



STA ON E.R. EXCEPT CURVE
 CURVE STA ON 9' OFFSET W OF E.R.


CURVE 4" 14" 46' 20" DATA




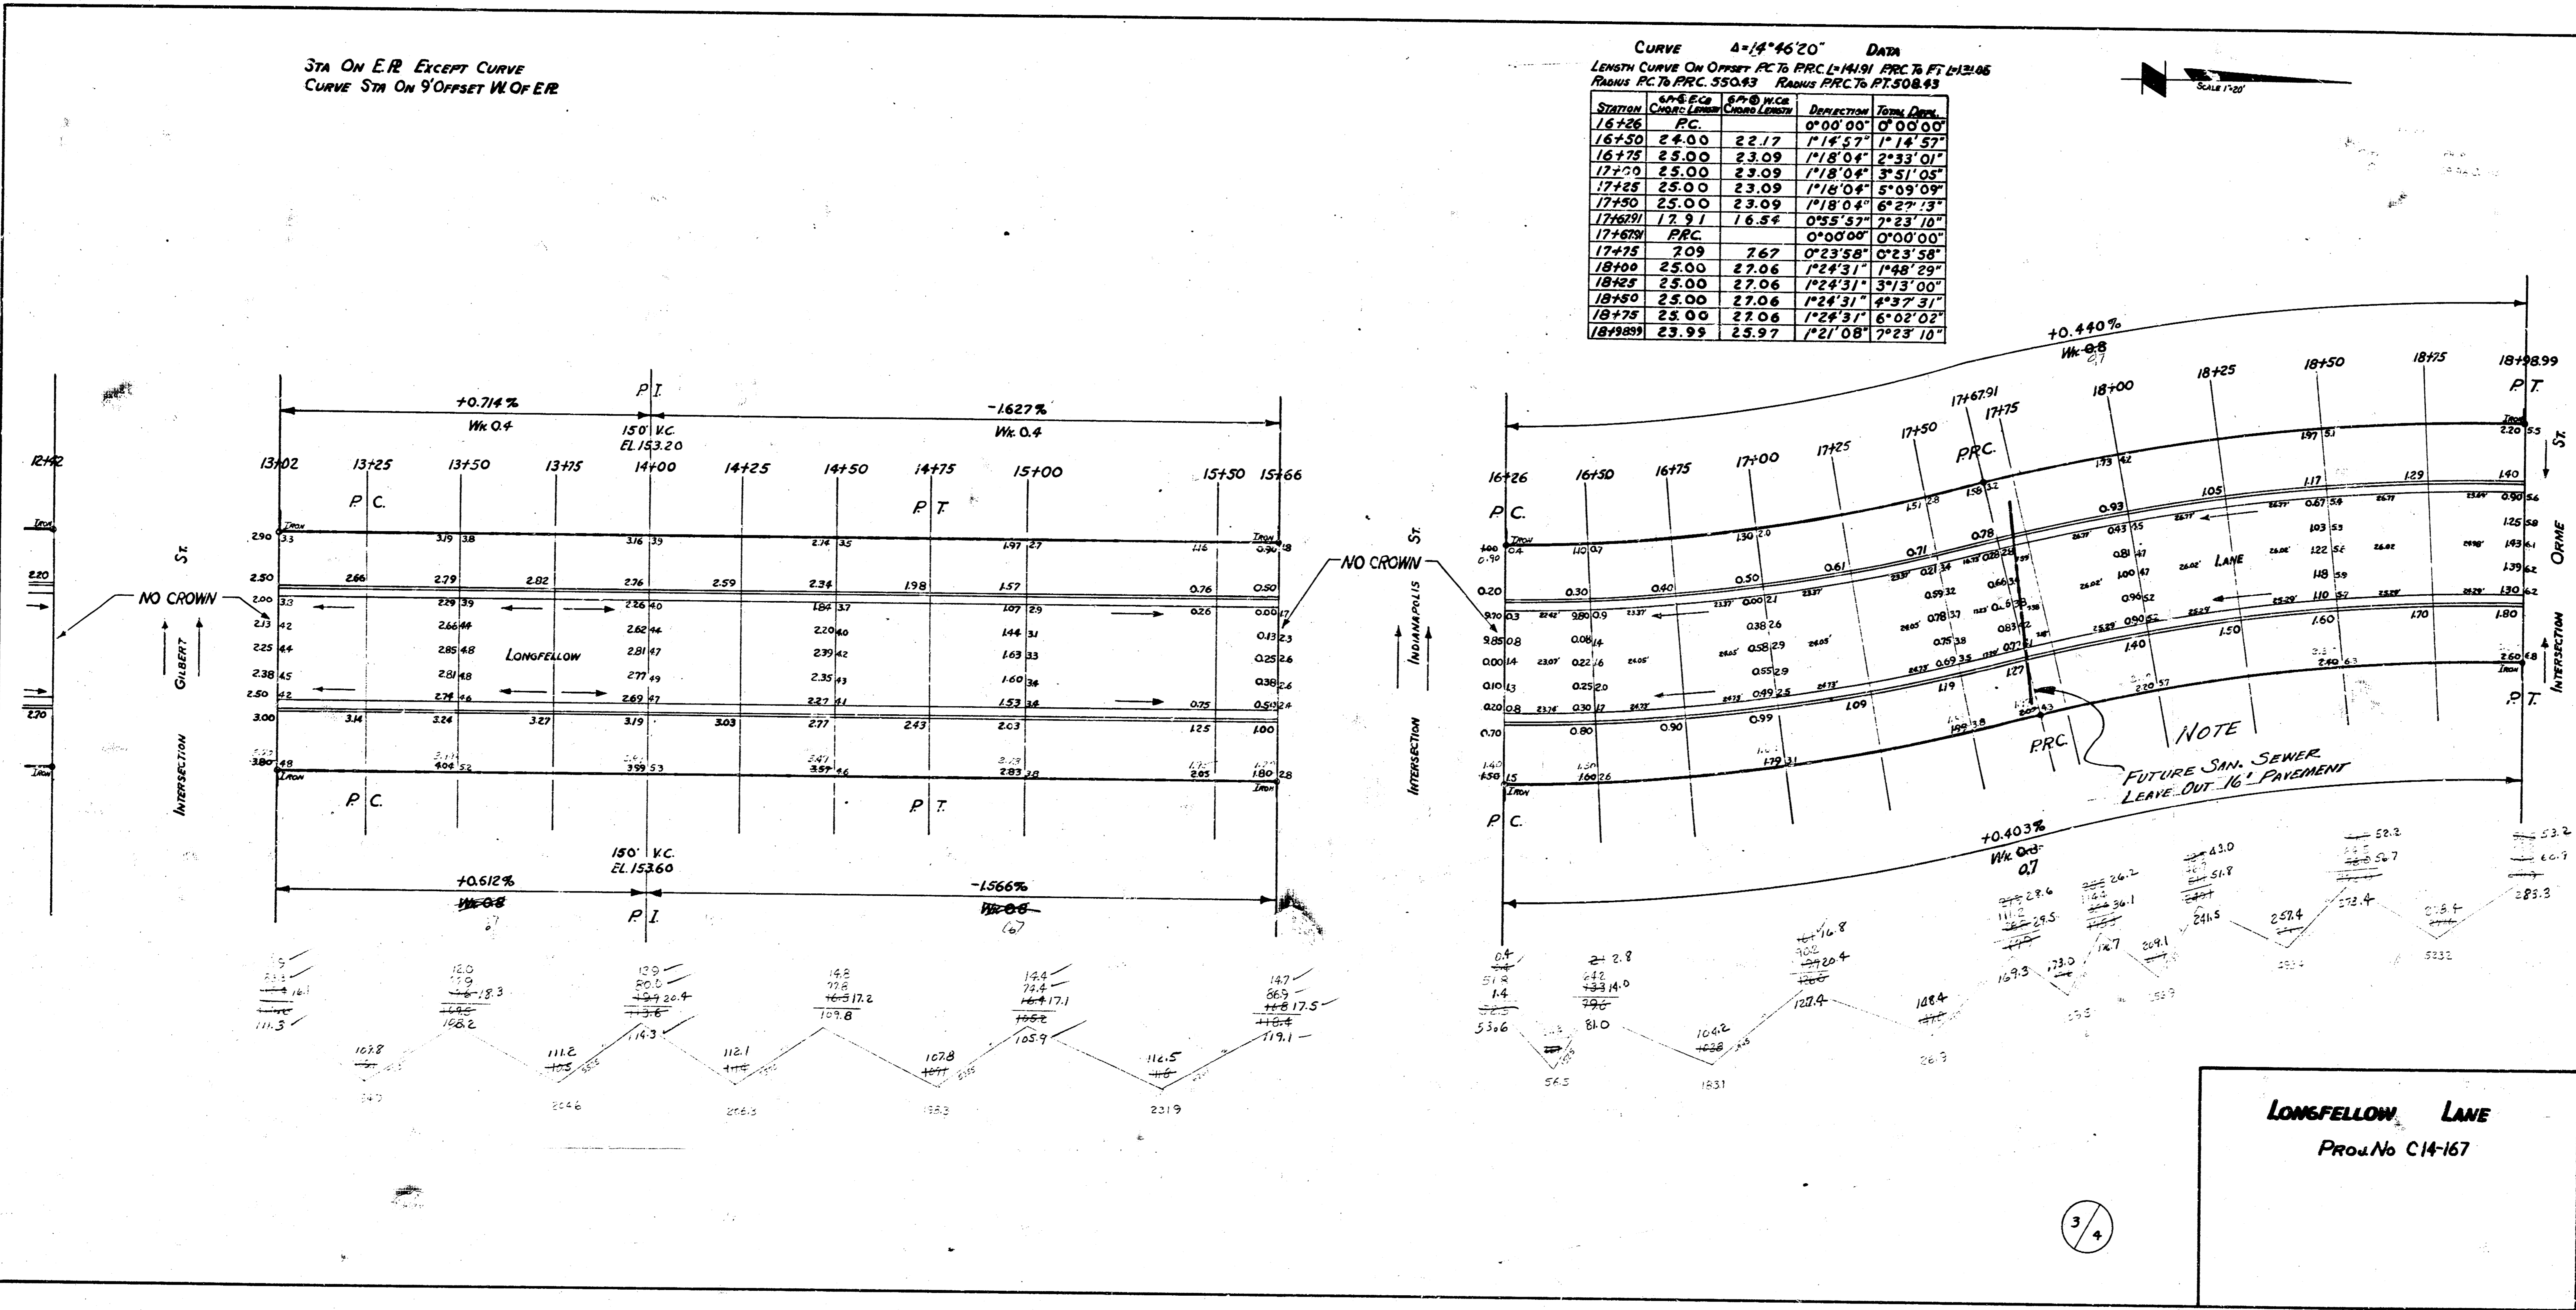


LONGFELLOW LANE
 Proj. No. C14-167

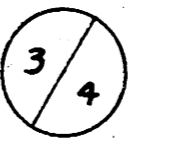

SCALE 1"=20'

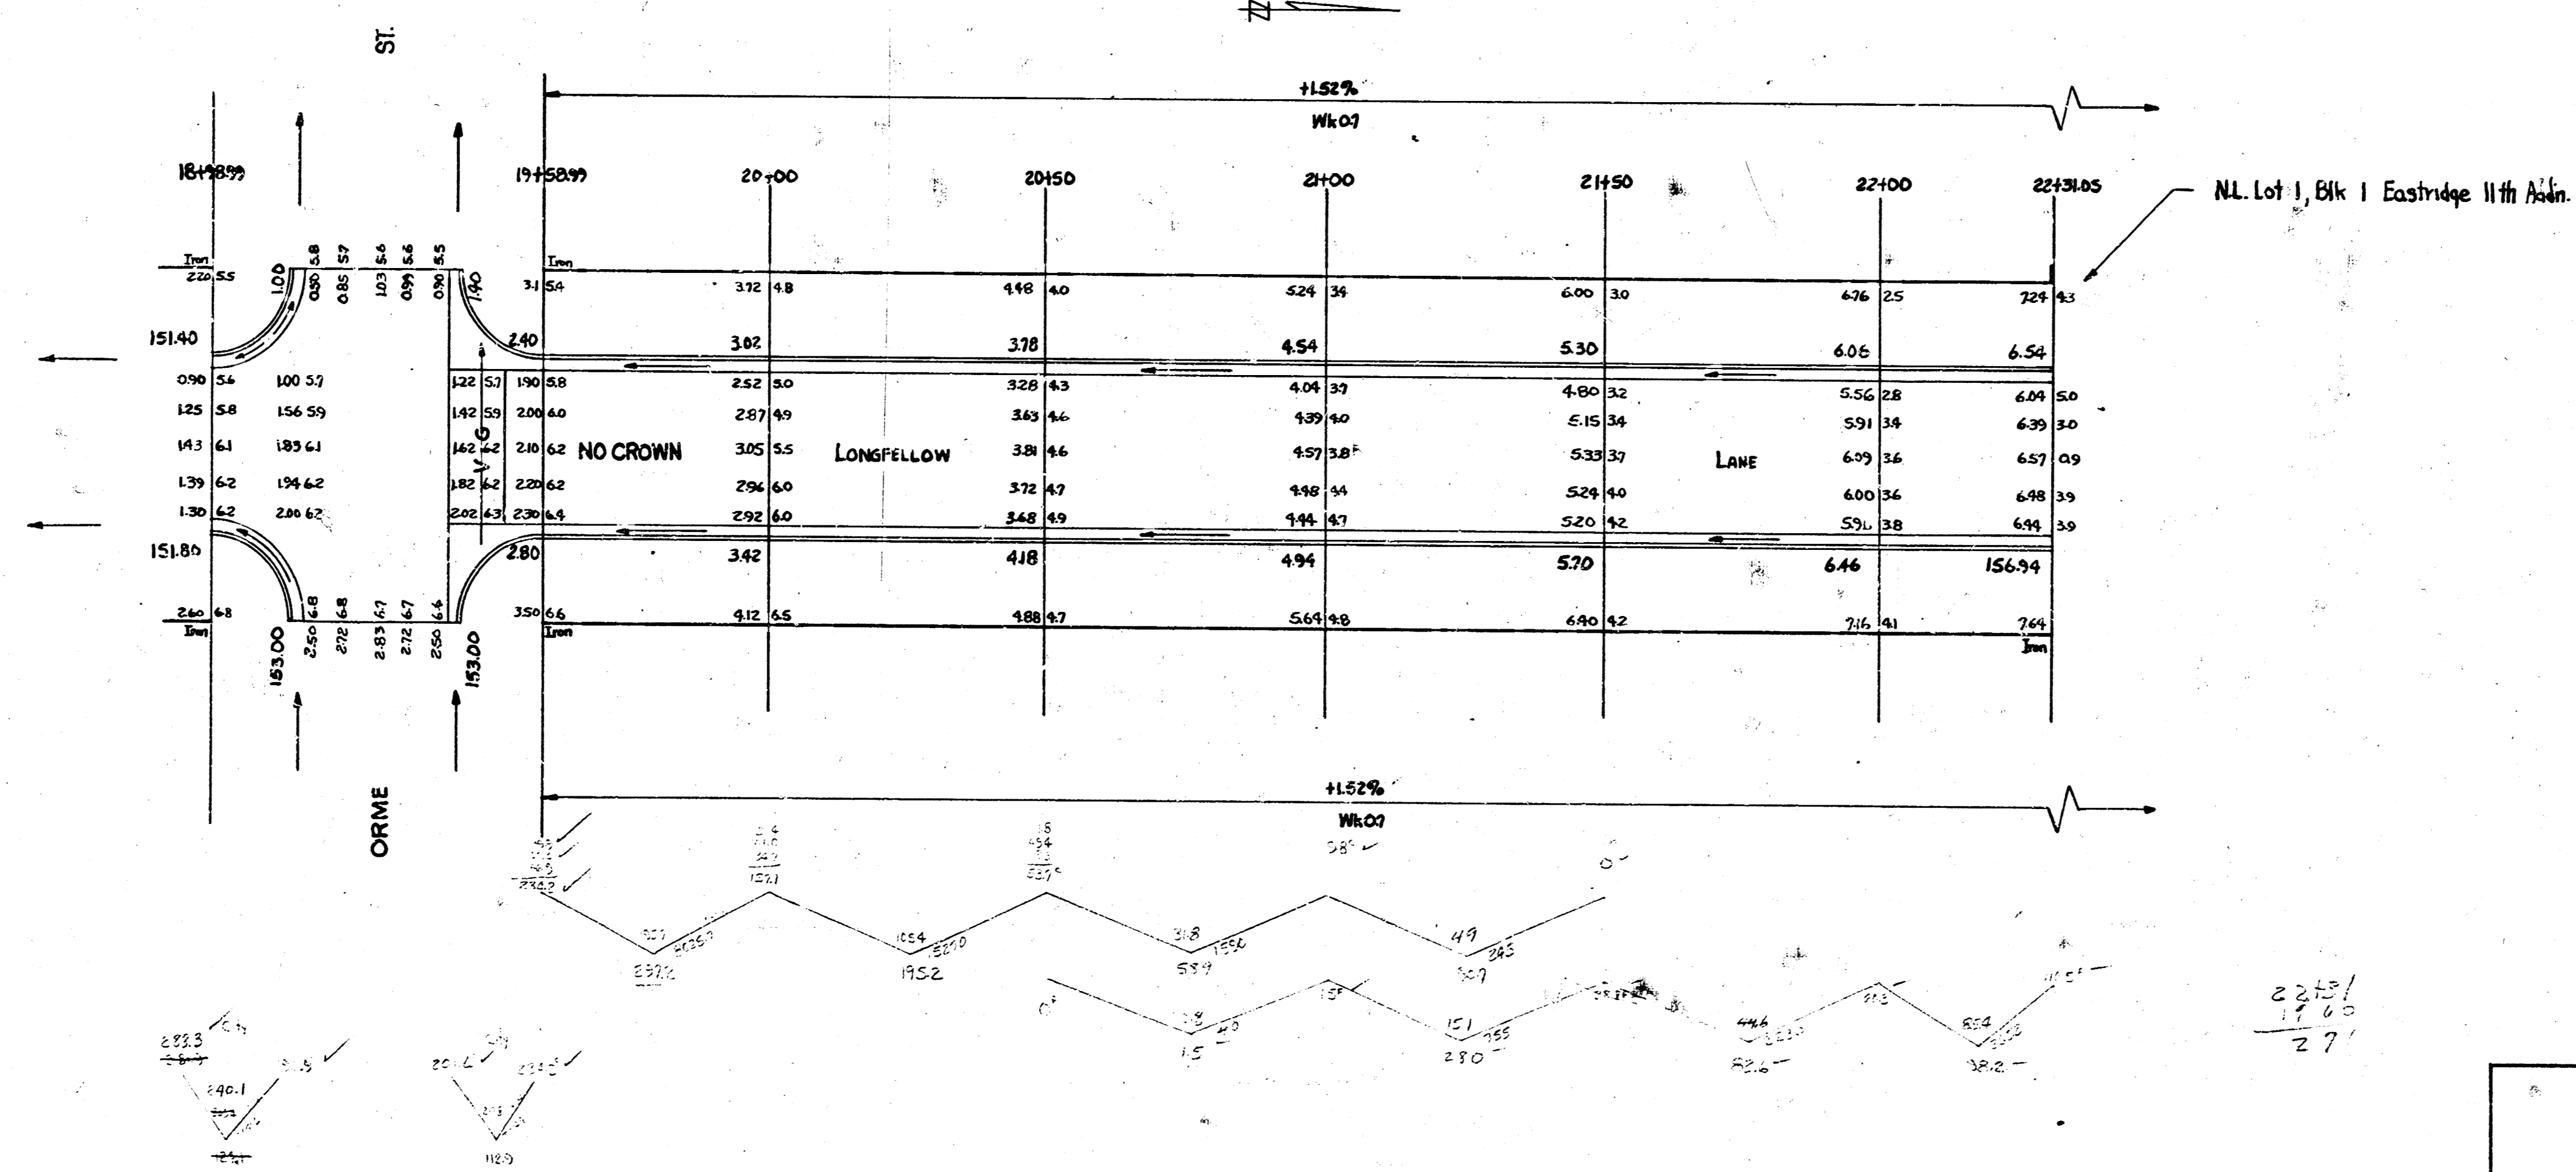

22+31.05 / 17.00 = 2.7

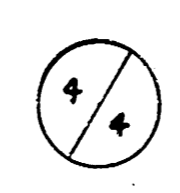

LONGFELLOW LANE
 Proj. No. C 14-167