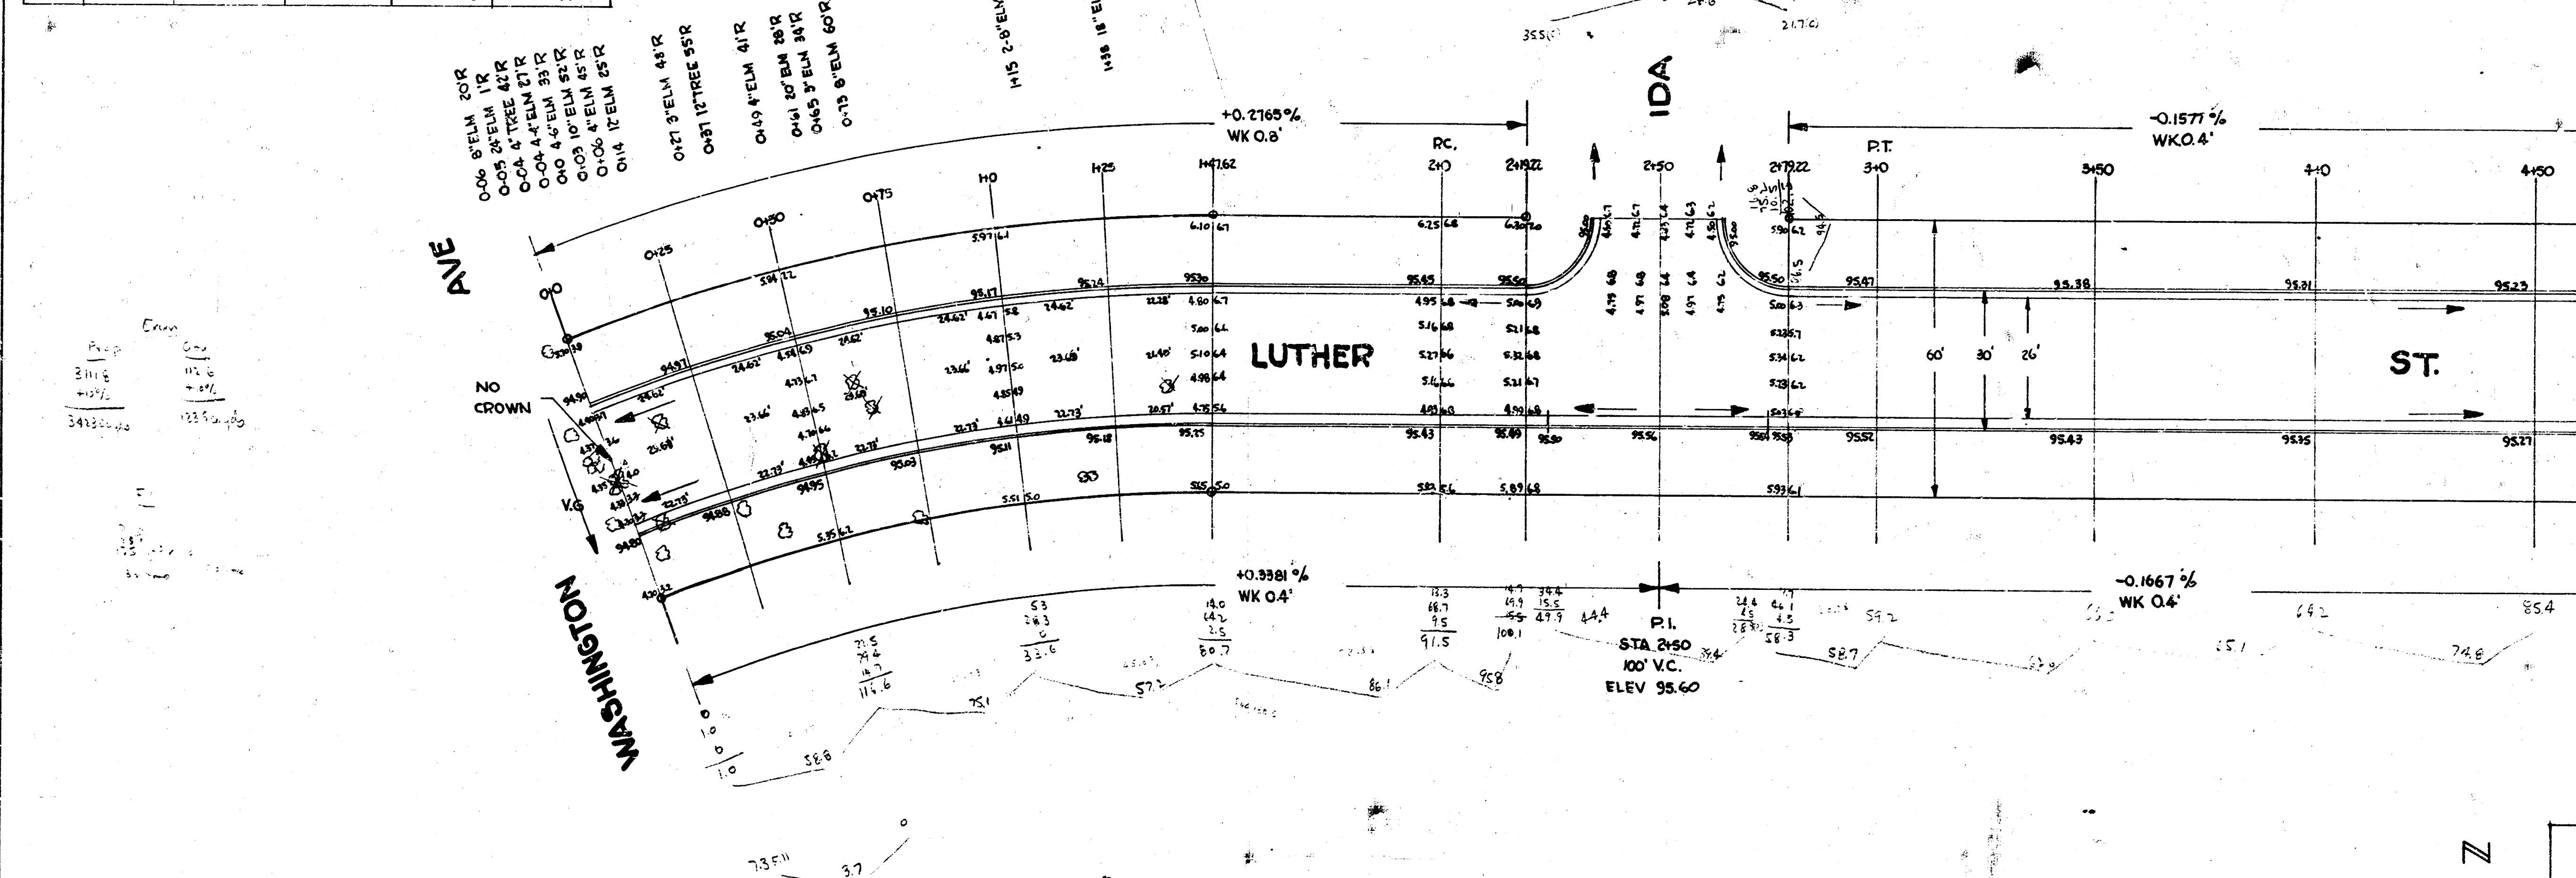



B.M. LARGE NAIL S.S. POWER POLE N.L. GARDEN PARK ADDN 2' WEST OF W.C.B. I.D.A. ELEV 96.38

DATA FOR CURVE: BCT: STA 0+0 TO STA 1+76.2							
STA		CHORD LENGTH	CHORD BEARING	CHORD LENGTH	DEFLECTION ANGLE	TOTAL ANGLE	DEFLECTION
CHORD NCB		CHORD NCB	CHORD NCB	CHORD NCB	CHORD NCB	CHORD NCB	CHORD NCB
0+00							
0+25	25'	24.99'	22.95'	1° 48' 19"	1° 48' 19"		
0+50	50'	24.99'	22.95'	1° 48' 19"	3° 36' 38"		
0+75	75'	24.99'	22.95'	1° 48' 19"	5° 24' 57"		
1+00	100'	24.99'	22.95'	1° 48' 19"	7° 13' 16"		
1+25	125'	24.99'	22.95'	1° 48' 19"	9° 0' 35"		
1+49.2	22.62'	22.62'	80.13'	P 36° 09' 00"	80° 39' 26"		

 $\frac{1}{3}$

LUTHER ST.
E.L. WASHINGTON TO W.L. PATTIE
26-2-30 ASPH. CONC.
CITY OF WICHITA, KANSAS
B.E. SMITH CITY ENGINEER
MAR 1954 PROJ. NO. C13-269

B.M. N.E. COR. CONC. POST ON NW 1/4 1231 LUTHER (S.E. COR. LUTHER & PATTIE) ELEV 94.48

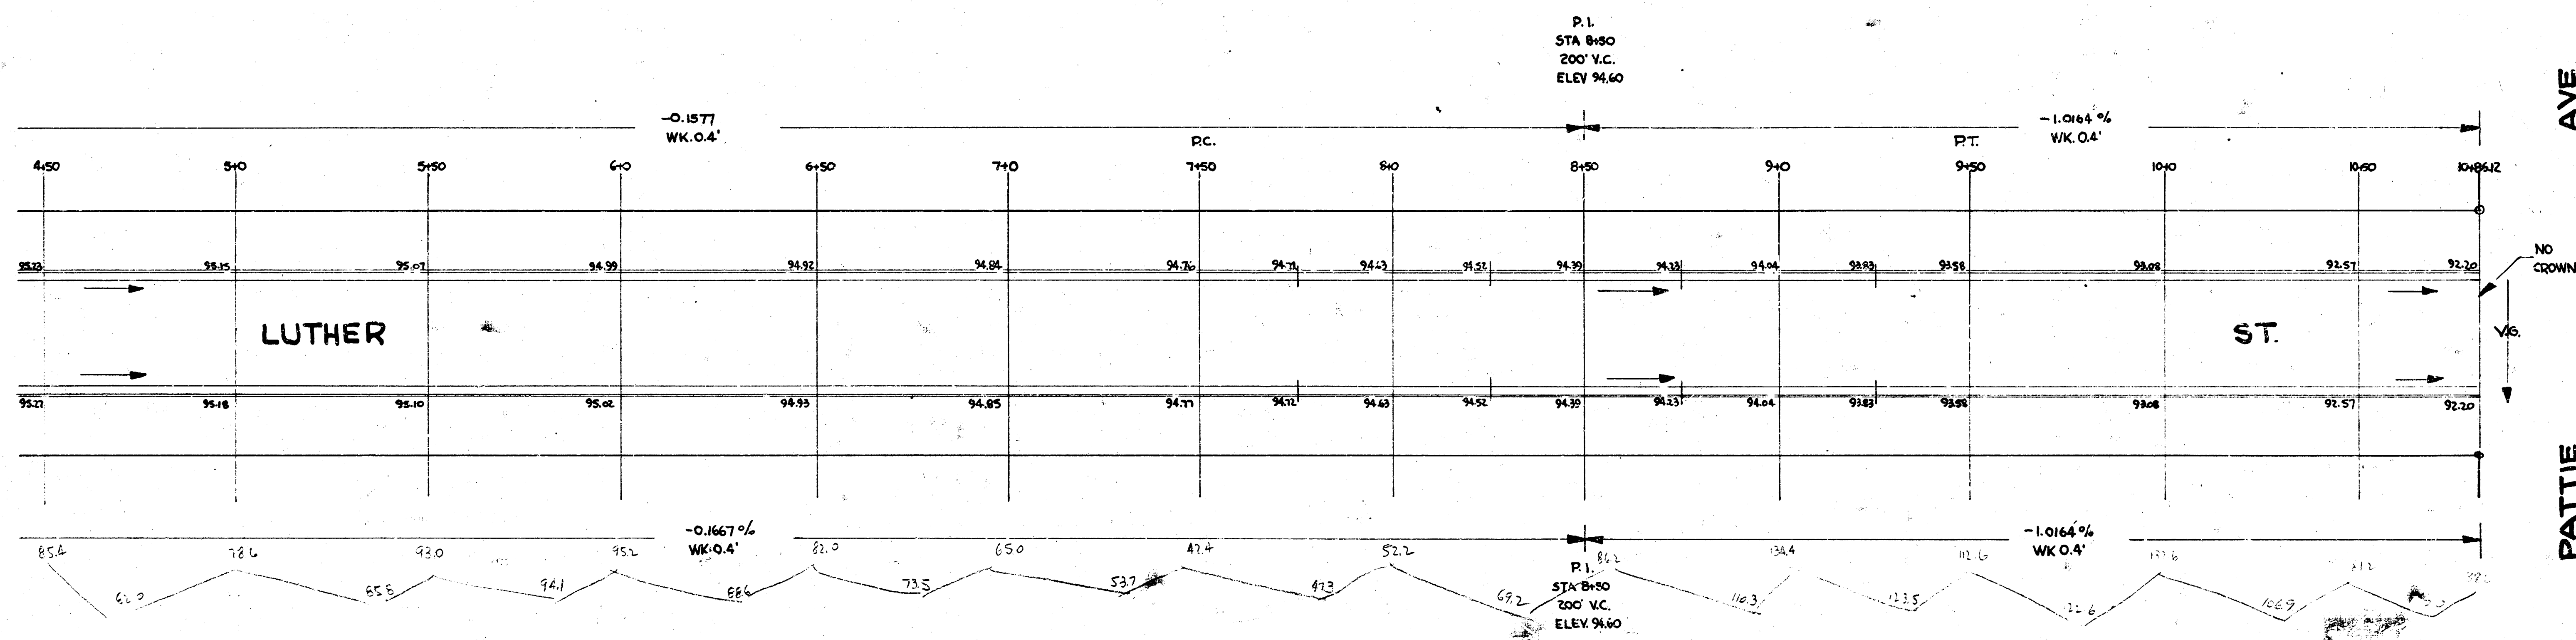

N

LUTHER ST.

PROJ. NO. C13-269