Lewis Ave – El. Glendale to W.L. Bleckley

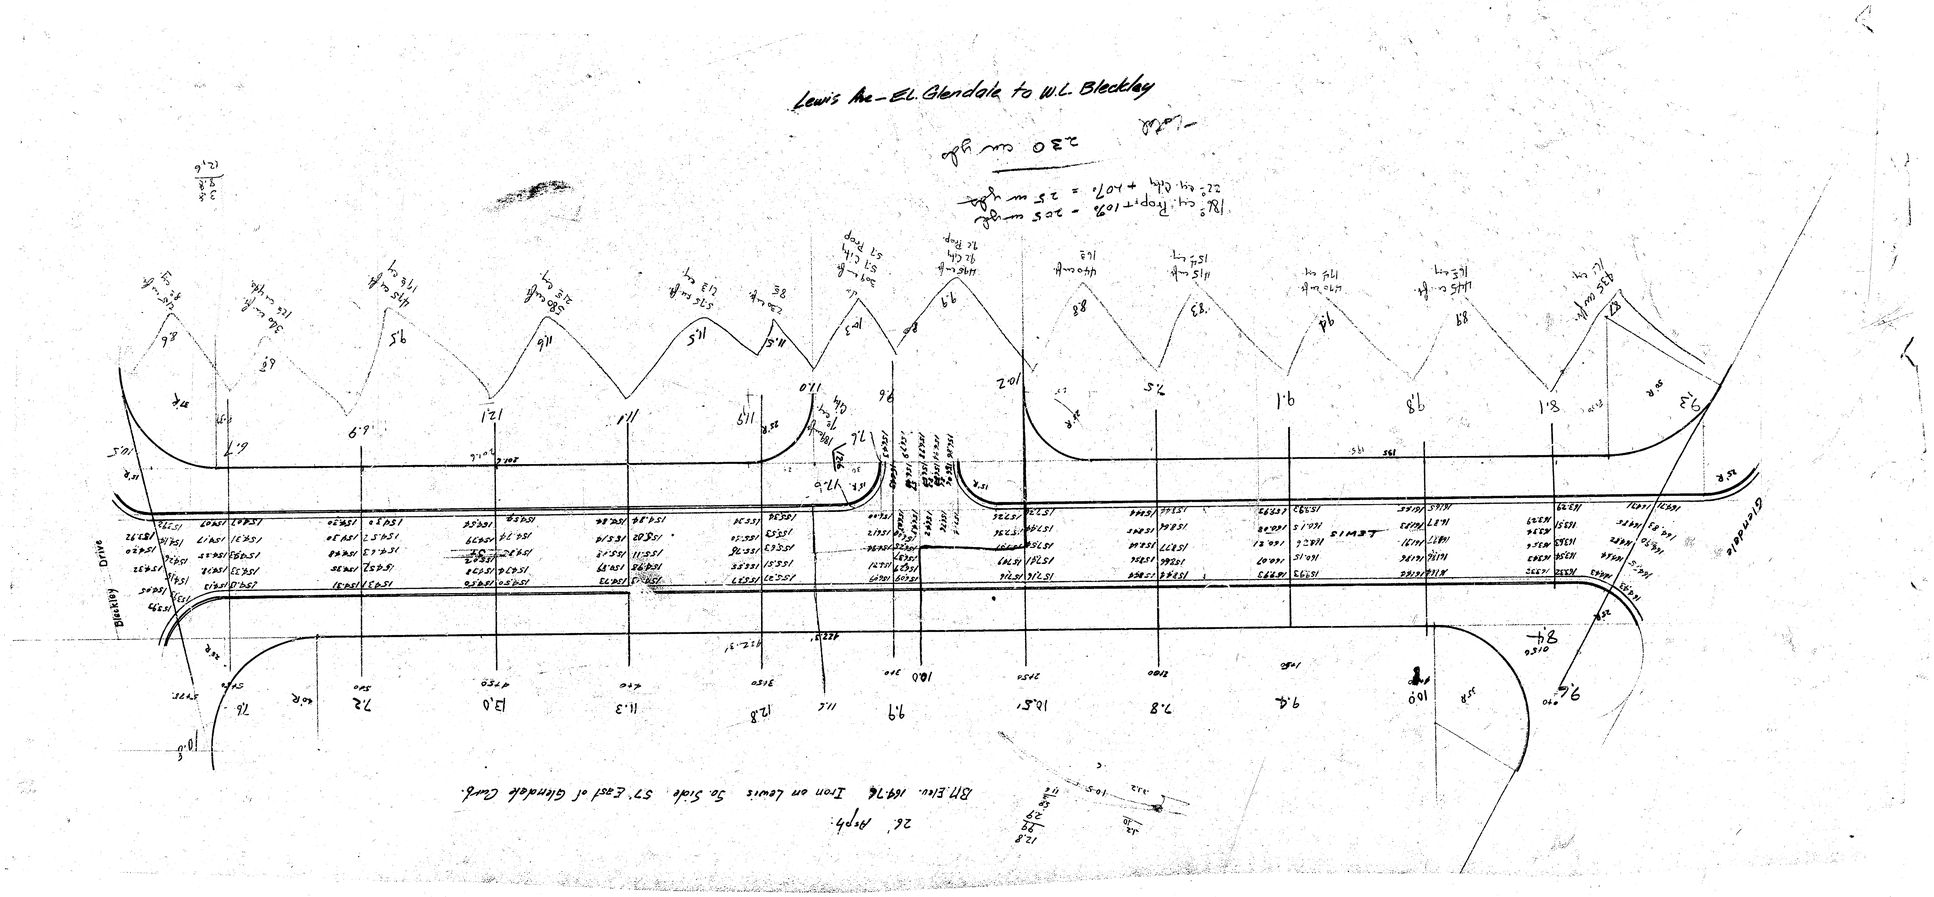

2.30 cu yds

Lewis