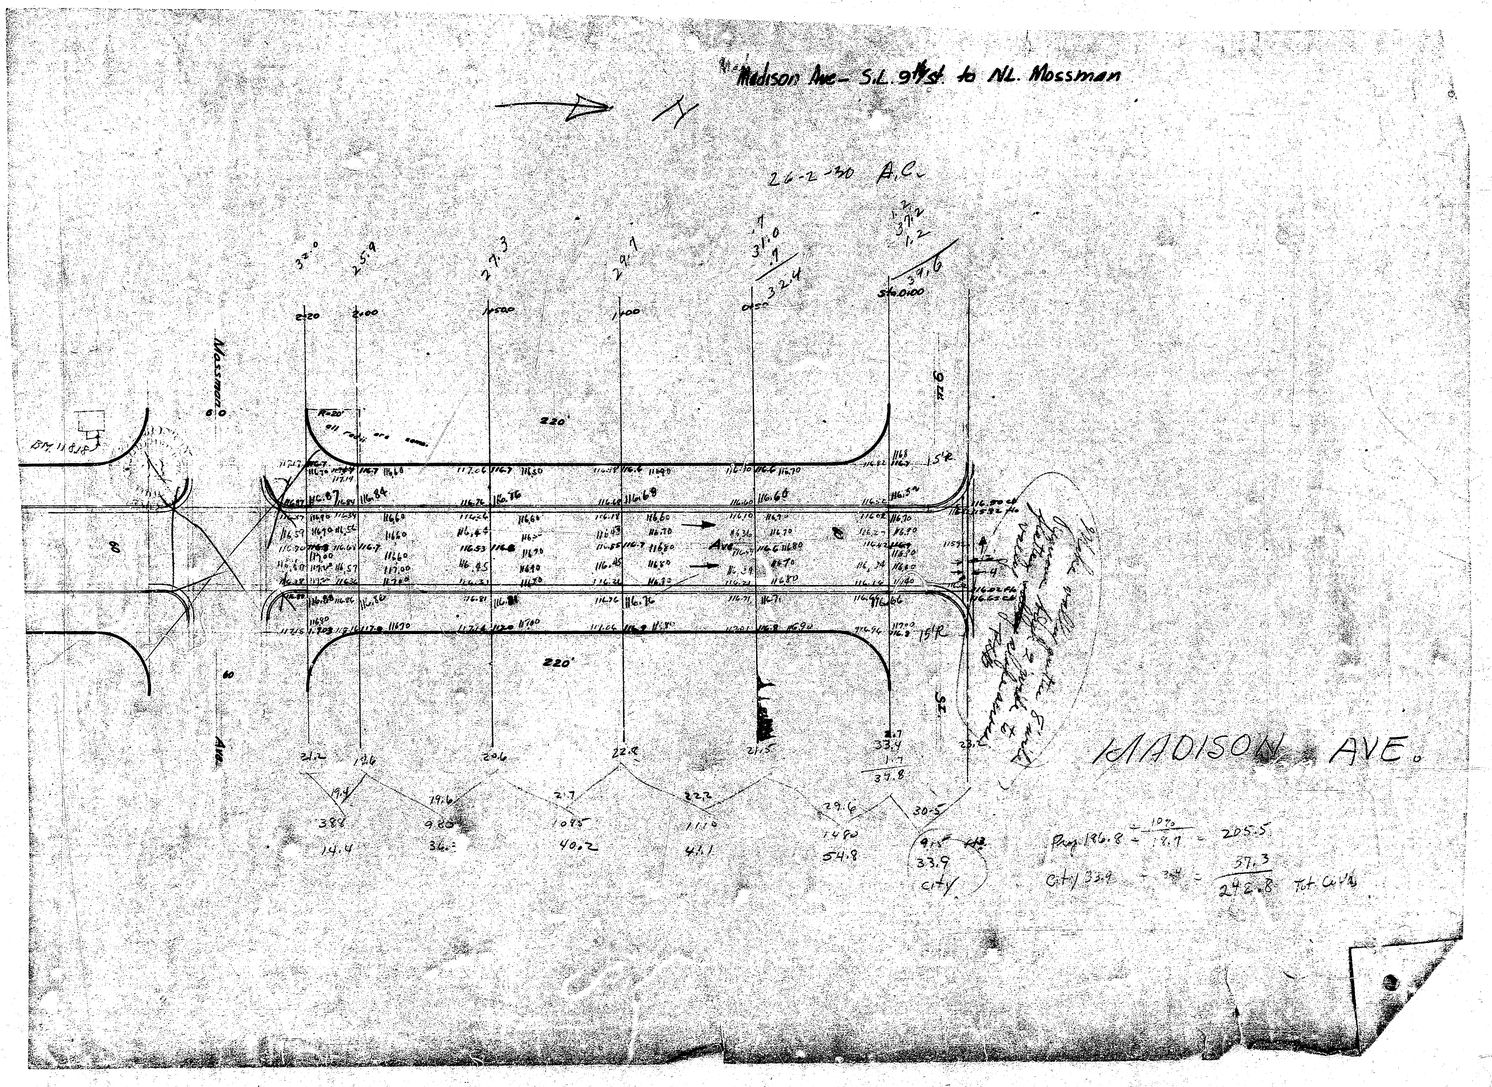Madison Ave – S.L. 9th St. to N.L. Mossman