

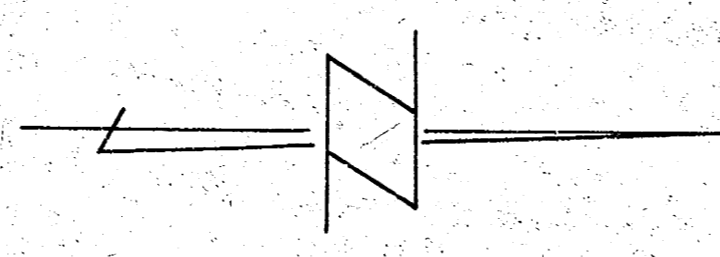


BM: 10021 "M" in Mueller Fire Hyd. NW cor. Levy & Madison.

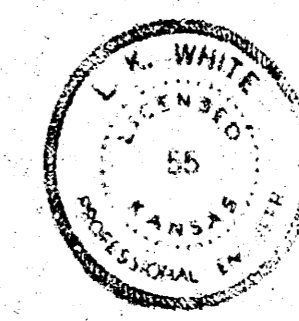


SCALE 1"=20'

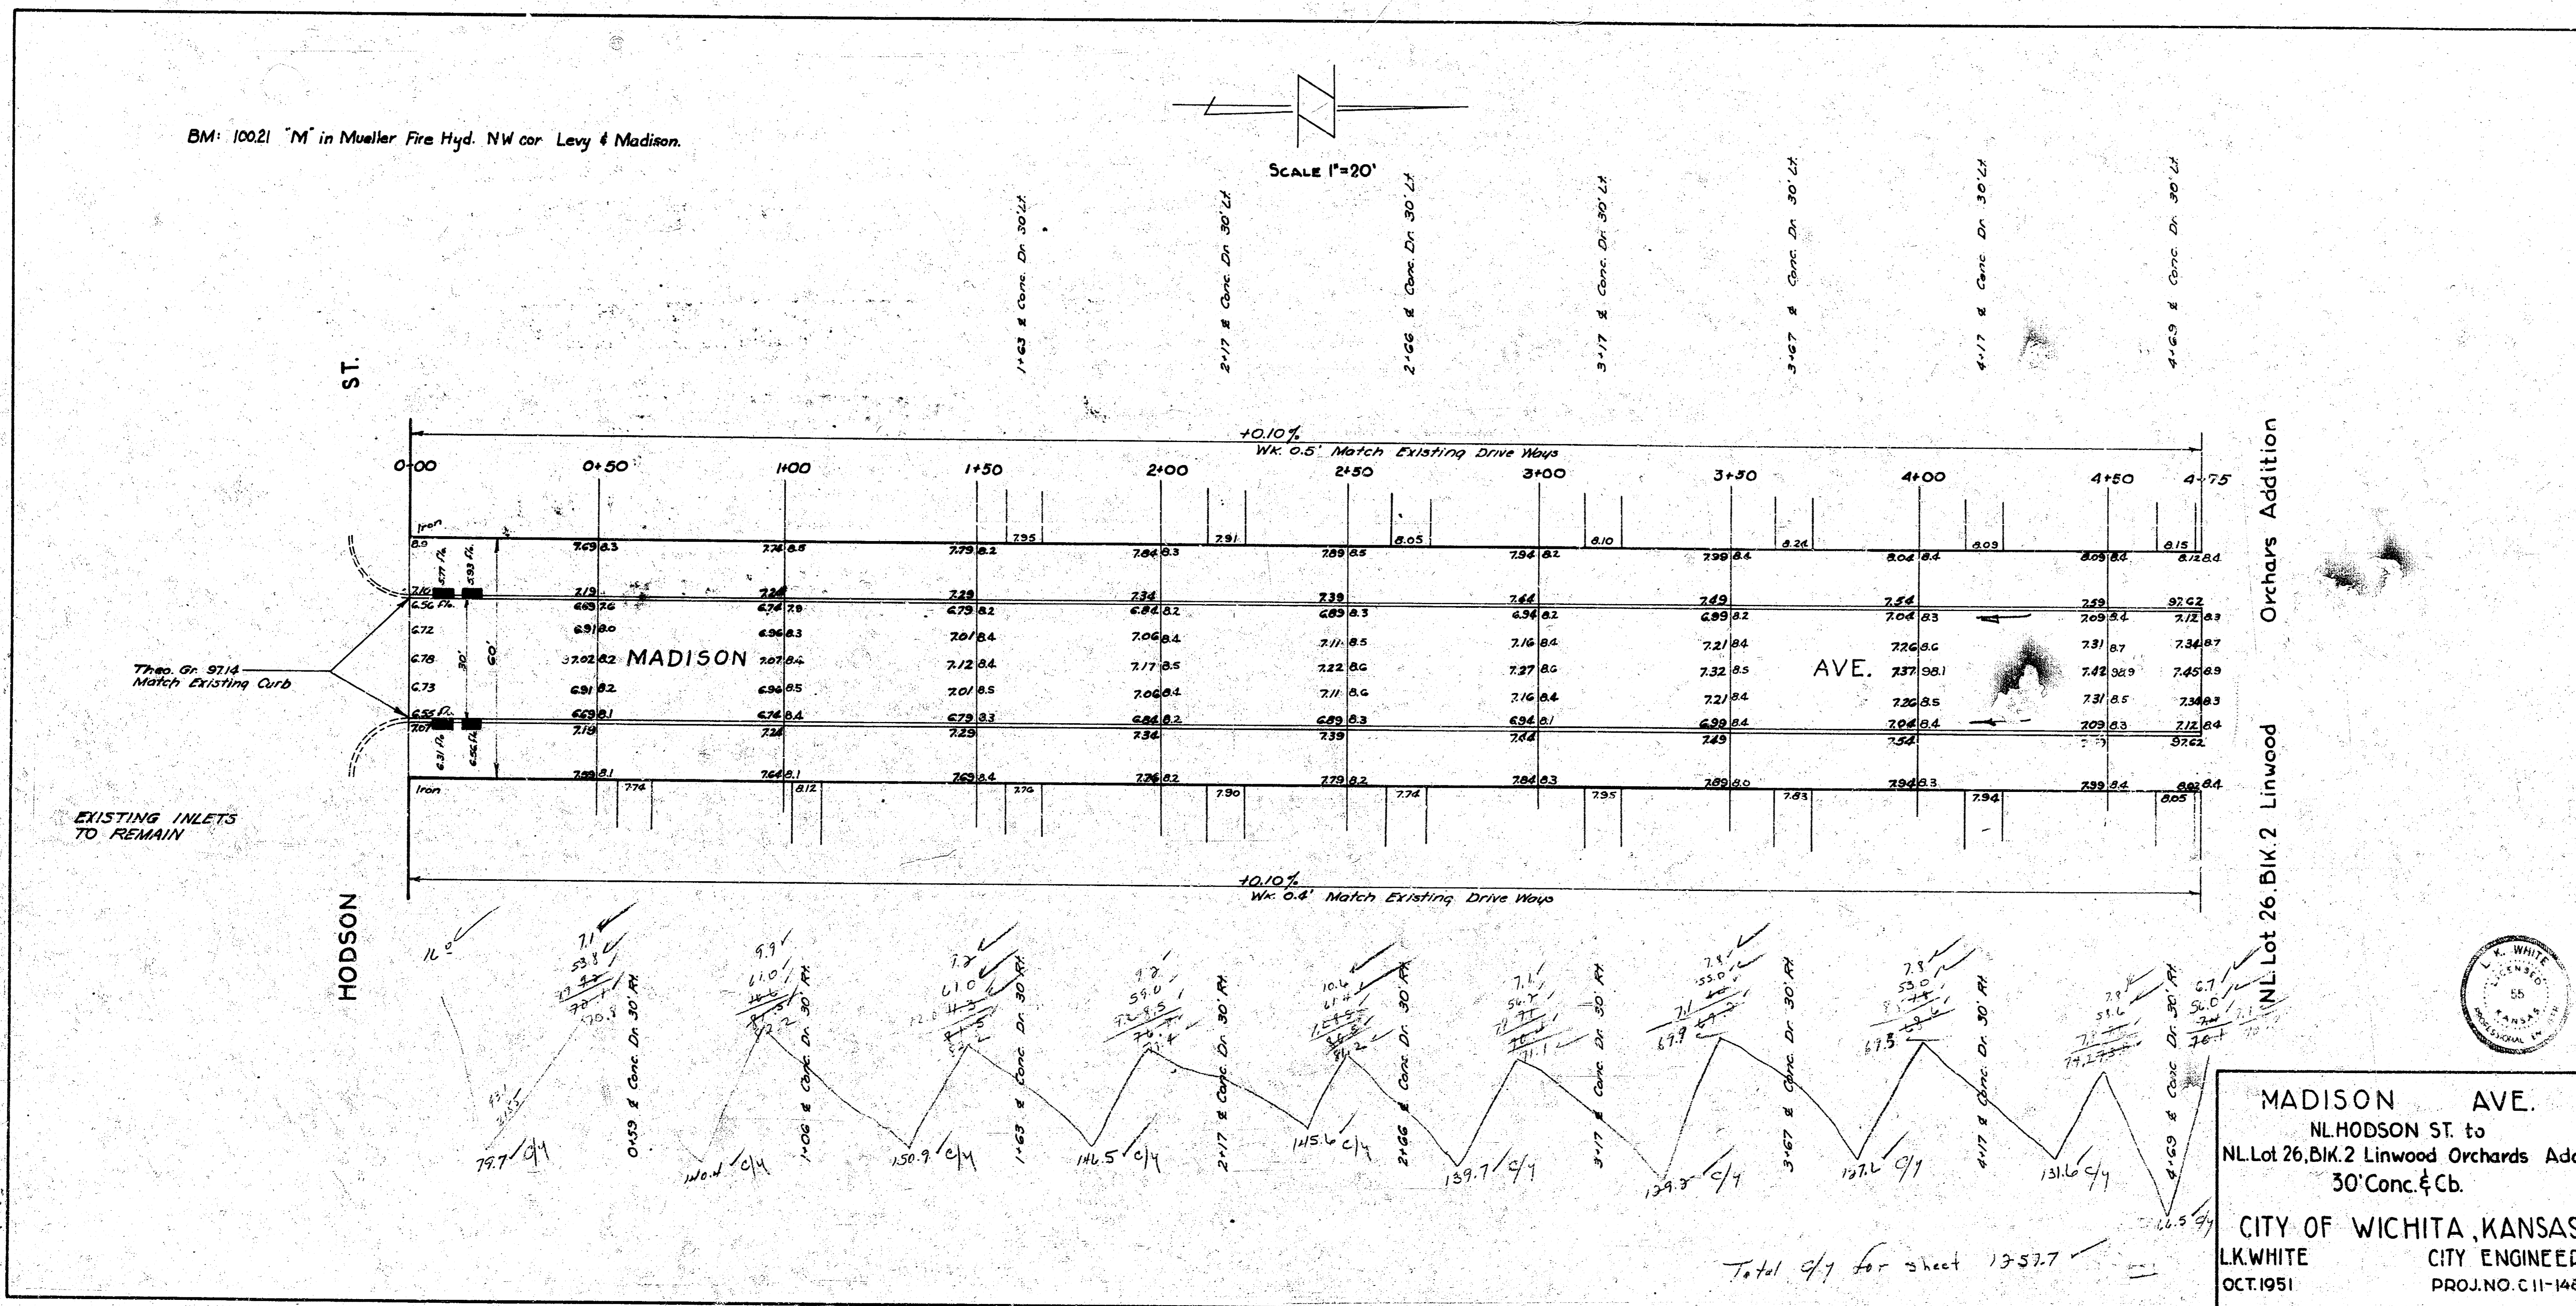

MADISON AVE.
 NL Lot 26, Bk. 2 Linwood Orchards Addn
 30' Conc. & Cb.
 CITY OF WICHITA, KANSAS
 LK WHITE
 CITY ENGINEER
 OCT. 1951

Total 4/7 for sheet 13-57.7

S-4

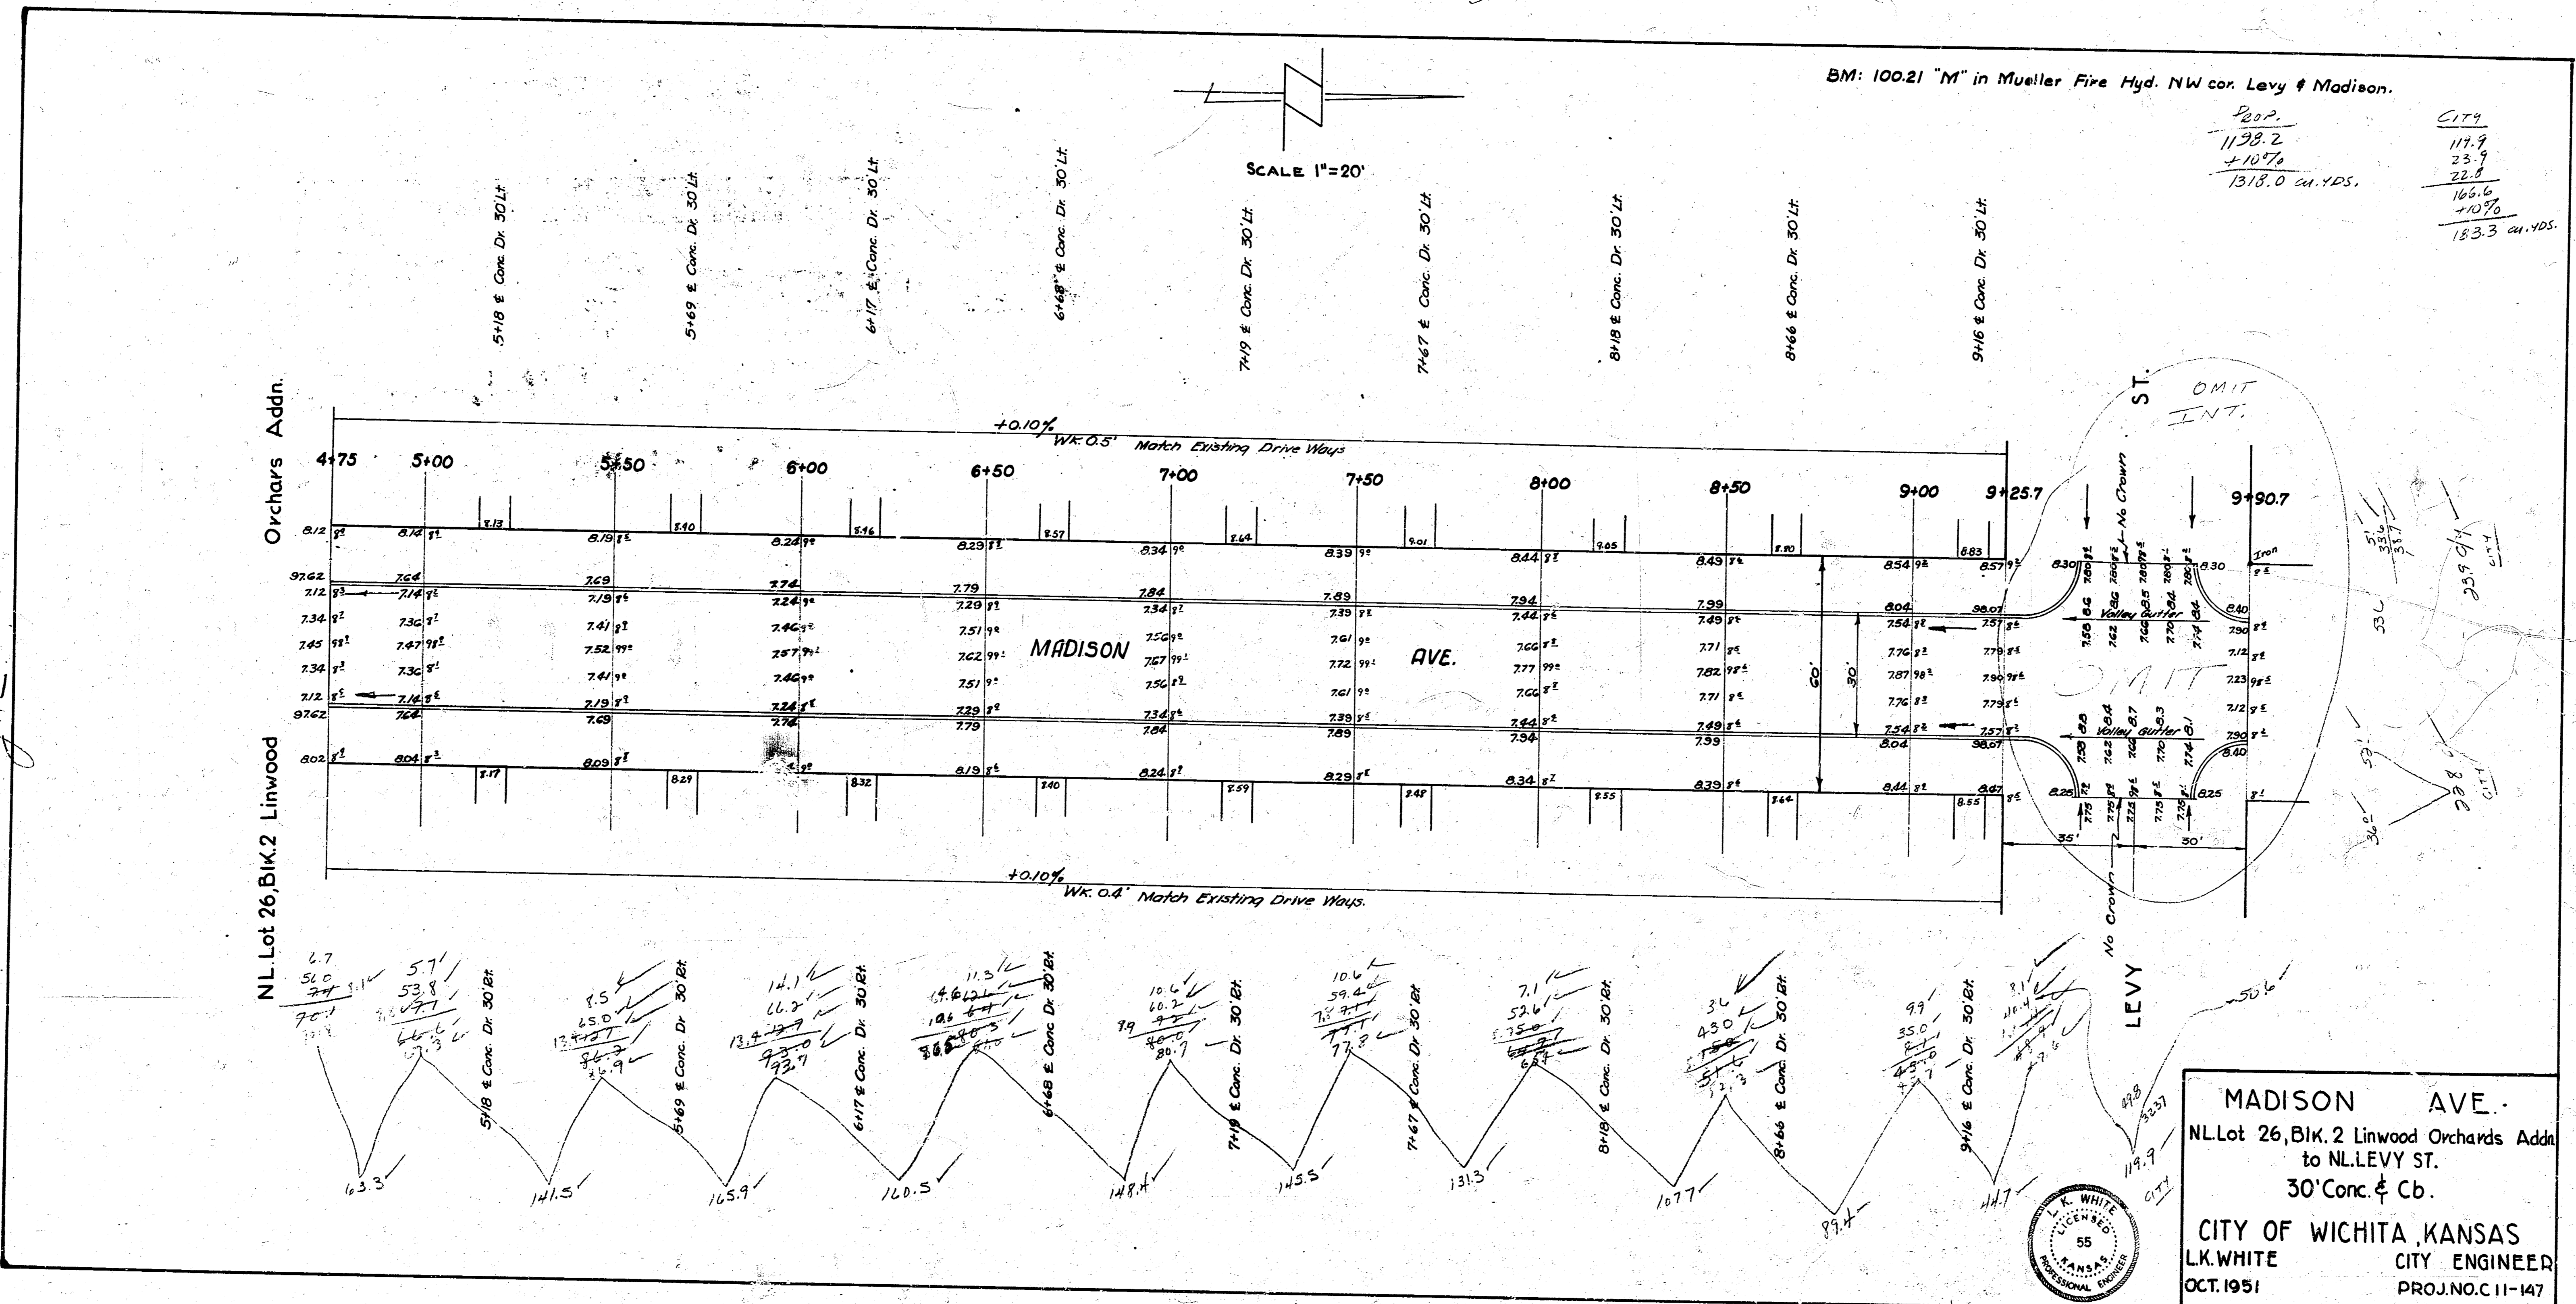

Preliminary Survey - Bl. S-4, S-5 - 1/15/51
 Original Plan - 1/15/51

