


# TWENTY-FIRST STREET BRIDGE

OVER THE

## BIG ARKANSAS RIVER

CITY OF WICHITA

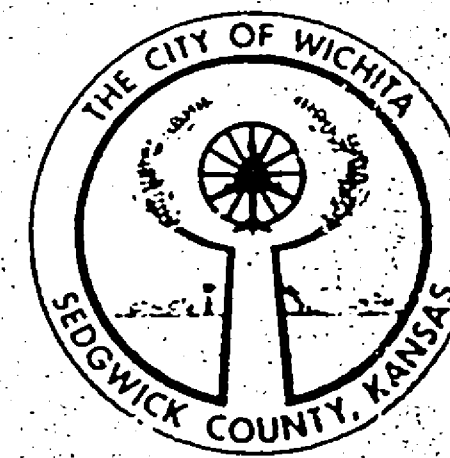

A. PRICE WOODARD JR., MAYOR

WALTER M. KEELER

DONALD K. ENOCH

JACK H. GREENE

JOHN S. STEVENS

COMMISSIONERS

RALPH WULZ, CITY MANAGER

### DEPARTMENT OF PUBLIC WORKS

R. W. BRUGGEMAN, P.E. DIRECTOR OF PUBLIC WORKS

BILL E. SMITH, P.E. CITY ENGINEER

R. S. DELAMATER & ASSOCIATES, WICHITA, CONSULTING ENGINEERS

PROJECT C10-51

DECEMBER, 1970

#### INDEX OF SHEETS

- 1 Title Sheet
- 2 Contour Map
- 3 Plan-Profile
- 4 Construction Layout
- 5 Abutment Plan
- 6 Abutment Reinforcing
- 7 Pier Details
- 8 Deck Sections
- 9 Superstructure Plan
- 10 Superstructure and Sidewalk Details
- 11 Handrail Details
- 12 Structural Steel Details and Bearing Devices
- 13 Weir Details
- 14 Auxiliary Details and Summary of Quantities
- 15 Bar List and Bending Diagrams

J:\Civil\04223\Original bridge plans\Sheet 1.dwg 06/01/2007 04:00:26 PM CST

CITY OF WICHITA, KANSAS  
B.E. SMITH, P.E. CITY ENGINEER

TWENTY-FIRST STREET BRIDGE OVER  
THE BIG ARKANSAS RIVER

EXISTING BRIDGE PLANS

PROJECT C 10-51 AS-BUILT  
NOVEMBER 1972