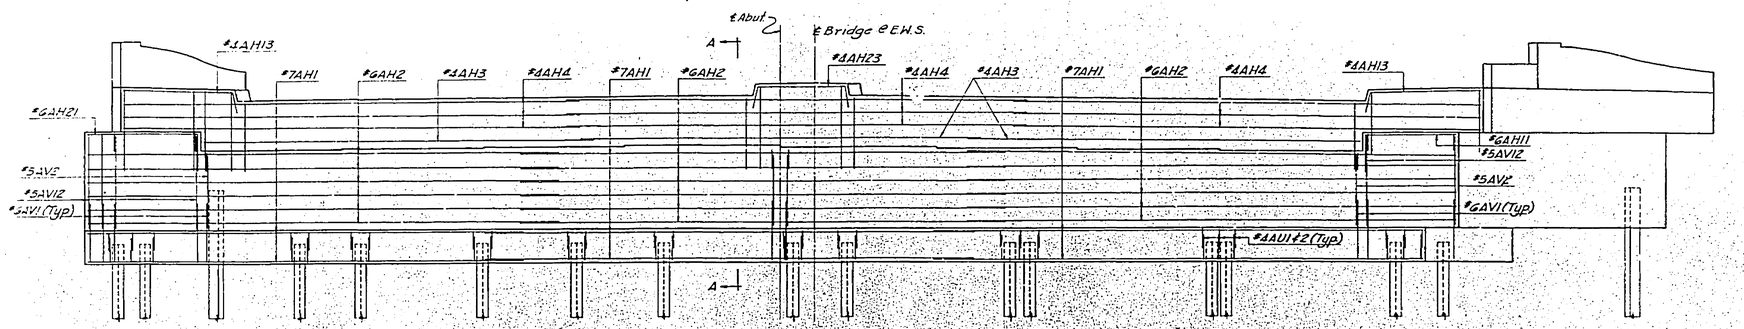

ELEVATION

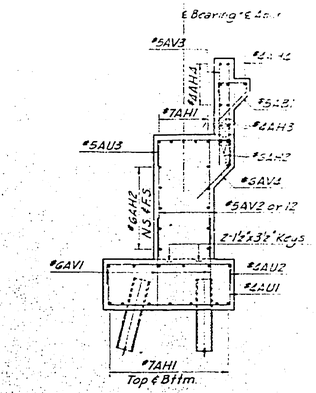

SECTION A-A

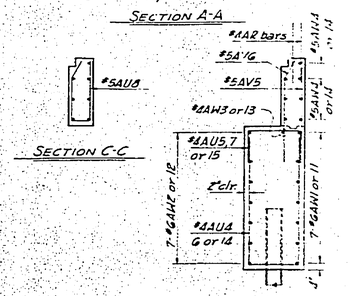

SECTION C-C

SECTION B-B

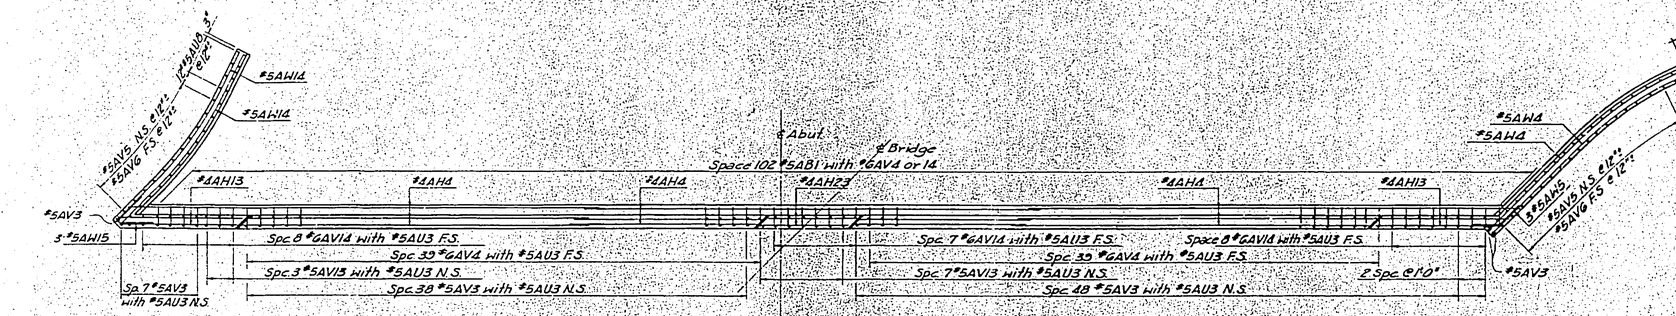

PLAN OF BACKWALL

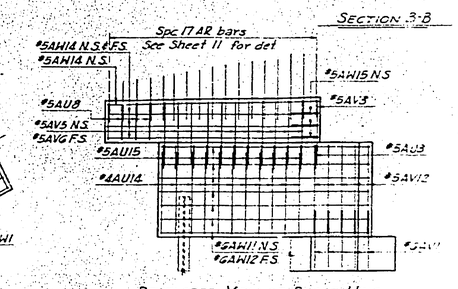

DEVELOPED VIEW OF SHORT WING

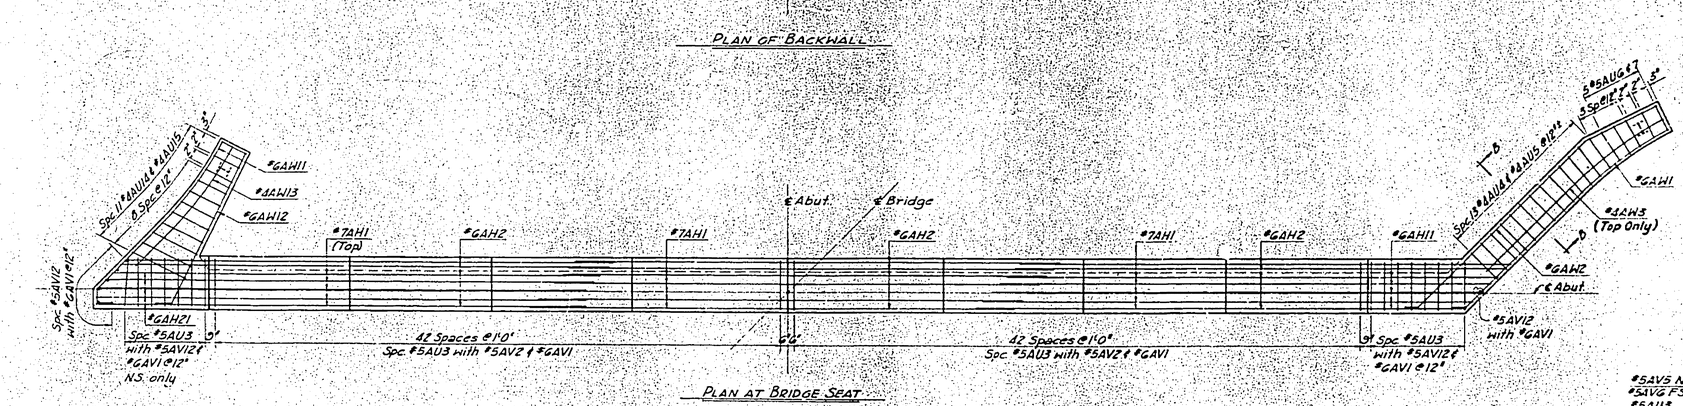

PLAN AT BRIDGE SEAT

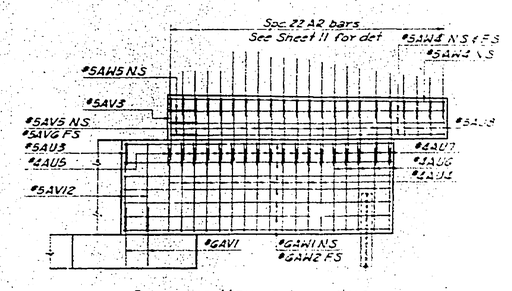

DEVELOPED VIEW OF LONG WING

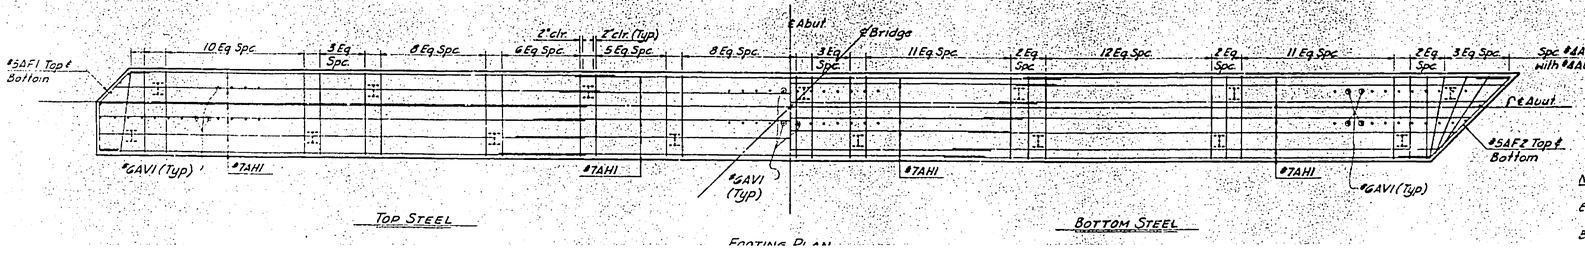

TOP STEEL

BOTTOM STEEL

FOOTING PLAN

Note
See Sheet 5 for Dimensions and Elevations.
See Sheet 15 for Bar List and Bending Diagram.

J:\Civil\04223\Original bridge plans\Sheet 6.dwg 06/01/2007 04:10:29 PM CST

CITY OF WICHITA, KANSAS
B.E. SMITH, P.E. CITY ENGINEER

TWENTY—FIRST STREET BRIDGE OVER
THE BIG ARKANSAS RIVER

ABUTMENT DETAILS

PROJECT C 10—51 AS—BUILT
NOVEMBER 1972