Bridge Seat Elevations															
Location	Elev. "A"	Elev. "B"	Elev. "C"	Elev. "D"	Elev. "E"	Elev. "F"	Elev. "G"	Elev. "H"	Elev. "I"	Elev. "J"
Pier #1	1314.72	1312.76	1312.92	1313.08	1313.23	1313.38	1313.20	[illegible]	[illegible]	[illegible]
Pier #2	1315.13	1313.15	1313.29	1313.43	1313.57	1313.53	1313.39	1313.35	1313.[illegible]	[illegible]
Pier #3	1315.33	1313.35	1313.45	1313.57	1313.69	1313.69	1313.57	1313.45	1313.35	[illegible]
Pier #4	1315.30	1313.29	1313.39	1313.49	1313.59	1313.57	1313.43	1313.29	1313.[illegible]	[illegible]
Pier #5	1315.06	1313.03	1313.12	1313.20	1313.29	1313.23	1313.05	1312.[illegible]	1312.[illegible]	[illegible]

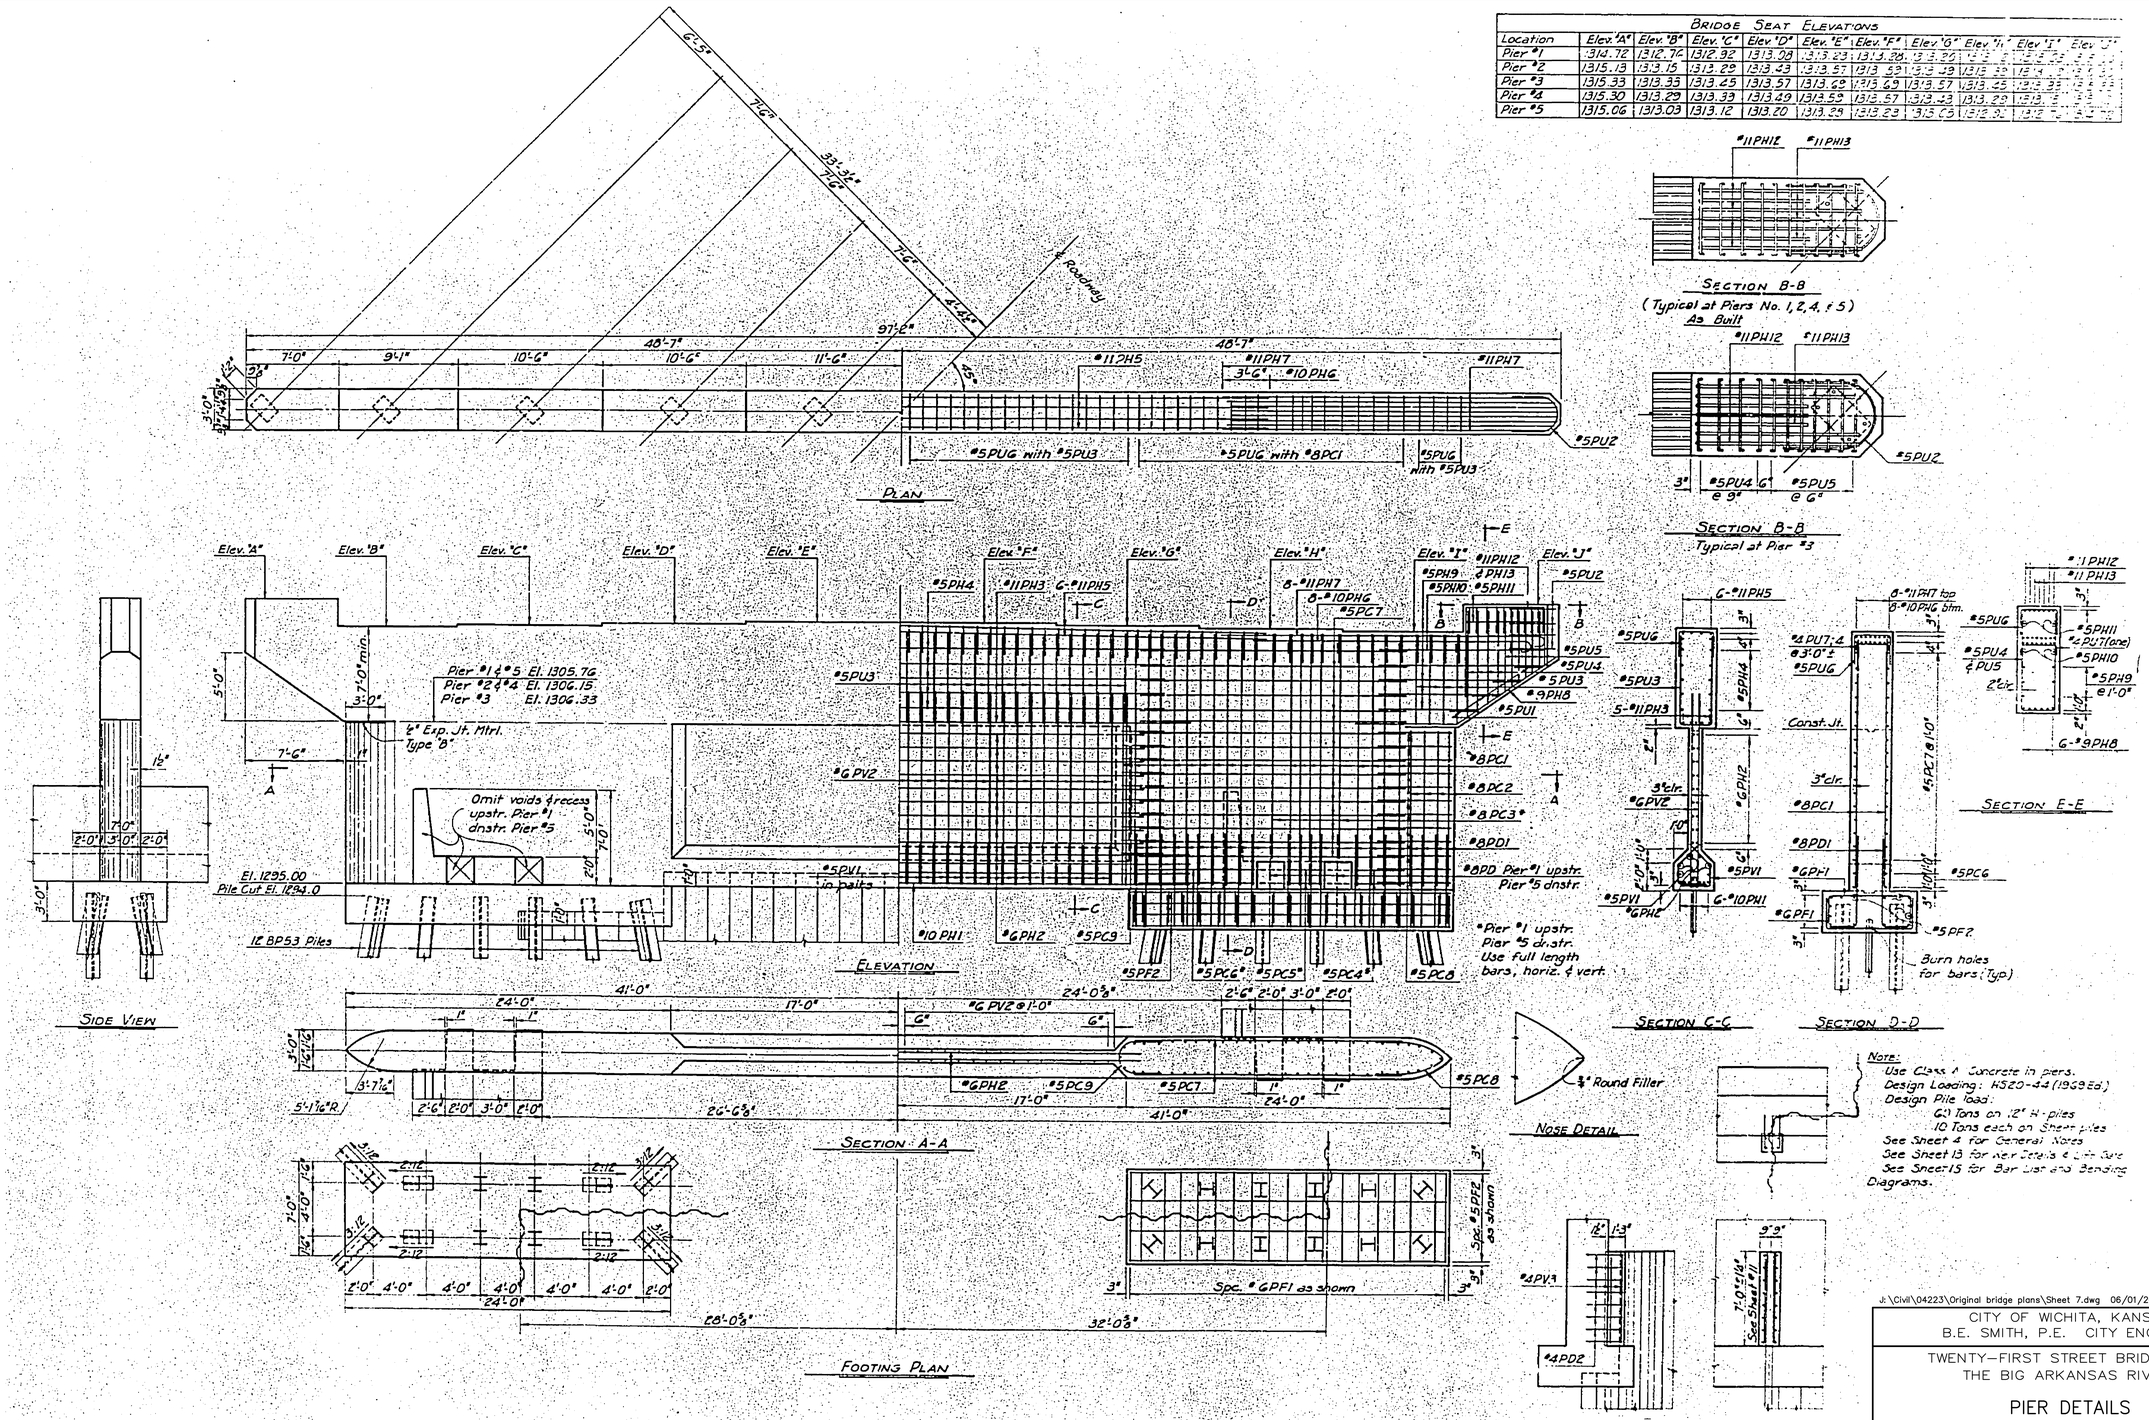

J:\Civil\04223\Original bridge plans\Sheet 7.dwg 06/01/2007 04:11:42 PM CST

CITY OF WICHITA, KANSAS
B.E. SMITH, P.E. CITY ENGINEER

TWENTY–FIRST STREET BRIDGE OVER
THE BIG ARKANSAS RIVER

PIER DETAILS

PROJECT C 10–51 AS–BUILT
NOVEMBER 1972