
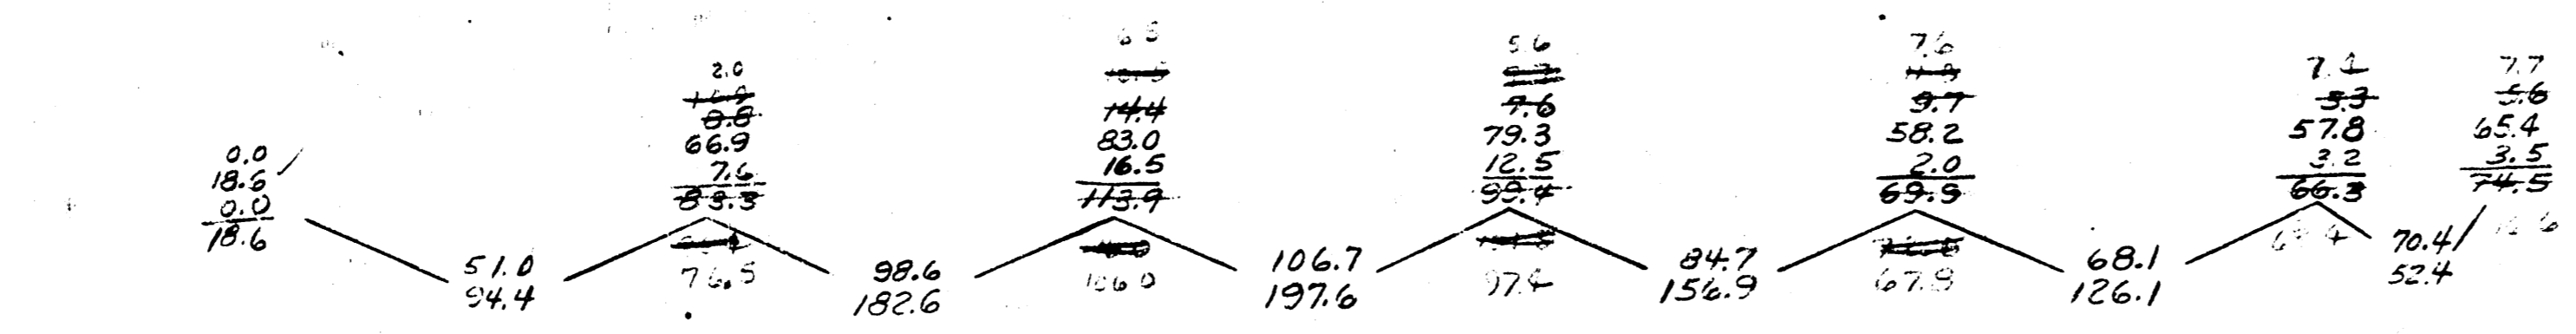


B.M. 188.49 RR Spike S.S. HLP N.S. Cresthill
150' W. of W.L. Brookfield.

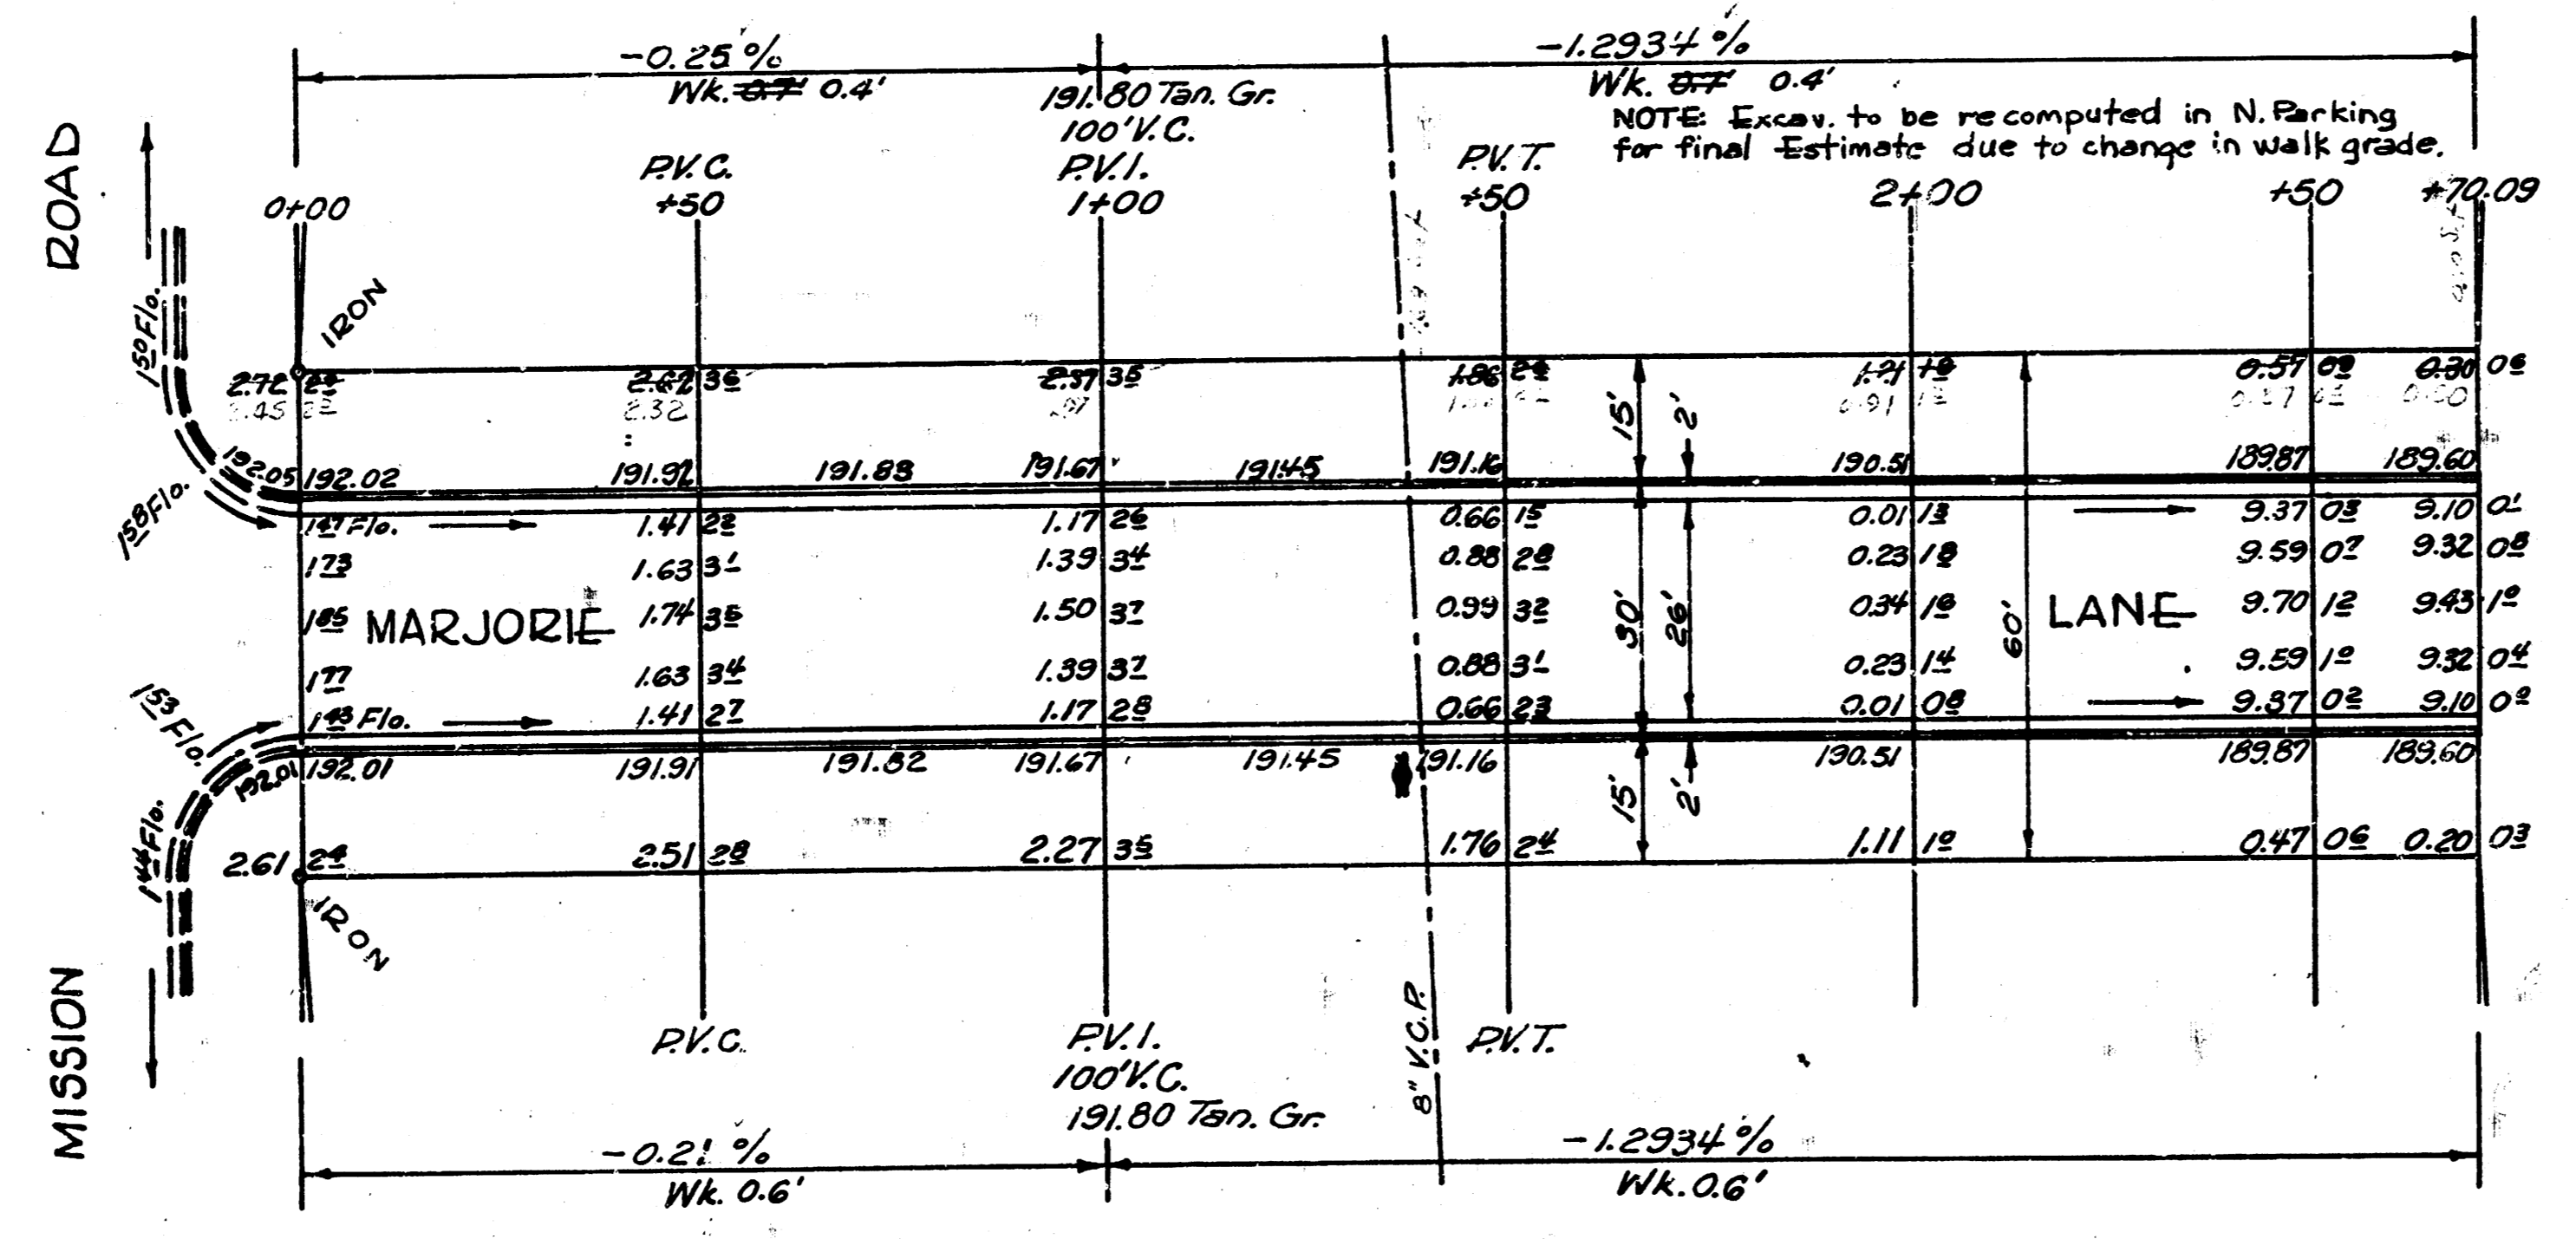

BK 1367
Survey Done
Plan D.W.H.
Exc. D.W.H.
Checked J.Z.

TOTAL EXCAV.	
PROP.	CITY
310.0	0
310.0	0
310.0 Cu.Yb.	0 Cu.Yb.

MARJORIE LANE
E.L. MISSION ROAD-W.L. BROOKFIELD ROAD
26'-2'-30' A.C.
CITY OF WICHITA, KANS.
B.E. SMITH CITY ENGINEER
MARCH 1957 PROJ. NO. C14-321

