


B.M. 198.71 S.E. Cor. Conc. P. South Side Stables  
 B.M. 198.18 Spike in W. Face P.P. N. of Murdock  
 B.M. 201.37 E.P. Spike W. Face P.P. S.W. Corner Woodlawn & 8th

Changing From S. to N. & W. to E. on W. & N. R.



NOTE:  
 VERTICAL CURVE AT STA 4+50 WAS INCREASED  
 TO 100' (ON JULY 15, 1954) TO ELIMINATE  
 FLAT SPOT AT TOP OF CURVE.

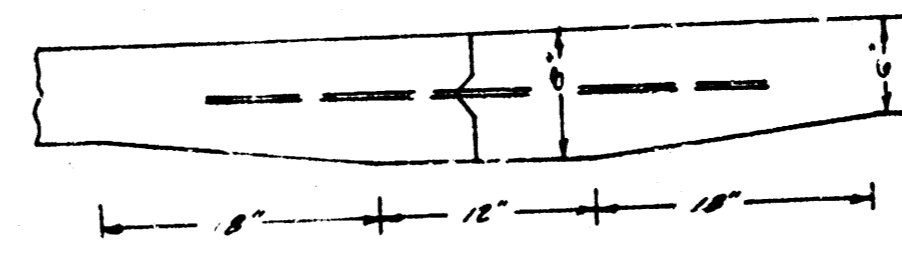


DETAIL OF MASTIC JOINT

SHOW ALMS  
 FROM JAZZ  
 CHECK 1/27

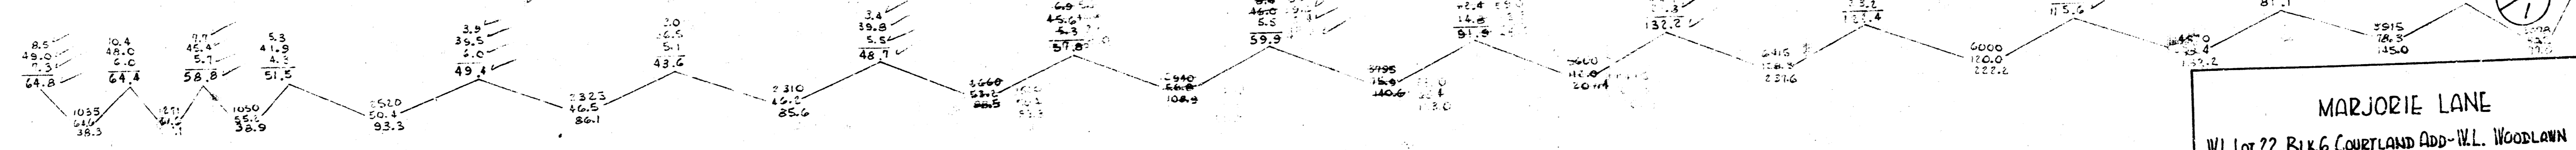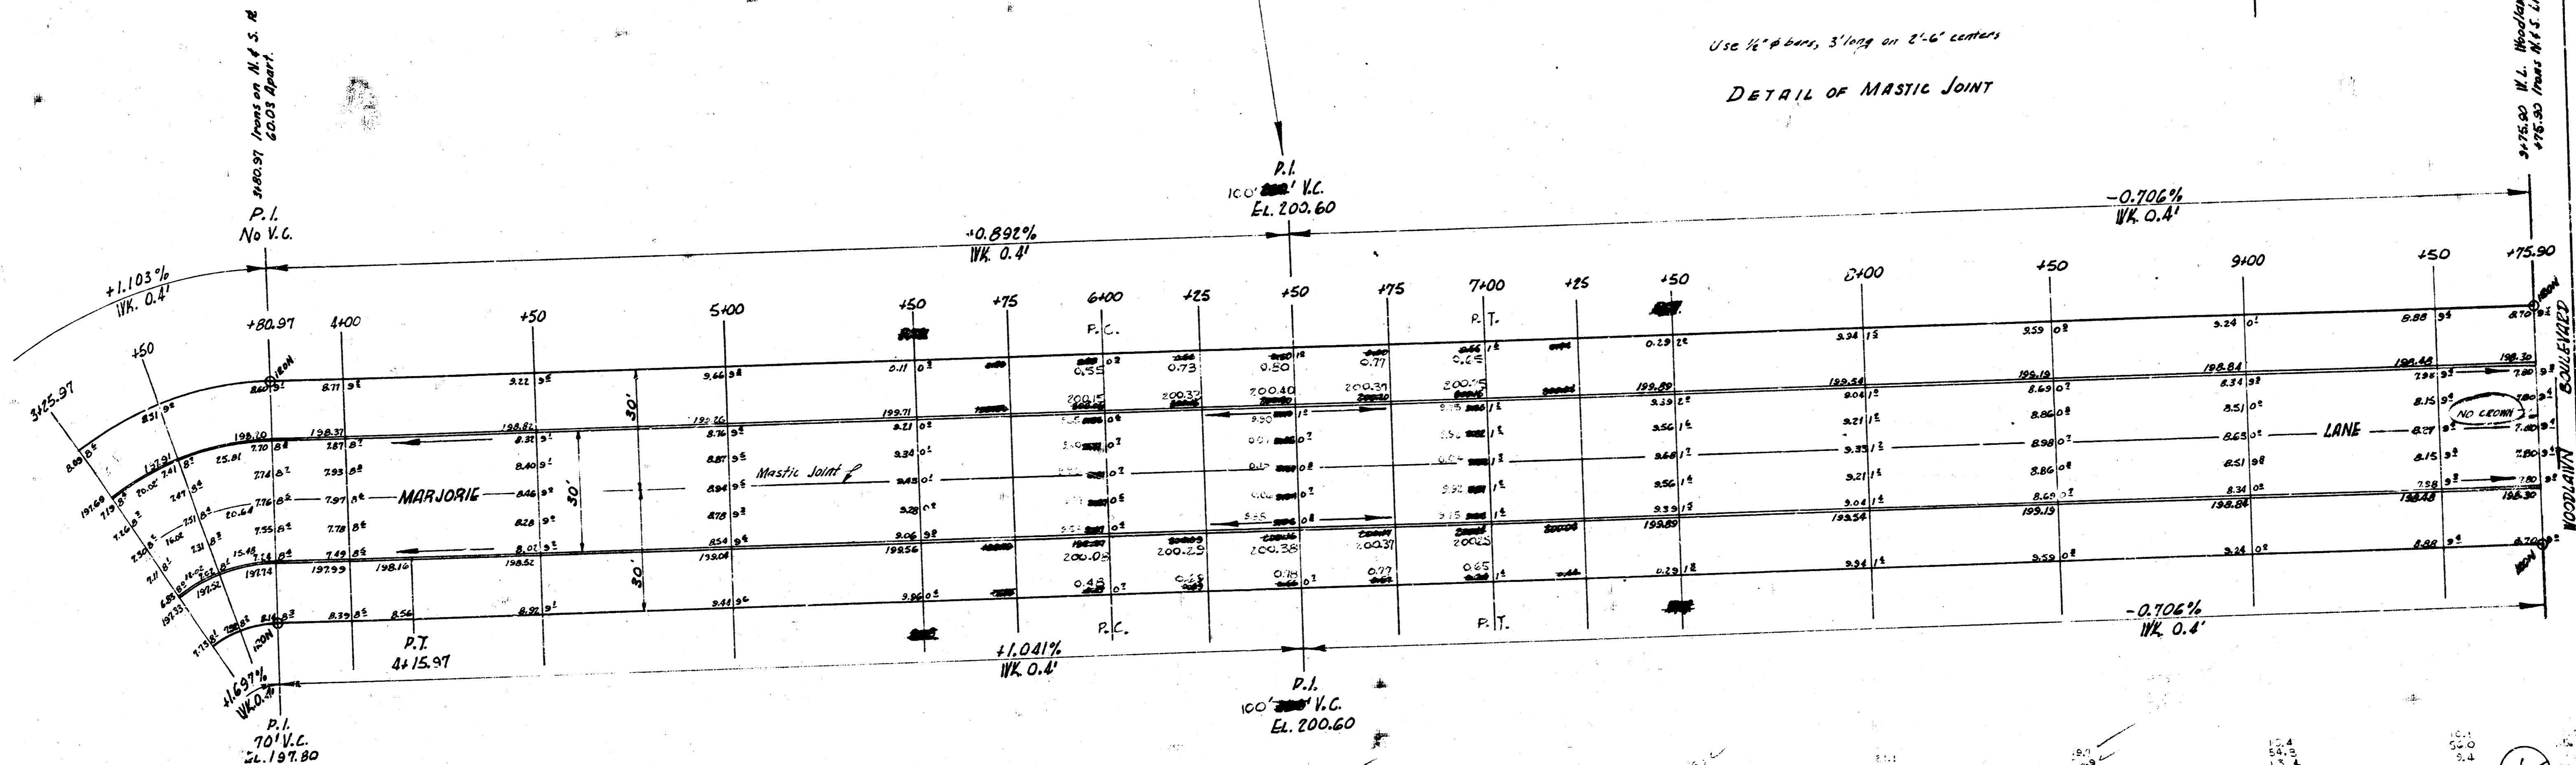

MARJORIE LANE  
 W.L. Lot 22 Blk. 6 Courtland Add. - W.L. Woodlawn  
 30' CONC. & C.B.  
 CITY OF WICHITA, KANS.  
 B.E. SMITH CITY ENGINEER  
 APRIL, 1954 PROJ. NO. C14-64

TOTAL EXCAV. CITY  
 1808.7 0 Cu.Yd.  
 1808.7 10% 180.9  
 1989.6 Cu.Yd.

