


Survey Young
Plan Knight 7-1-59
Exc Knight
Checked 7-1-59



Total		Excar		
Cost	Pror	Fill	Cost	Fill
102.2		11.7	7.1	0
			5.2	
			7.4	
100% 10.2		100% 1.2	19.7	
<u>112.4</u>	9.4%	<u>12.9</u>	2.0	
			21.7 ctyds	

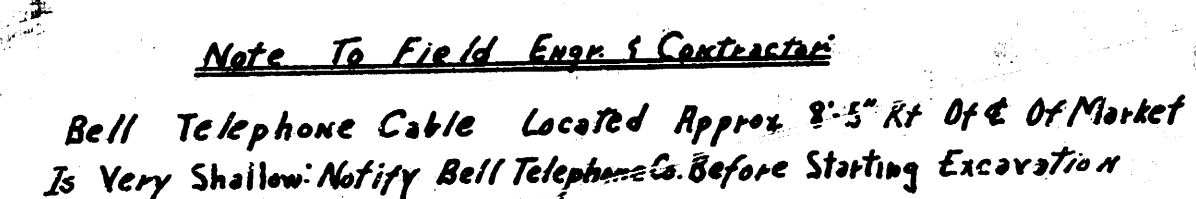

MARKET ST
N.L. 26TH ST S.L. AVEY
30' CONC. CB.
CITY OF WICHITAKAN
B.E. SMITH CITY ENGINEER
DATE PROJ. NO C-19-82