1942 Paved in 1943

# McCORMICK AVE.—W.L. MERIDIAN TO W.L. HIRAM

WIDEN 10FT. EACH SIDE & C.I.

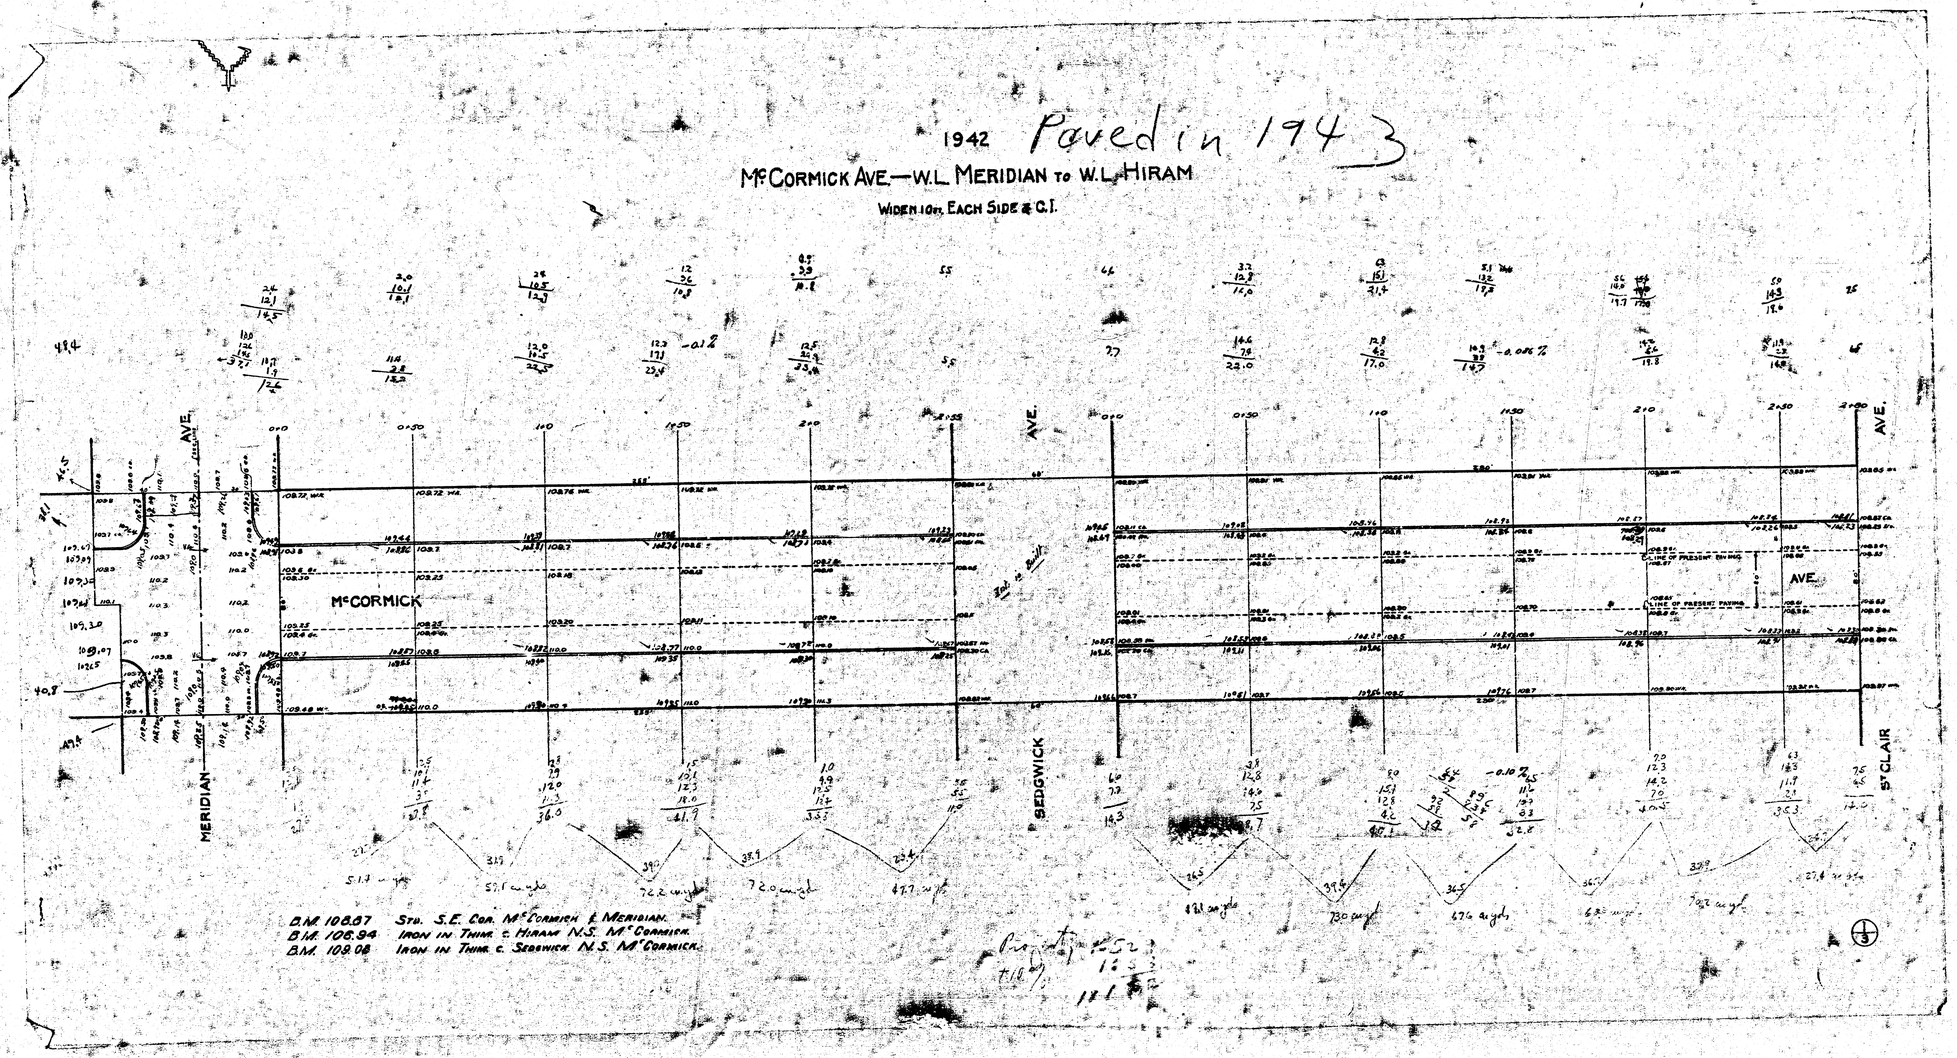

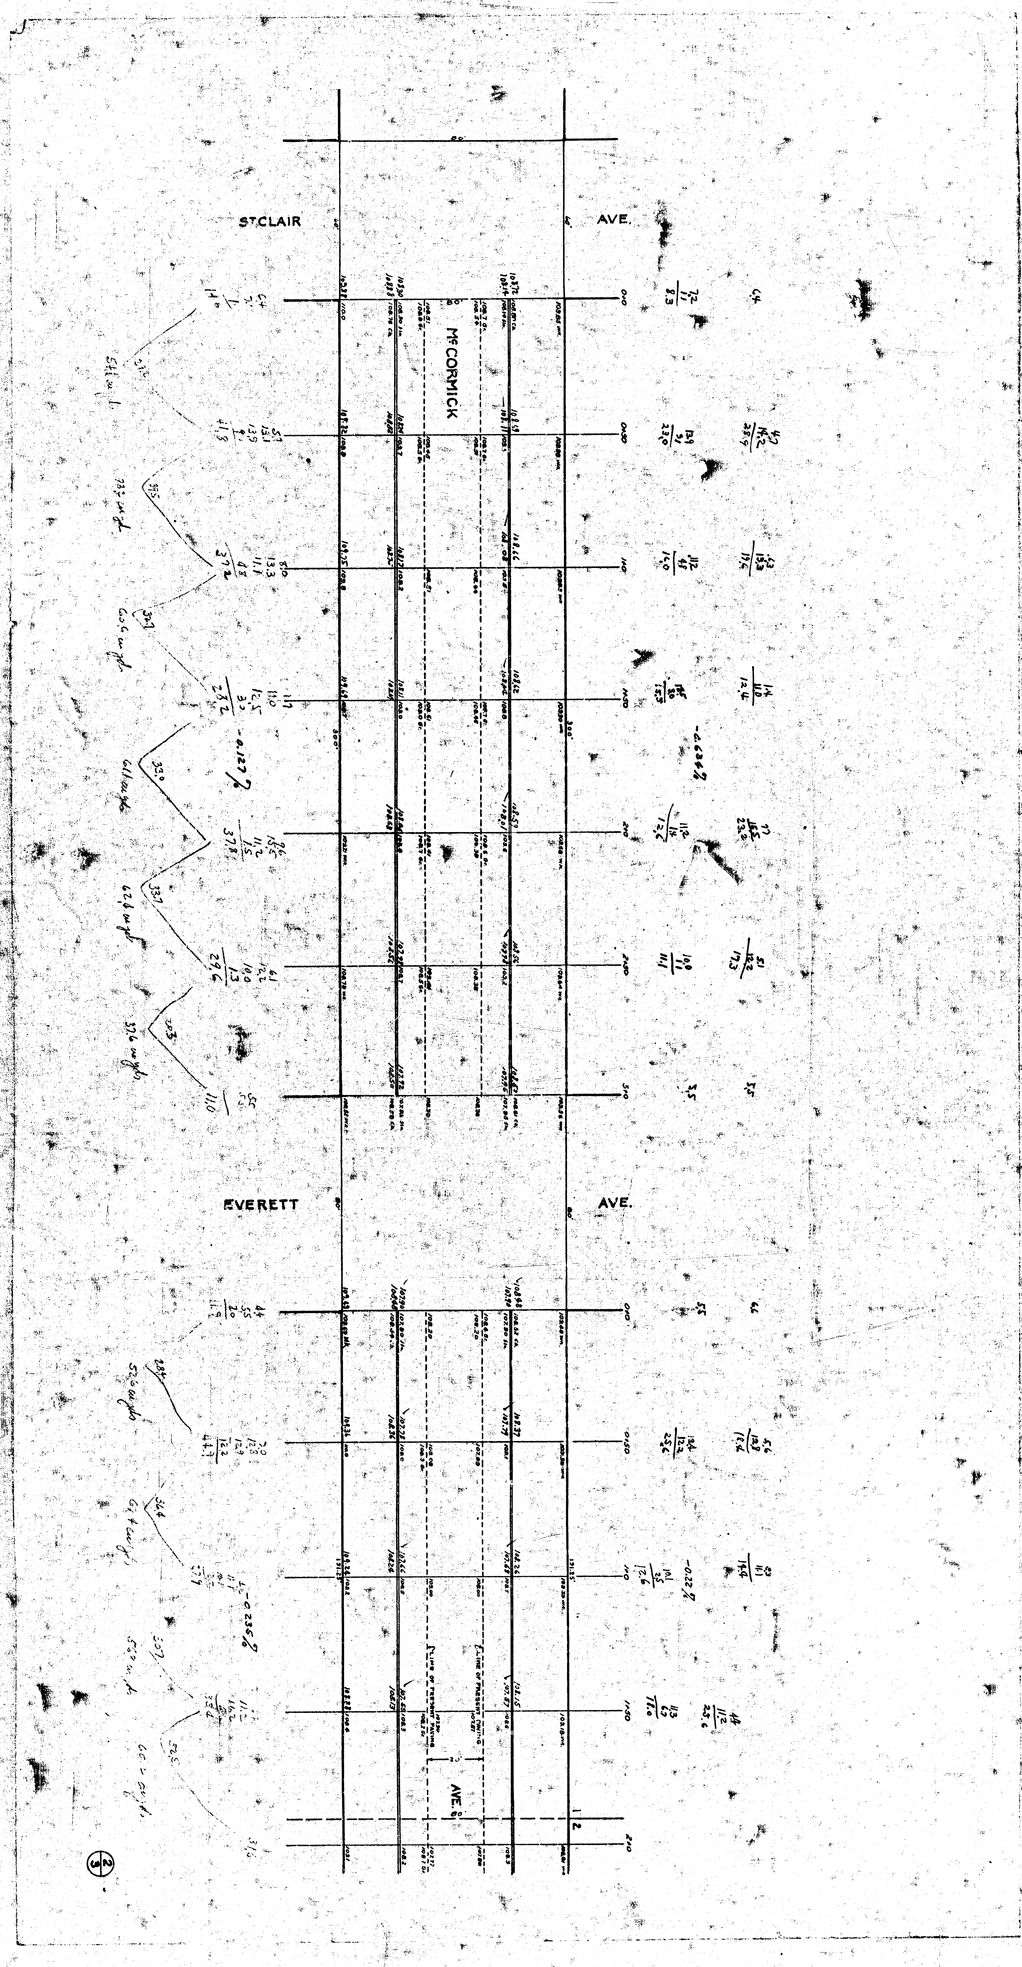
ST. CLAIR
AVE.
McCORMICK
EVERETT
AVE.
AVE.

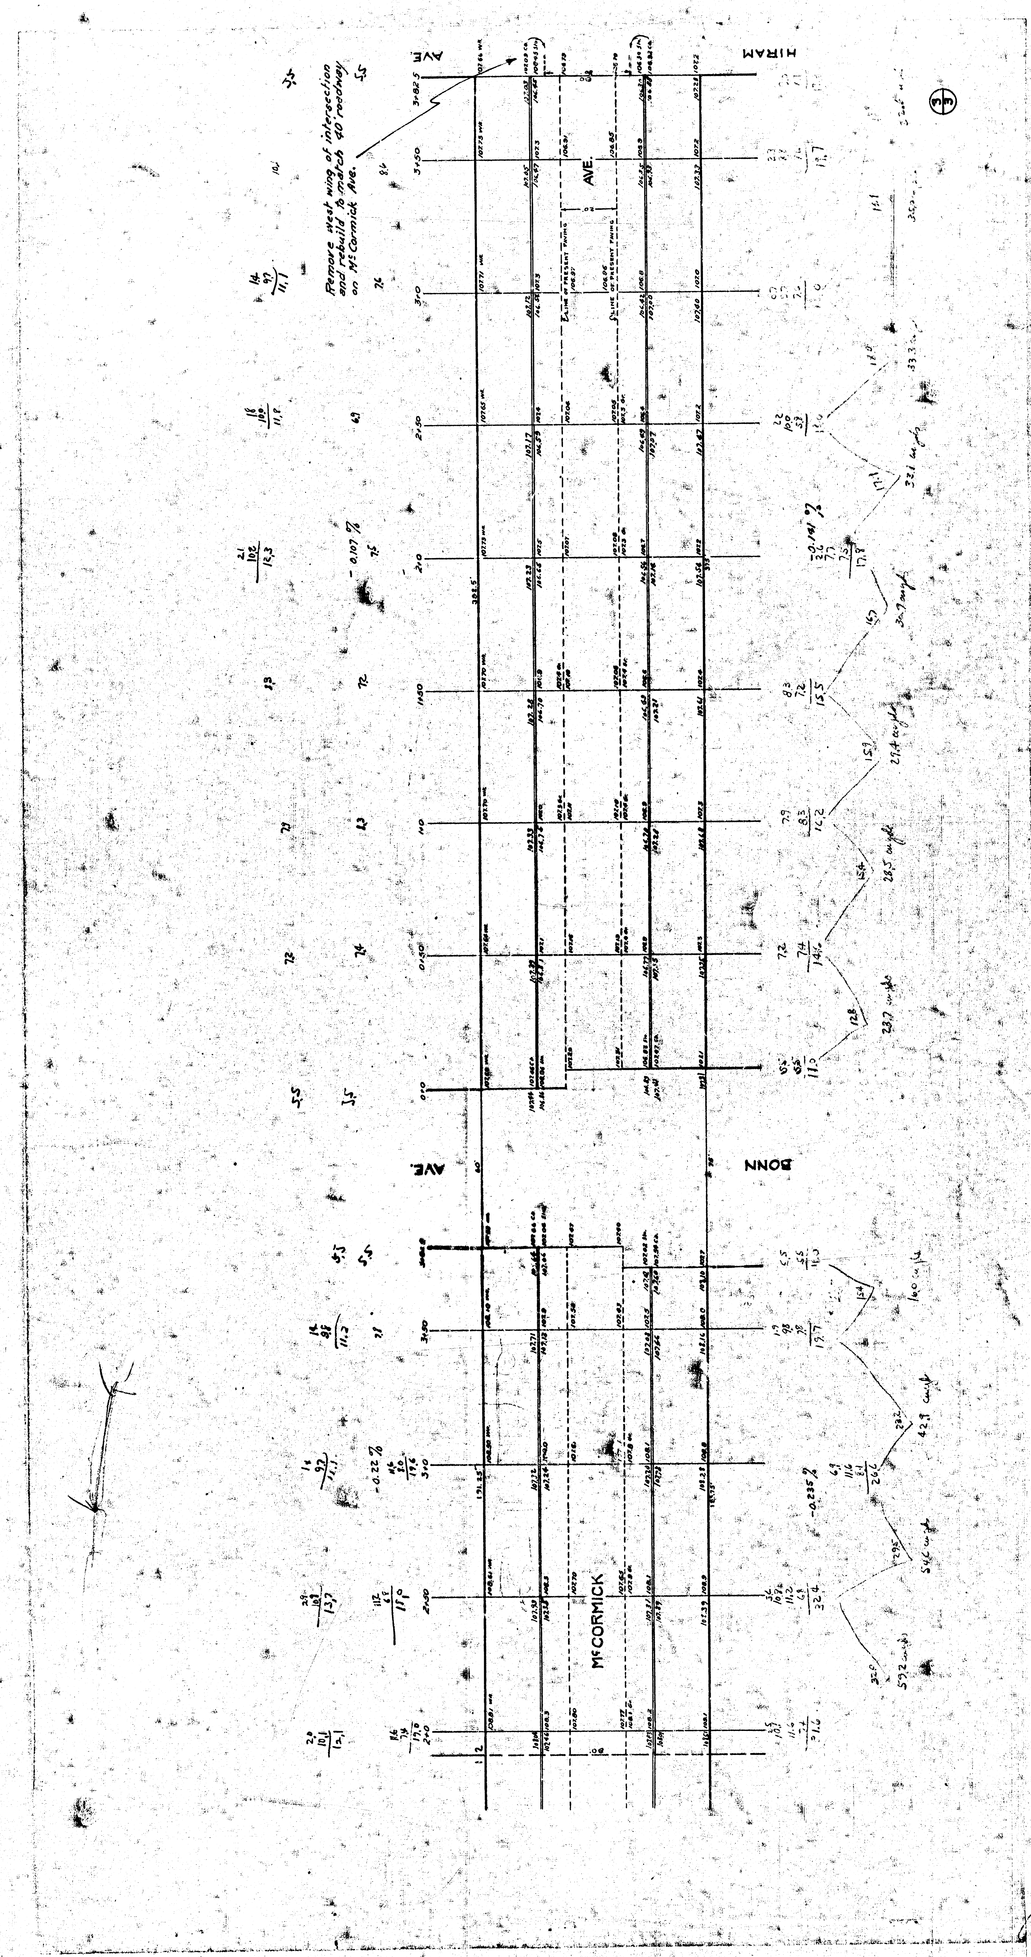
McCORMICK
AVE.
BONN
AVE.
HIRAM
Prepare west wing of intersection and rebuild to match 40' roadway on McCormick Ave.