



B.M. 139.76 "M" IN MILLER L.P. N.W. CORNER ROOSEVELT & MEADOWLANE.
 B.M. 127.91 TOP OF BOLT N. END EAST CURB WOODEN BRIDGE S. OF MT. VERNON ON BLUFF.
 B.M. 131.73 N.E. CORNER 1ST STEP ON EAST SIDE OF APART HOUSE.

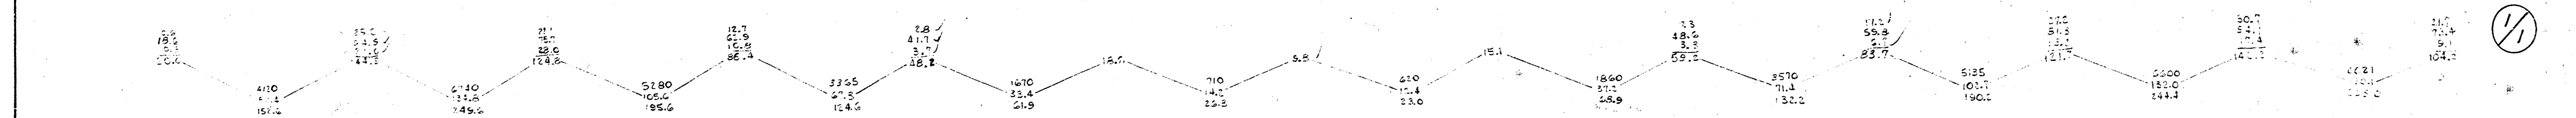

TOTAL EXCAV.	
Feet	CITY
1666.5	0 Cu.Yd.
+10% 163.6	
1830.1	

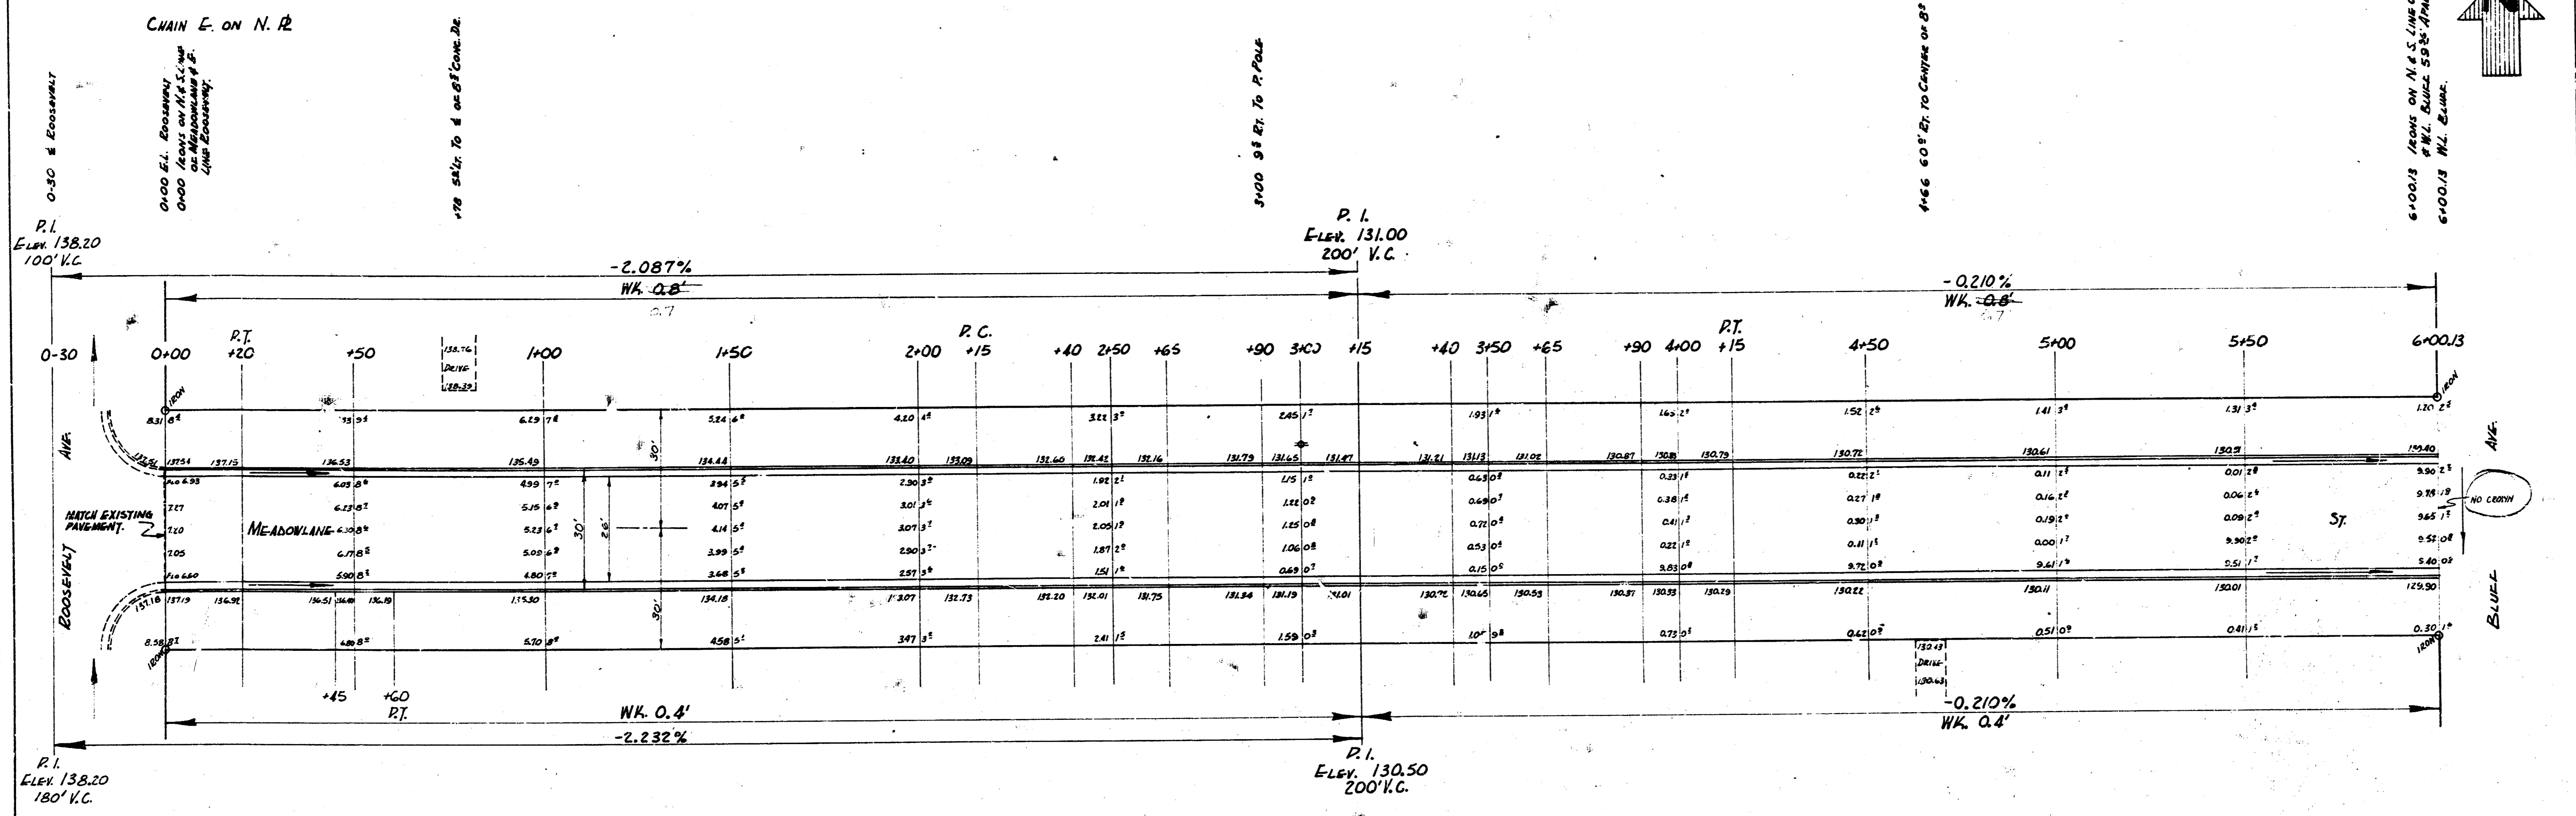

MEADOWLANE ST.
 E. L. ROOSEVELT - W. L. BLUFF
 26-2-30 A.C.
 CITY OF WICHITA, KANS.
 B.E. SMITH CITY ENGINEER
 APRIL, 1954 PROJ. NO. C14-15

