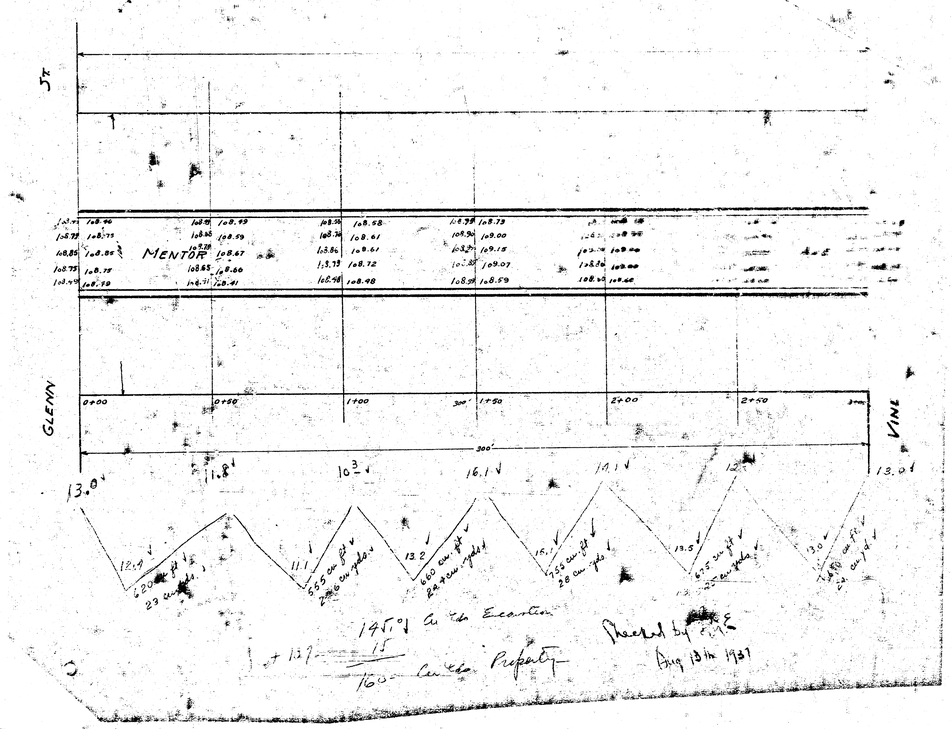
MENTOR
GLENN
VINE
0+00
0+50
1+00
1+50
2+00
2+50
300'
13.0
11.8
10 3/4
16.1
14.1
13.0
12.4
11.1
13.2
16.1
13.5
13.0
Checked by
