



BM. 115.99 "T" in tray, Hyd. N.W. Cor. Bonn & Mentor
 BM. 105.15 Iron in H.W. & Mentor, & Hiram.

NOTE:
 This portion of MENTOR ST. S.W. WAS PUT ON BONN ST. JOBS. DON'T INCLUDE EICAW. IN THIS LOG.

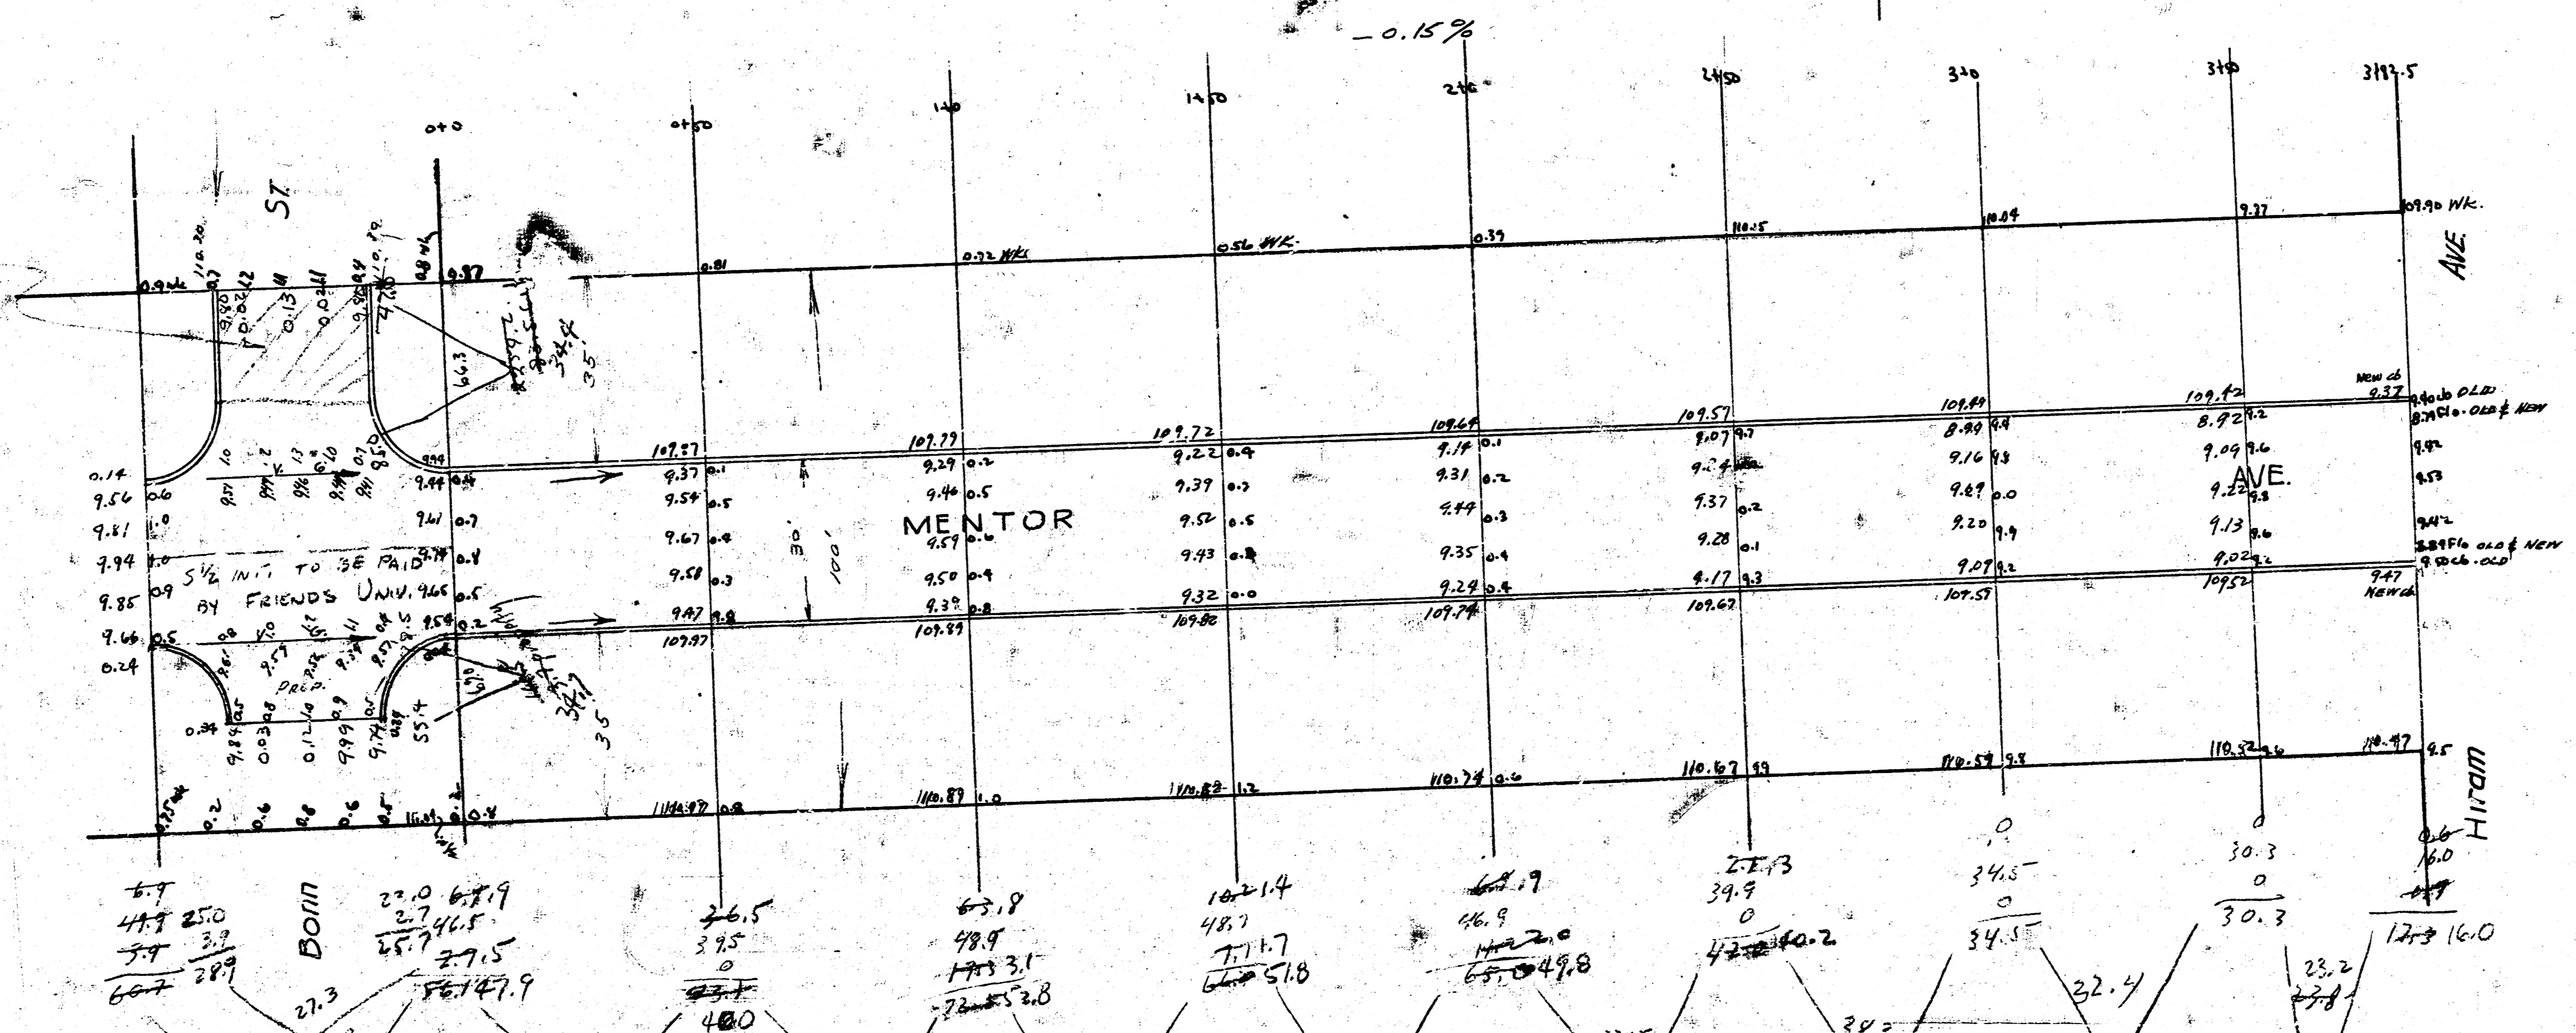


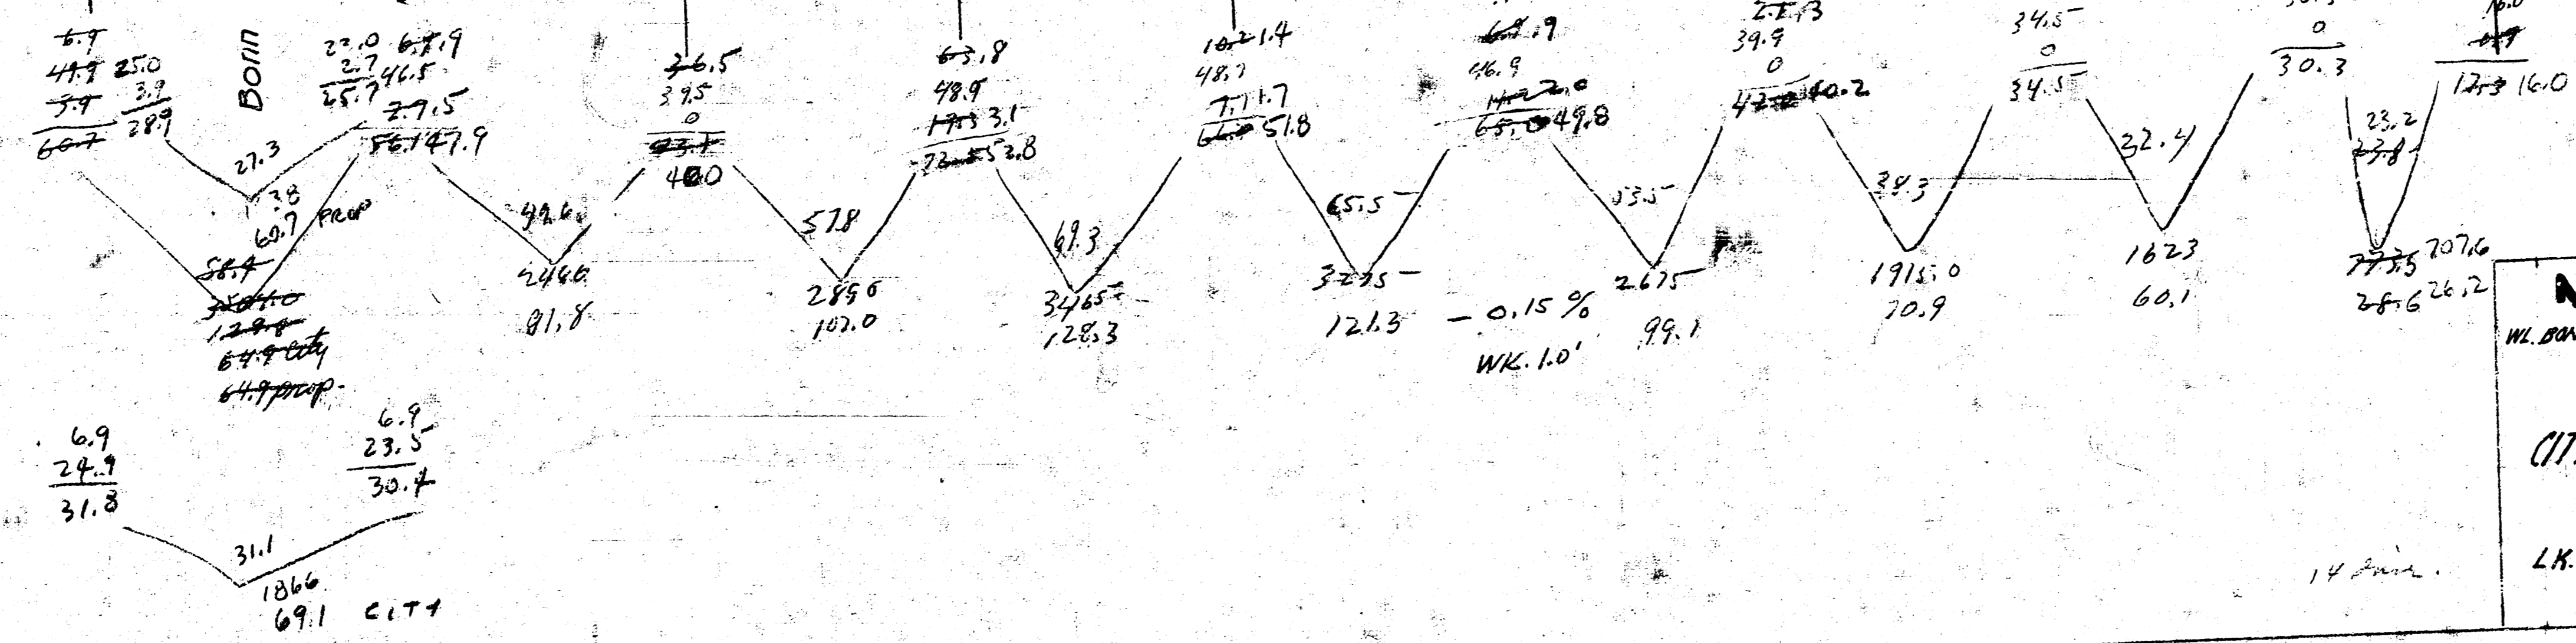

MENTOR AVE.
 W.L. BONN to W.L. HIRAM
 30' CONCRETE & C.B.
 CITY OF WICHITA, KANS.
 Engineering Division
 L.K. WHITE CITY ENGINEER
 JULY 1947