


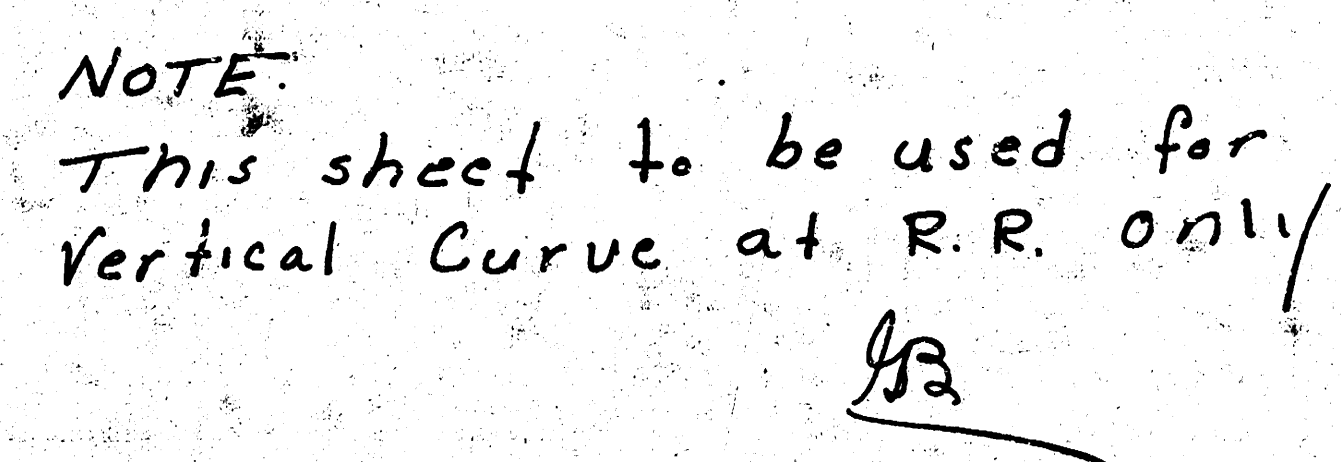

MERIDIAN AVE
 34 MAPLE TO N. UNIVERSITY
 30' CONC & CB.
 CITY OF WICHITA KANS
 LK WHITE CITY ENGR

4153 (6)

BM 11137 STANDARD NE CORNER MERIDIAN & MAPLE
BM 11385 T IN TROY TOP FIRE PLUG N.W. COR. UNIVERSITY & MERIDIAN

Property


13.5	
30.4	
45.4	
41.7	
34.5	
37.0	
36.7	
29.3	
6.5	
<u>277.0</u>	the 2nd

CT-4
217
111.8
46
104.1
104.1

10/21

Property Tax
277.0
8.1.5
110.5
1219.4

10/21

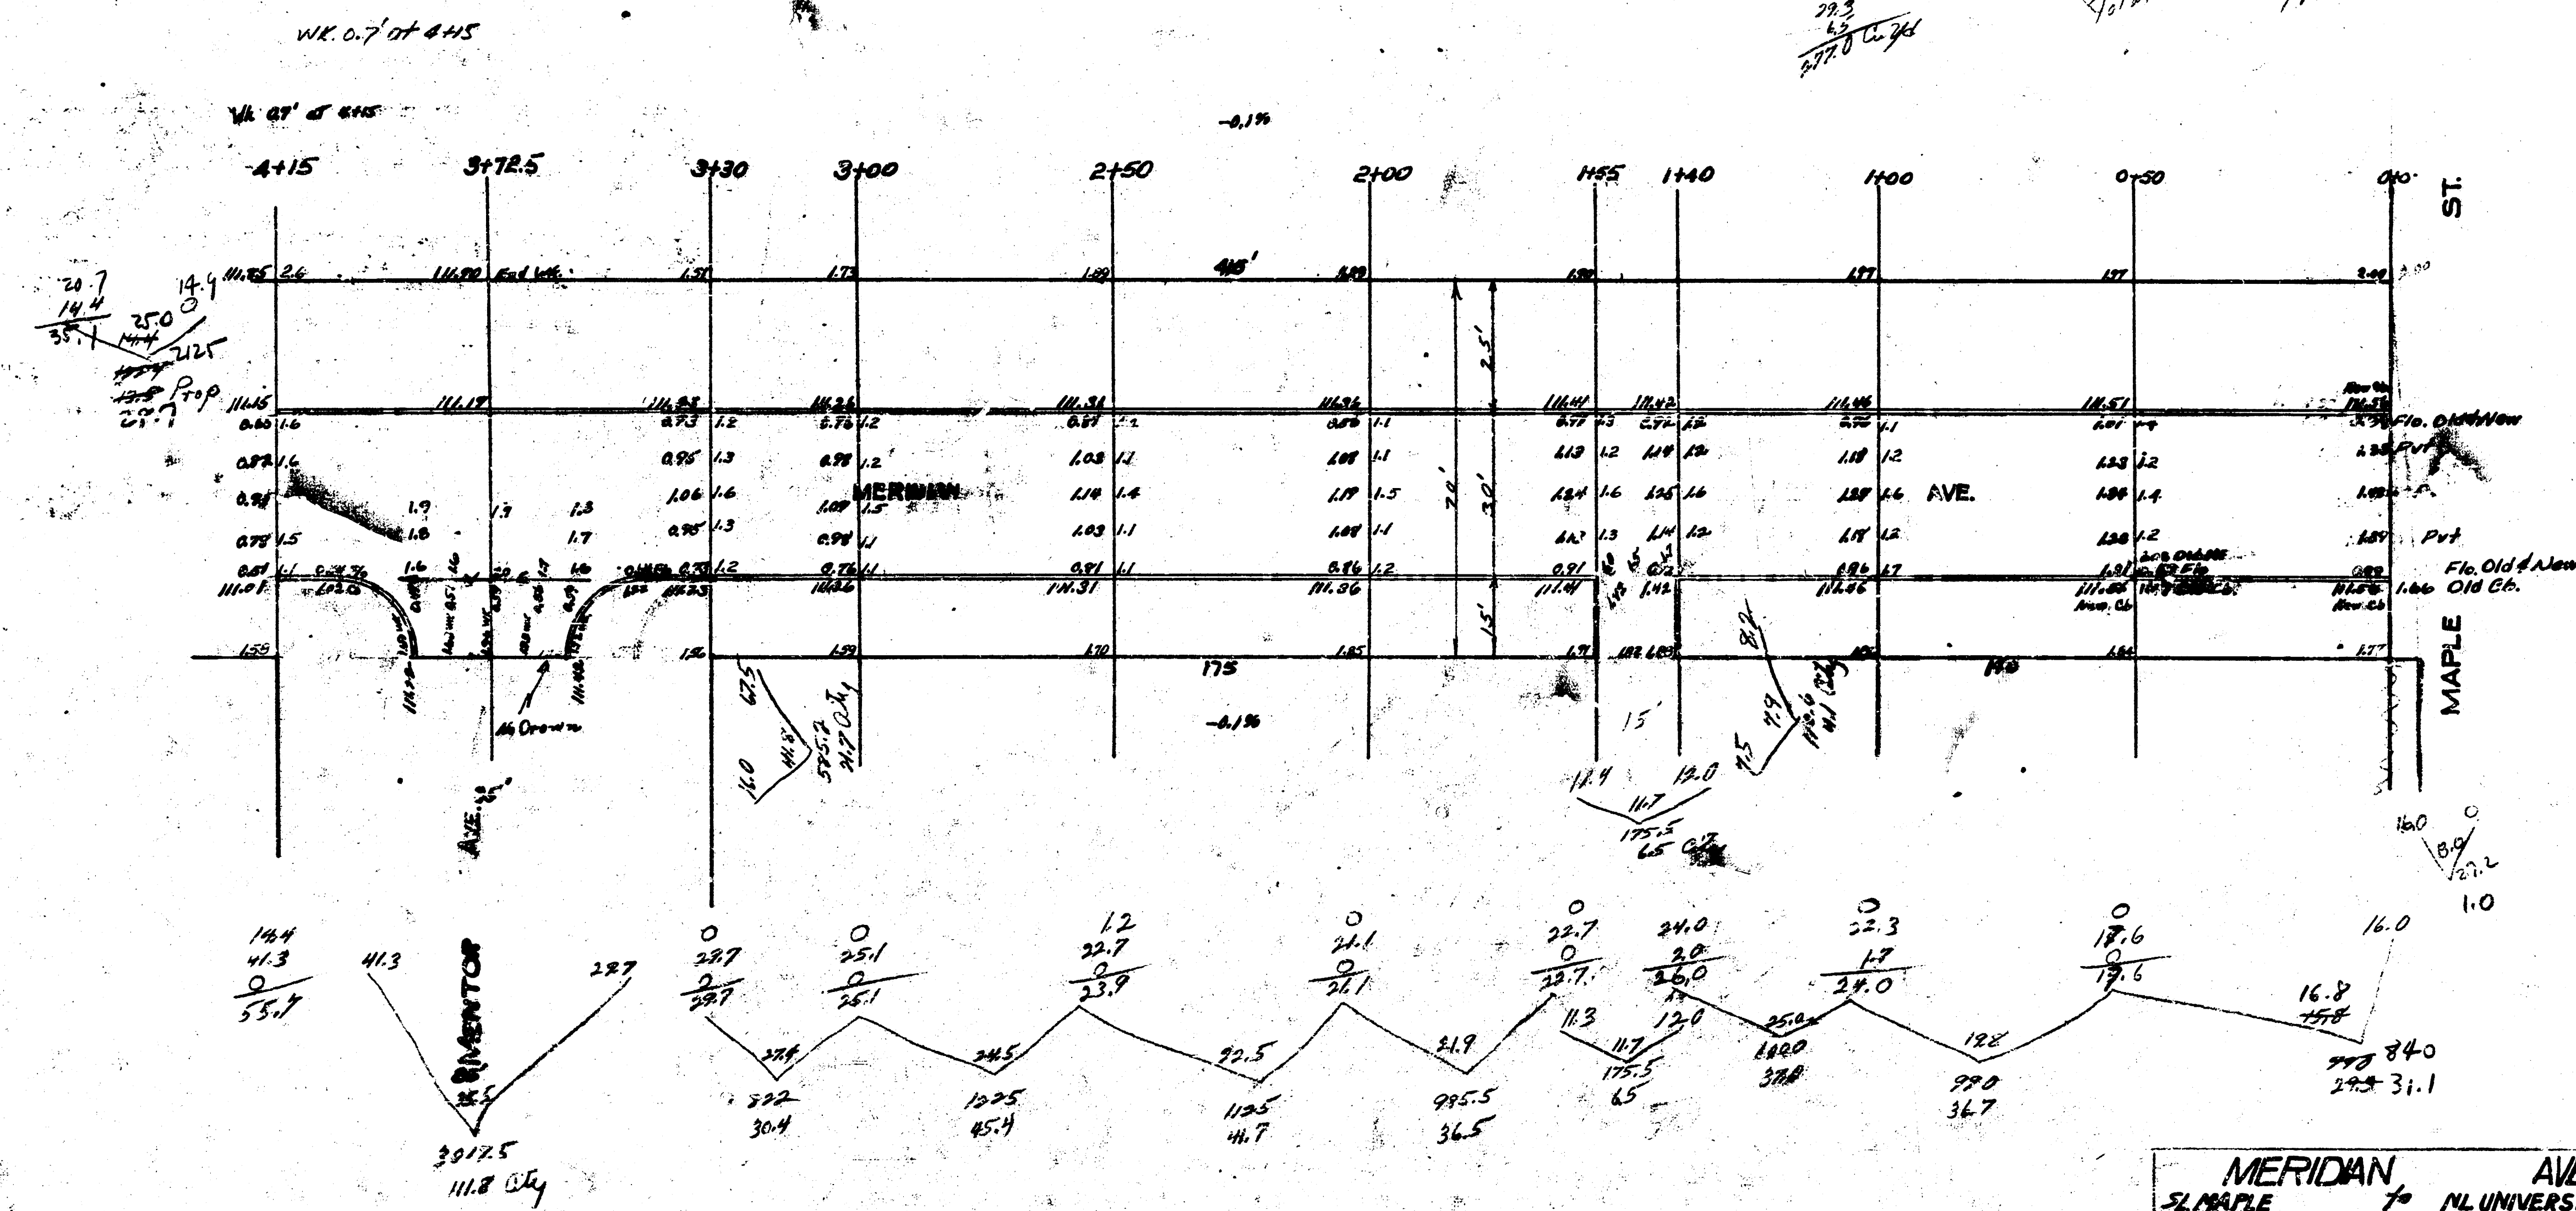

MERIDIAN AVE
 SAMPLE 70 NL UNIVERSITY
 30' CONC. CURB
 CITY 9' WICHITA, KANSAS
 L.K. WHITE
 CITY ENGINEER
 JULY 1947

