


S.M. 95' CITY STANDARD N.E. COR MERIDIAN & 27TH ST. SO.
 S.M. 100' S.W. COR. WEST CONC PORCH. HO. ON N.E. WILDWOOD & MERIDIAN

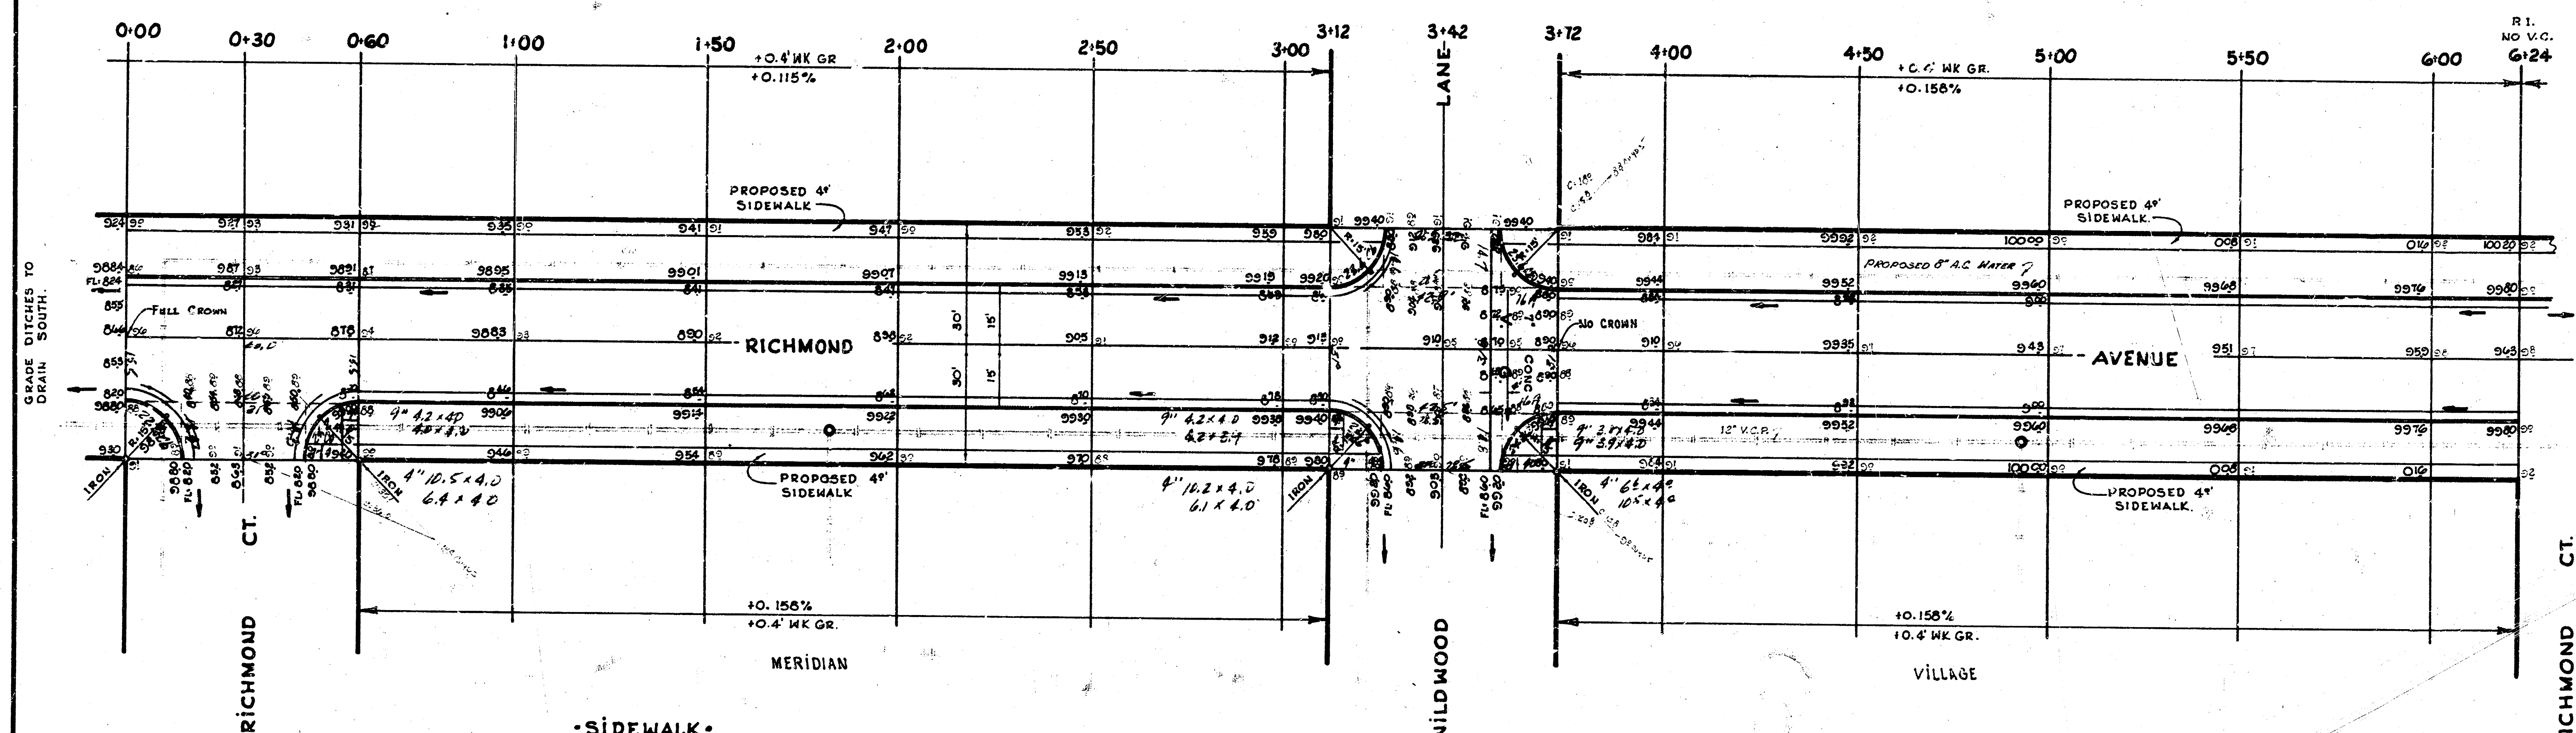


•SIDEWALK•
 GRADE PARKINGS AND CLEAR RIGHT OF WAY FOR
 PROPOSED SIDEWALK. COMPACT BACKFILL IN SIDEWALK
 AREA. ALL EXCAVATION TO BE USED TO FILL PARKINGS
 FIRST.

•EARTHWORK•

EXCAVATION	COMP. FILL
146.1 CU YDS	3.1 CU YDS
10% 14.6	4.1 CU YDS
160.7 CU YDS	115.0 CU YDS S.G.M.

NOTE TO CONTRACTOR
 This project will be constructed under
 the supervision of the CITY ENGINEER
 and conforming to the SPECIFICATIONS
 of the CITY OF WICHITA. The CON-
 TRACTOR will reimburse the City of
 Wichita for all cost of Engineering, Plans,
 Inspection.

•NOTE TO CONTRACTOR•
 CO-ORDINATE WORK WITH UTILITY COMPANIES
 ON LINES CROSSING PAVEMENT.

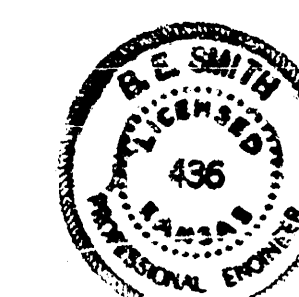



INTERSECTIONS OF
 RICHMOND AVE AND WILDWOOD LANE,
 AND RICHMOND COURTS IN MERIDIAN
 VILLAGE ADDITION.
ASPHALT PAVEMENT
 CITY OF WICHITA, KANSAS
 B.E. SMITH CITY ENGINEER
 DATE: MAY 1969 PROJECT No. C19-23

RICHMOND AVENUE
 S.E. RICHMOND COURT IN BLK 2,
 MERIDIAN VILLAGE ADD. TO SL. 27TH ST. SO.
26' - 2' - 30' ASPHALTIC CONC.
 CITY OF WICHITA, KANSAS
 B.E. SMITH CITY ENGINEER
 DATE: MAY 1969 PRIVATE PROJECT



SCALE 1"=20'

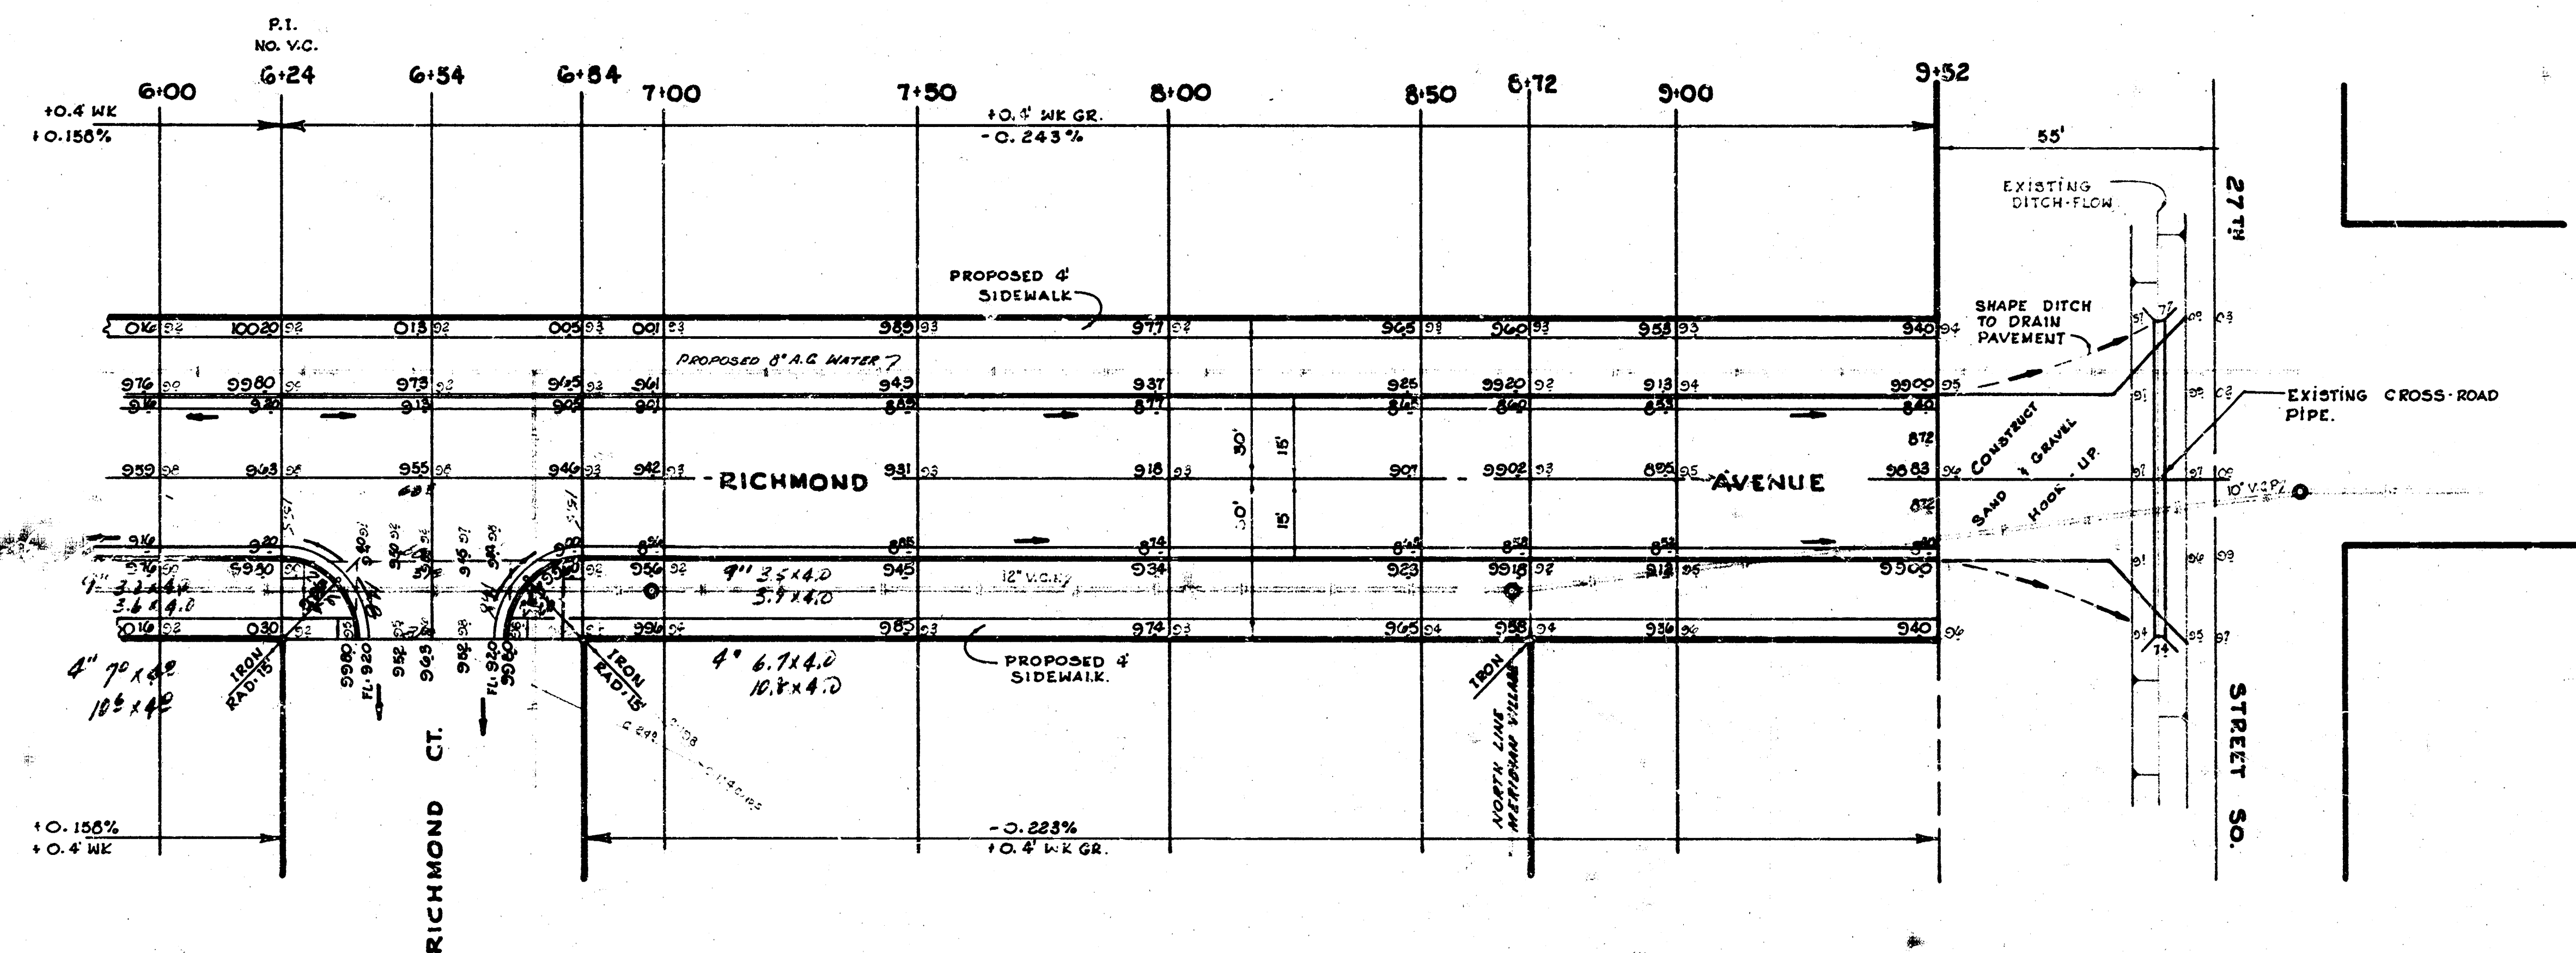


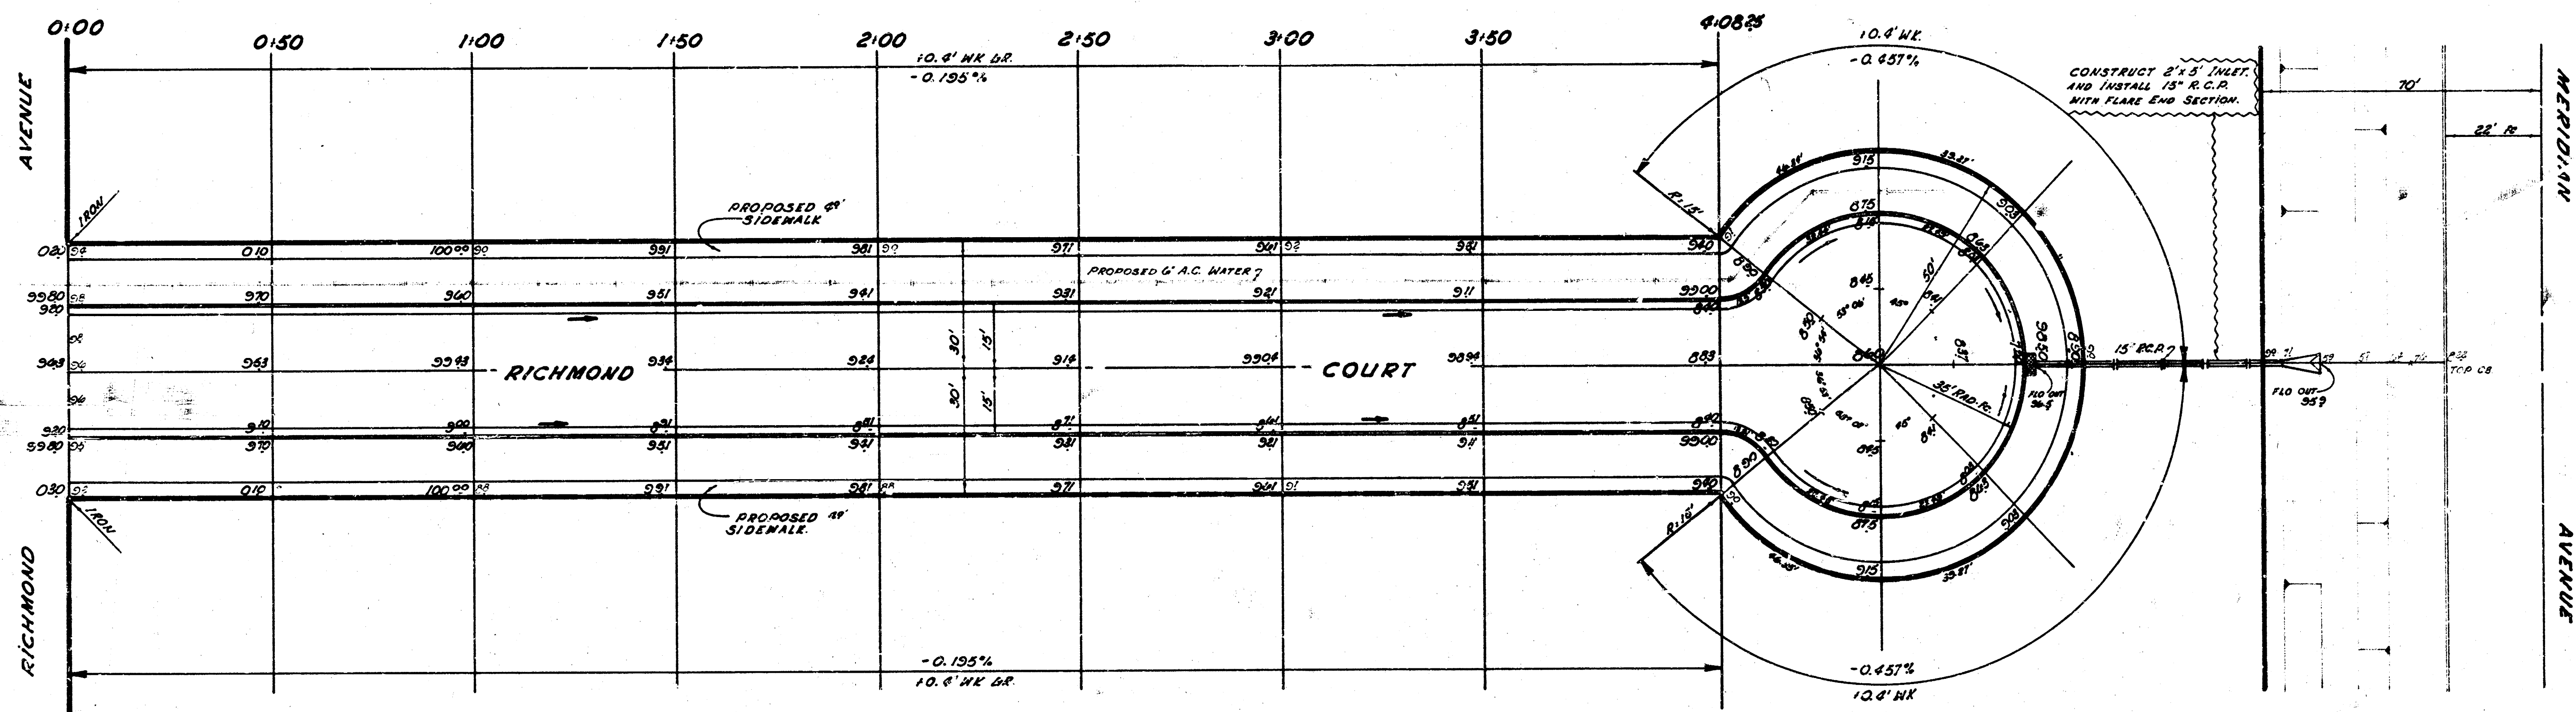


NOTE TO CONTRACTOR

This project will be constructed under the supervision of the CITY ENGINEER and conform to the SPECIFICATIONS of the CITY OF NICHITA. The CONTRACTOR will reimburse the City of Nichita for all cost of Engineering, Plans, and Inspection.

RICHMOND COURT
E.L. RICHMOND AVE TO AND INCLUDING
CUL-DE-SAC IN BLK 1, MERIDIAN VILLAGE ADD.
26'-2'-30' ASPH-CONC.
CITY OF NICHITA, KANSAS
B.E. SMITH CITY ENGINEER
DATE: PRIVATE PROJECT.


B.M. 10011 S.W. COR. OF WEST CONC. PORCH NO. ON N.E.
WILDWOOD AND MERIDIAN.
B.M. 9992 CITY STANDARD N.E. COR. MERIDIAN 127th ST. 50.

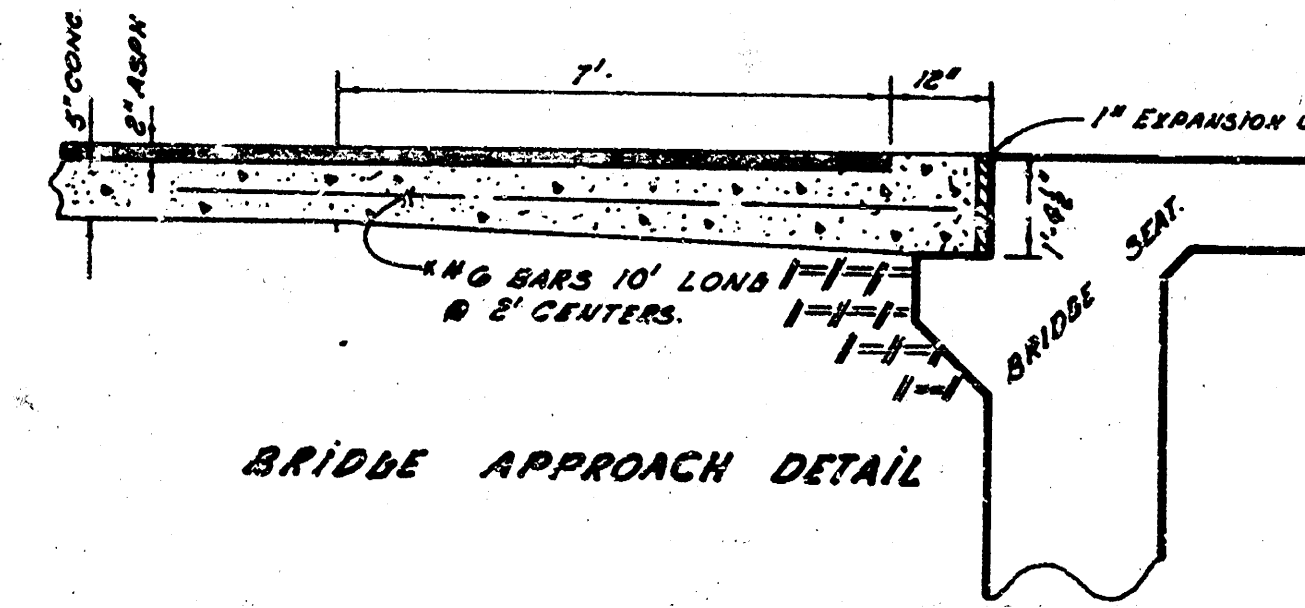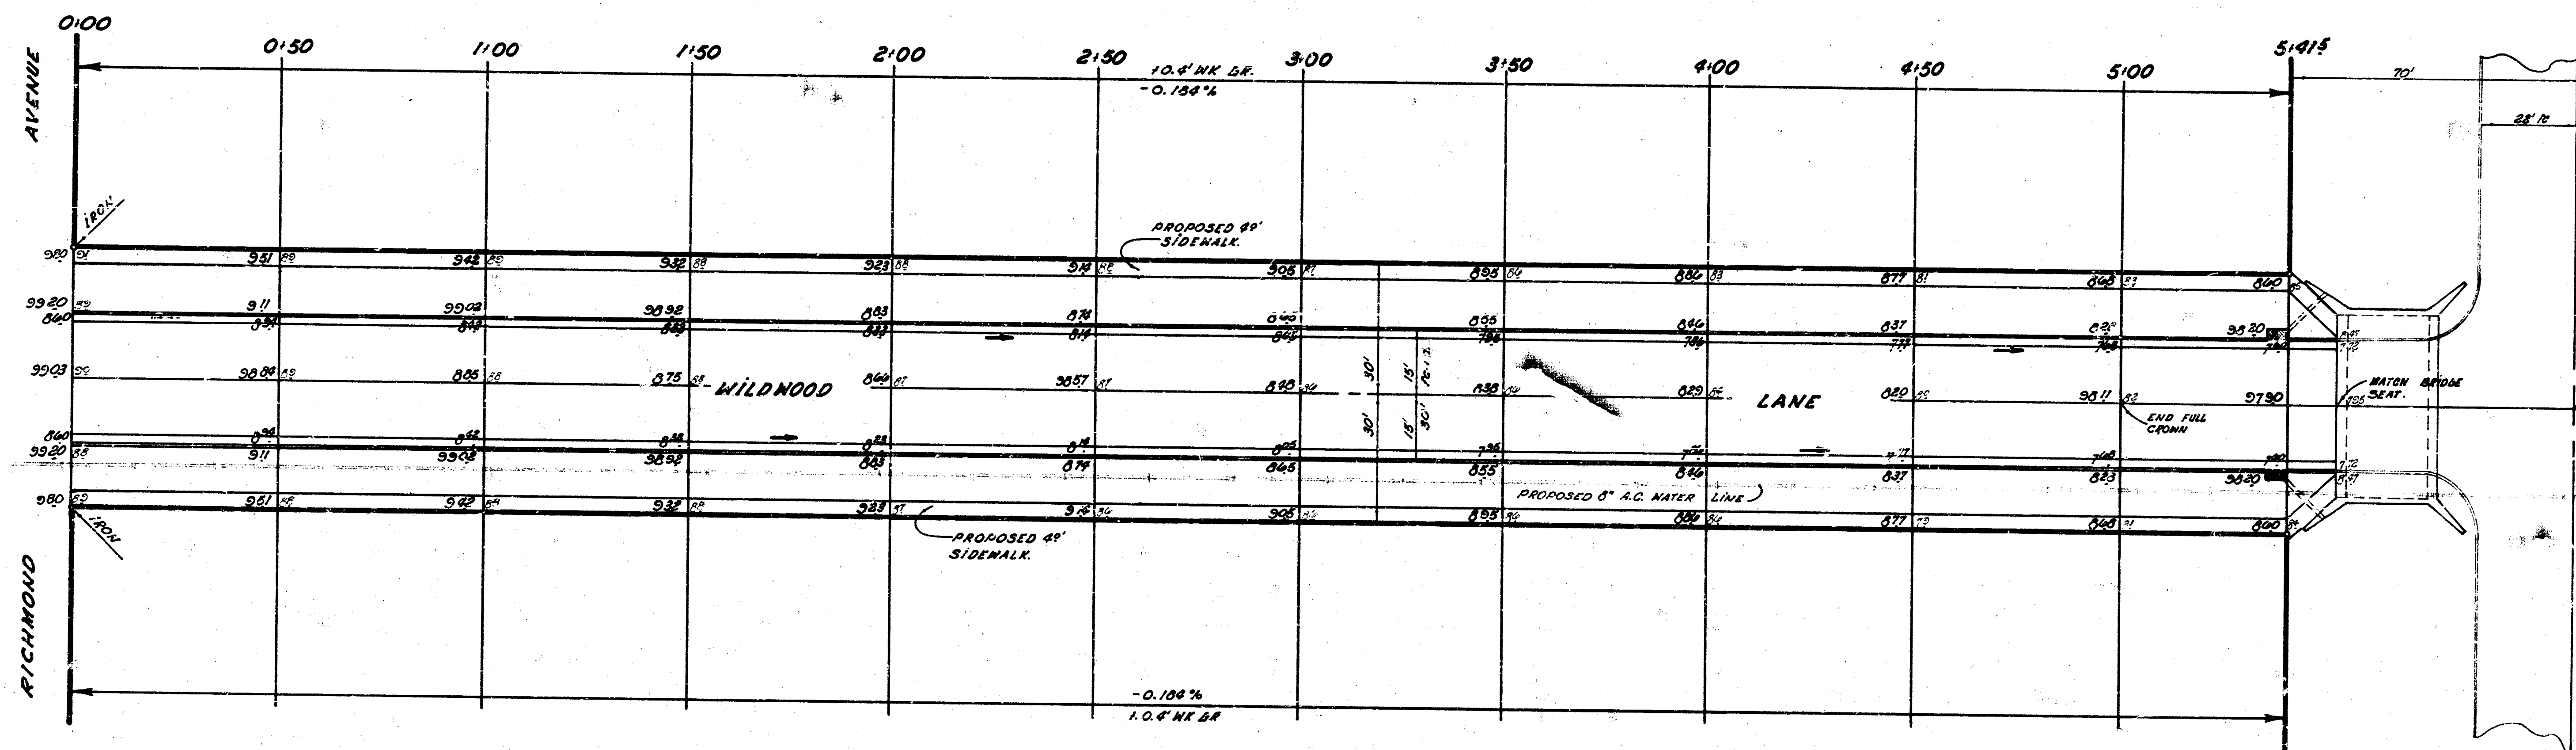

NOTE: PAVING CONTRACTOR TO MATCH APPROACH
SEAT AND BRIDGE ELEVATIONS.

NOTE TO CONTRACTOR
This project will be constructed under
the supervision of the CITY ENGINEER
and conforming to the SPECIFICATIONS
of the CITY OF WICHITA. The CON-
TRACTOR shall reimburse the City of
Wichita for all cost of Engineering, Plans,
and Inspection.

WILDWOOD LANE
E.L. RICHMOND AVE TO N.E. MERIDIAN
AVE.
26' - 2' - 30' ASPH. CONC
CITY OF WICHITA, KANSAS
B.E. SMITH CITY ENGINEER.
DATE: PRIVATE PROJECT.

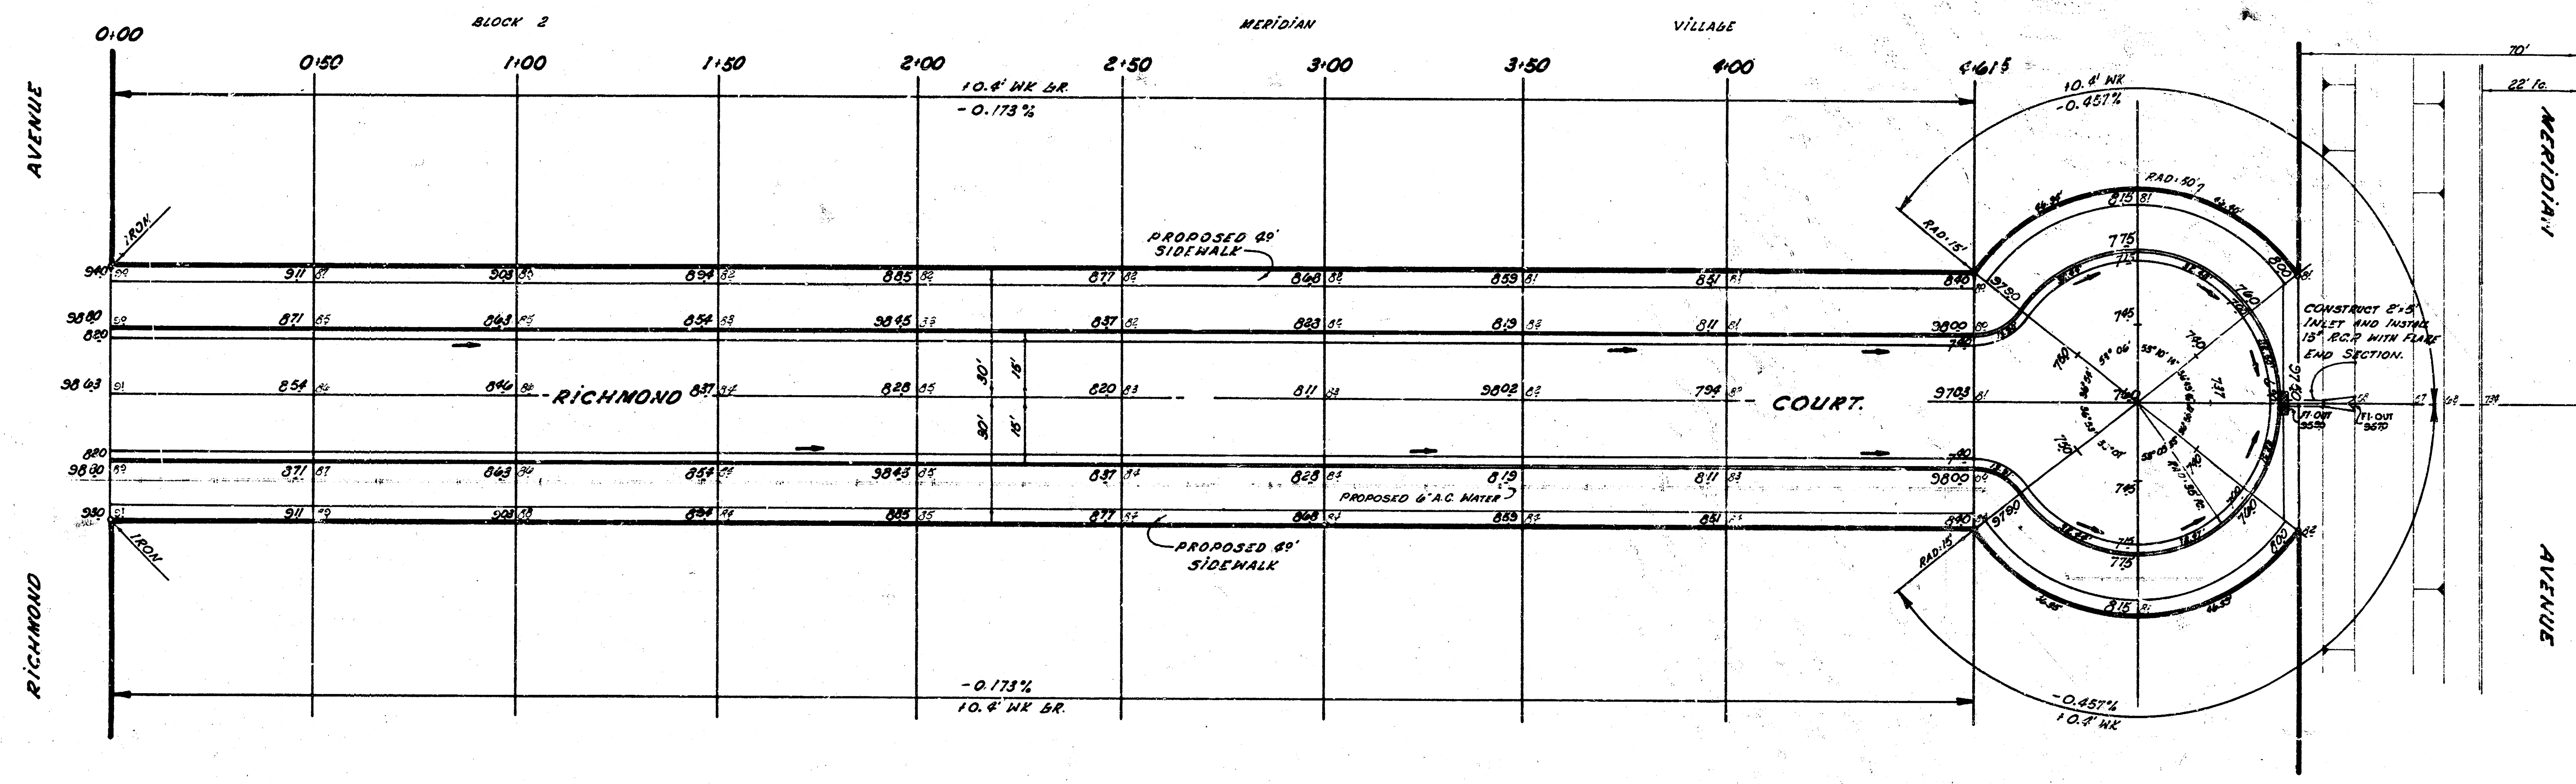

NOTE TO CONTRACTOR
This project will be constructed under the supervision of the CITY ENGINEER and all work shall conform to the SPECIFICATIONS of the CITY OF WICHITA. The CITY ENGINEER shall reimburse the City of Wichita for all cost of Engineering, Plans, & Inspection.

RICHMOND COURT.
S.E. RICHMOND AVE. TO AND INCLUDING
CUL-DE-SAC IN BLK 2, MERIDIAN VILLAGE.
26'-2'-30' ASPHALTIC CONC.
CITY OF WICHITA, KANSAS
B. E. SMITH CITY ENGINEER
DATE: PRIVATE PROJECT.