
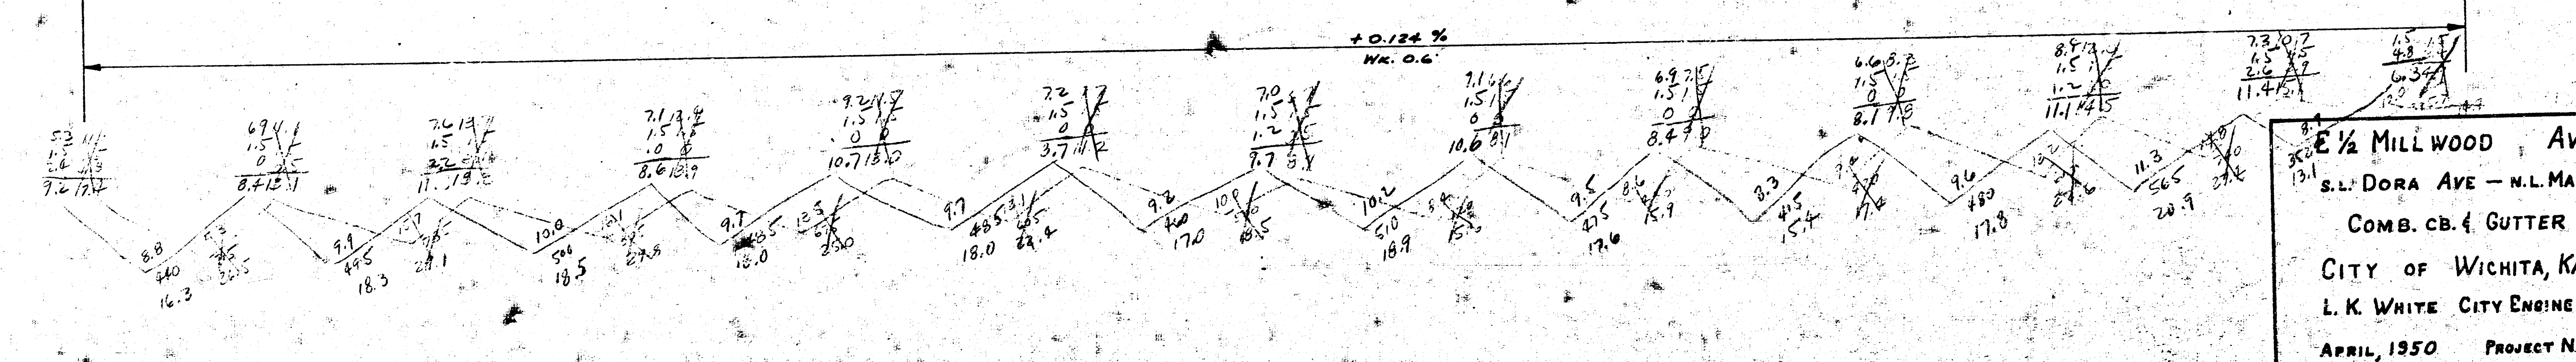


B.M. 102.79' 6" in Globe Wcb. Millwood (N.L. May)


B.M. 103.45' 0" in Globe Ecb. Millwood (N.L. Dora)

Note: Y.B. Hf.3. Both sides of Millwood.

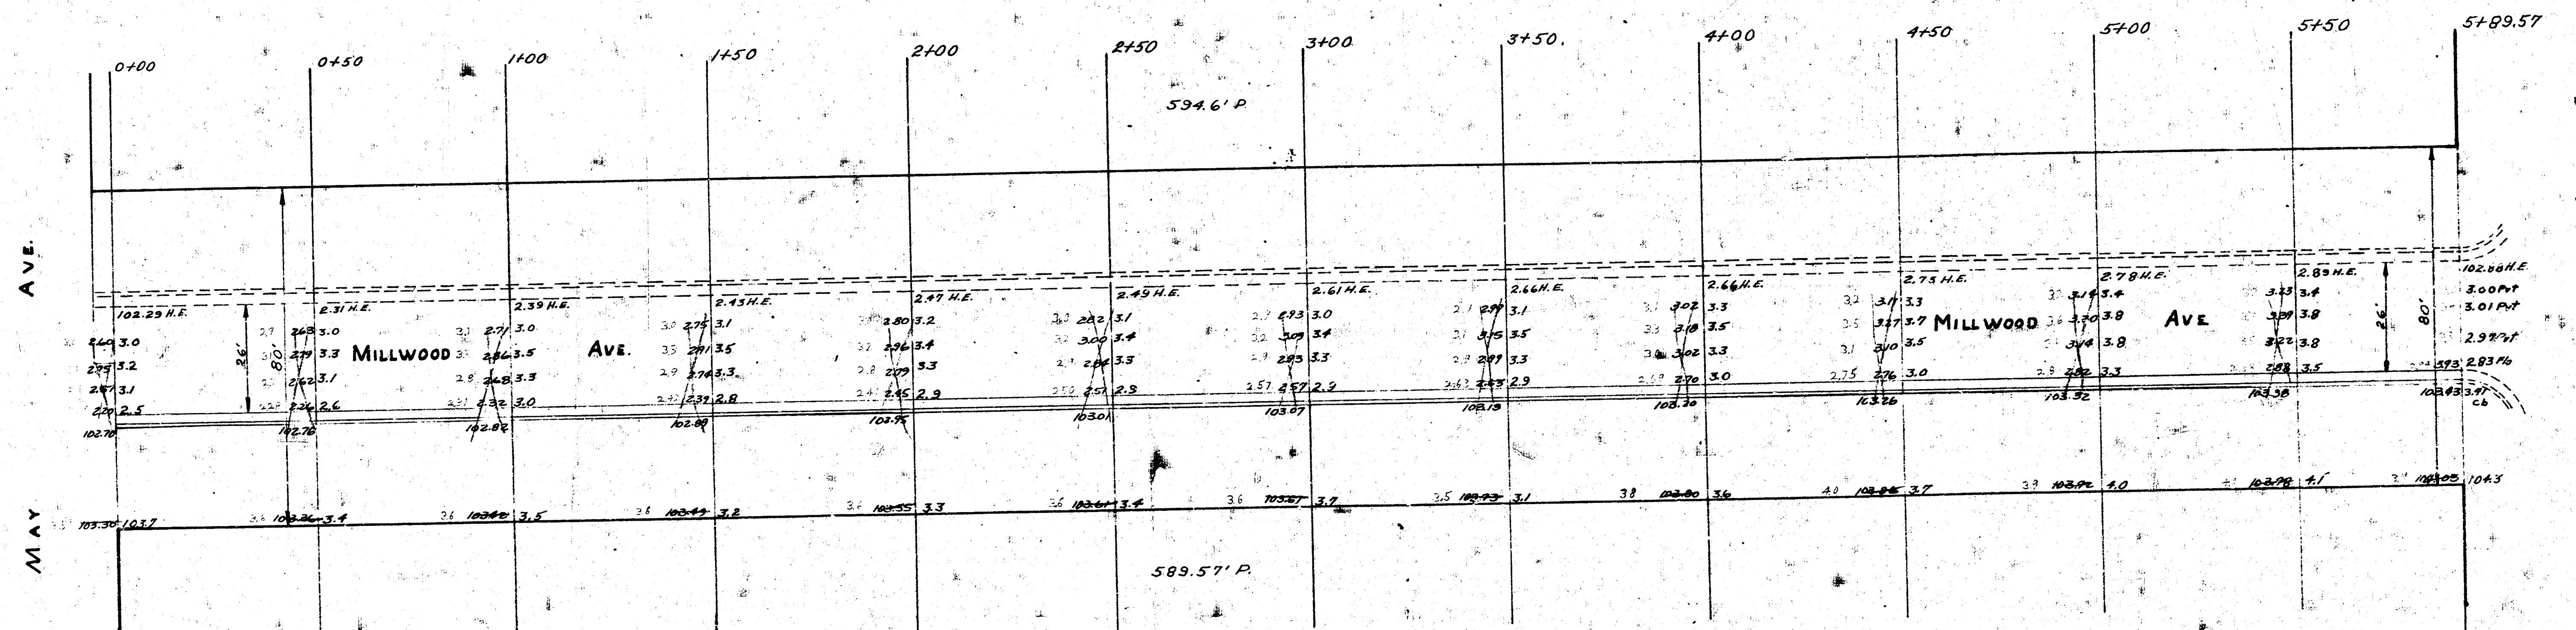

1/4 MILLWOOD AVE.
S.L. DORA AVE - N.L. MAY AVE.
COMB. CB. & GUTTER
CITY OF WICHITA, KANSAS
L. K. WHITE CITY ENGINEER
APRIL, 1950 PROJECT No. 10-19

Book 52 Pages 30-31

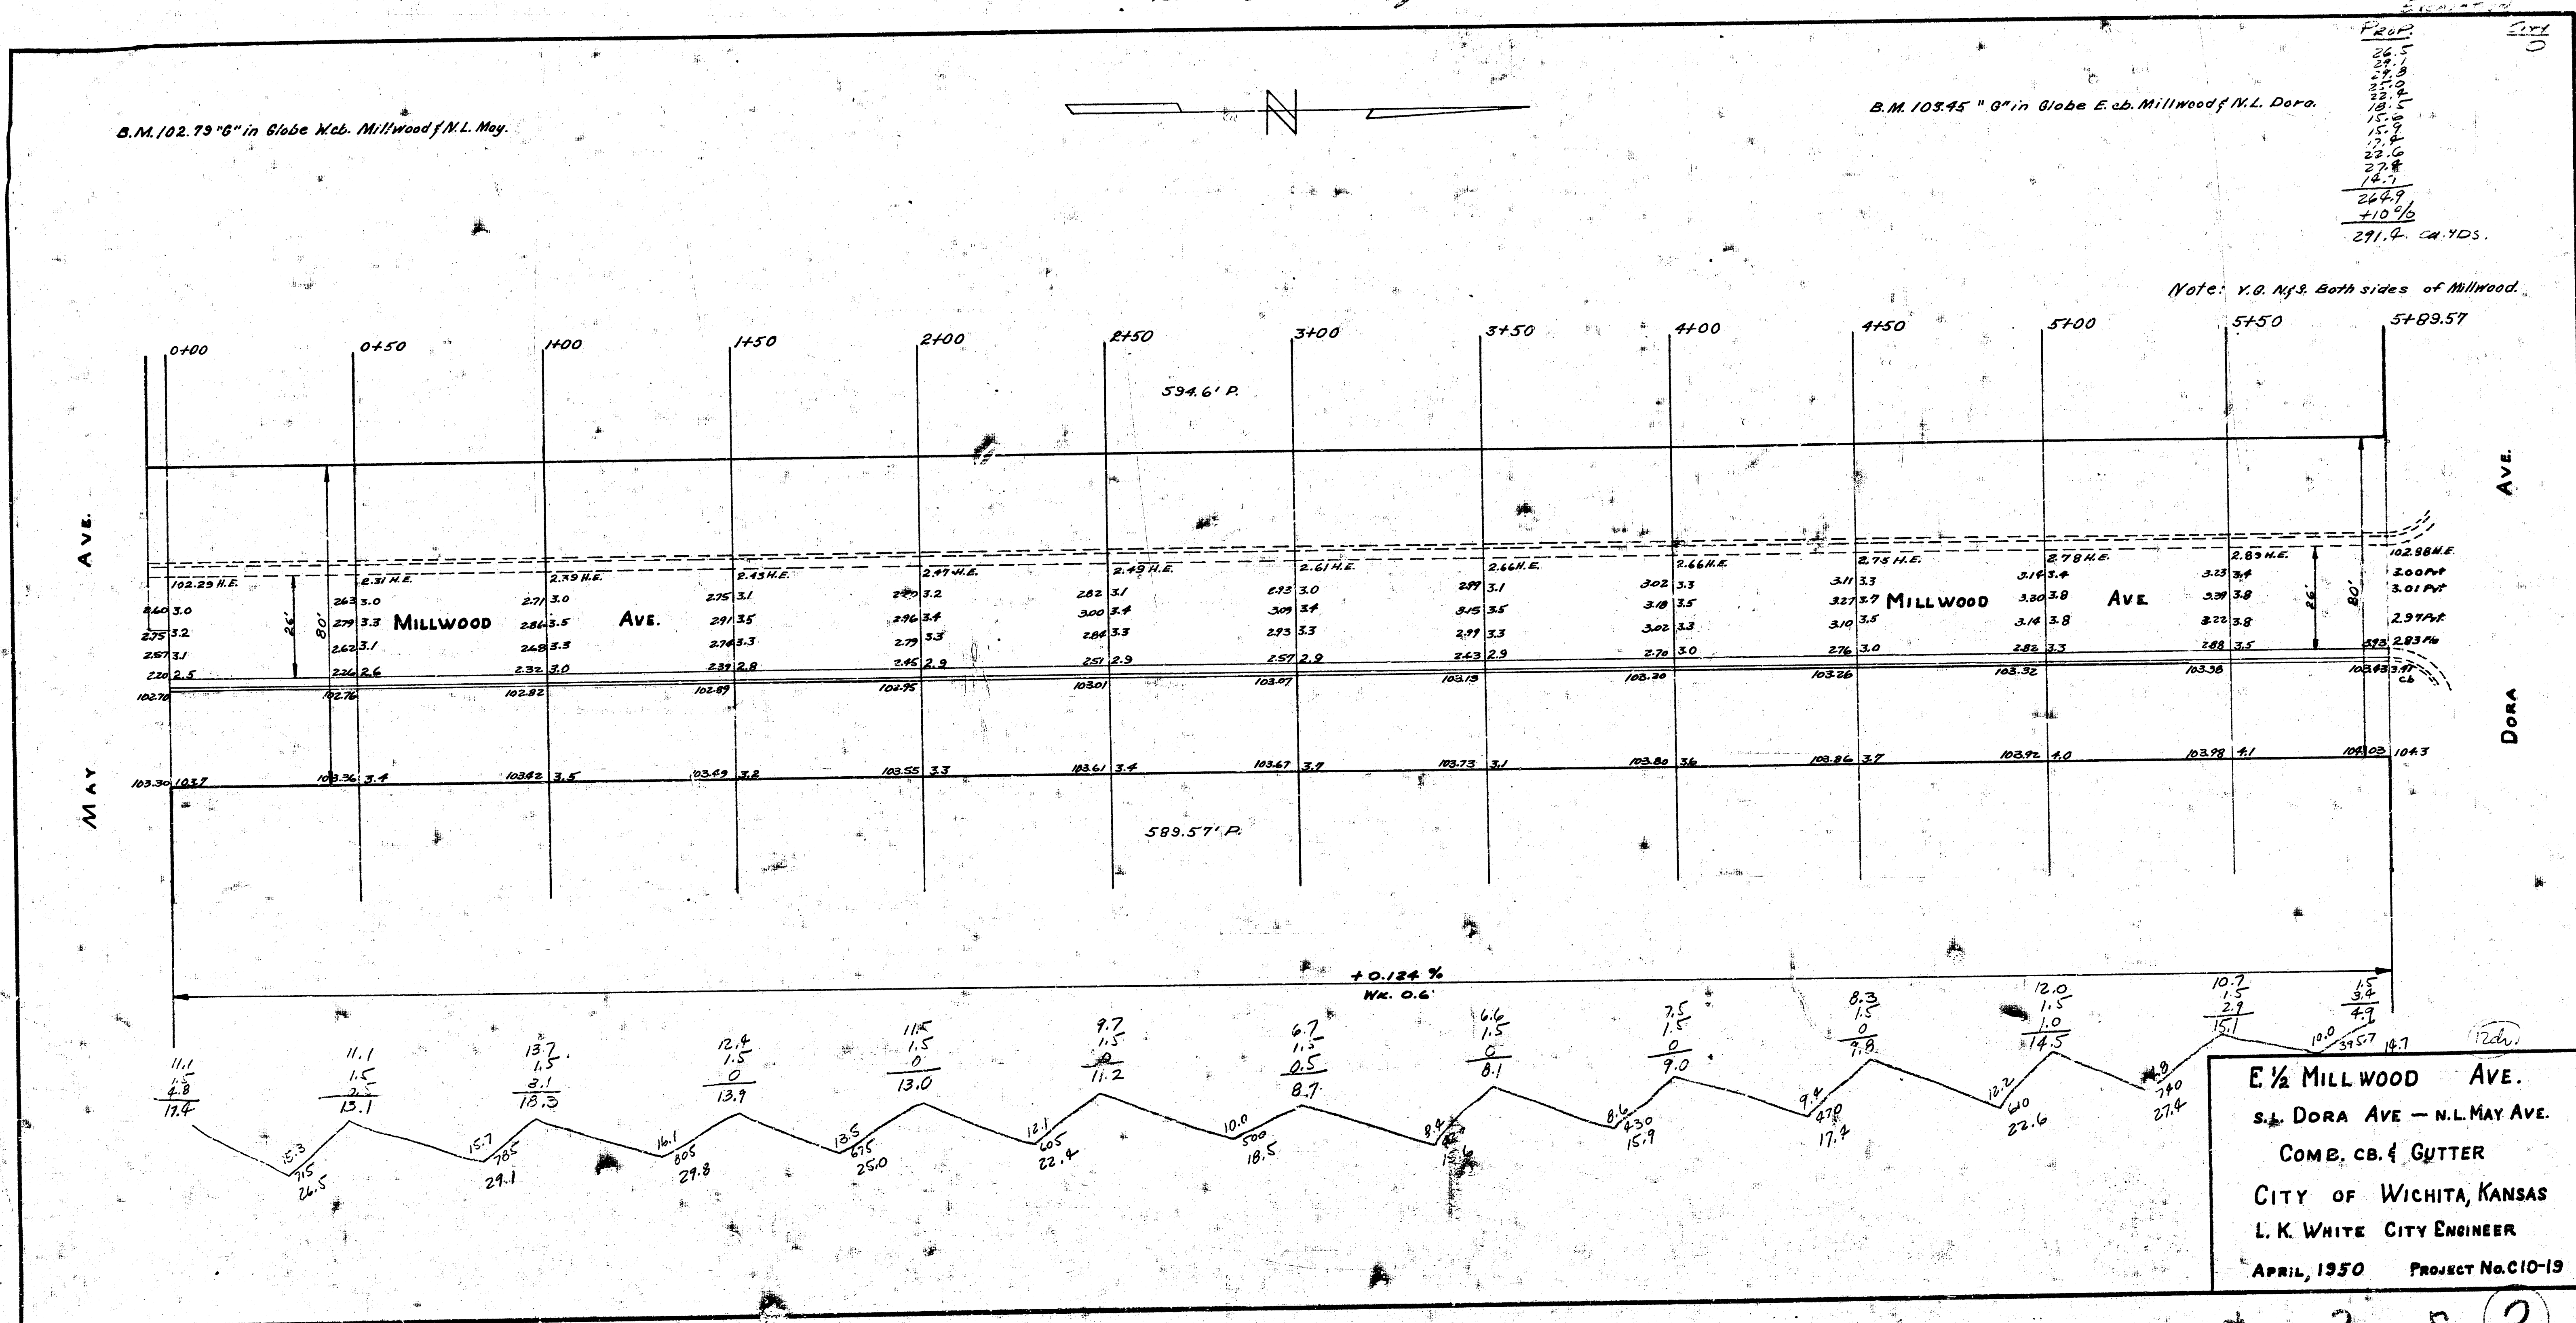

1941
 W.S. MILLWOOD AVE - N.L. MAY TO SL. DORA
~~MILLWOOD AVE - SL. DORA TO SL. ESTHER~~
 CB + GTR ONLY

