




BM 12336 S.E. Cor. Step Has #2002 N Minneapolis Ave

Prop. 1065.8
+ 10.7%
1109.7
252.1

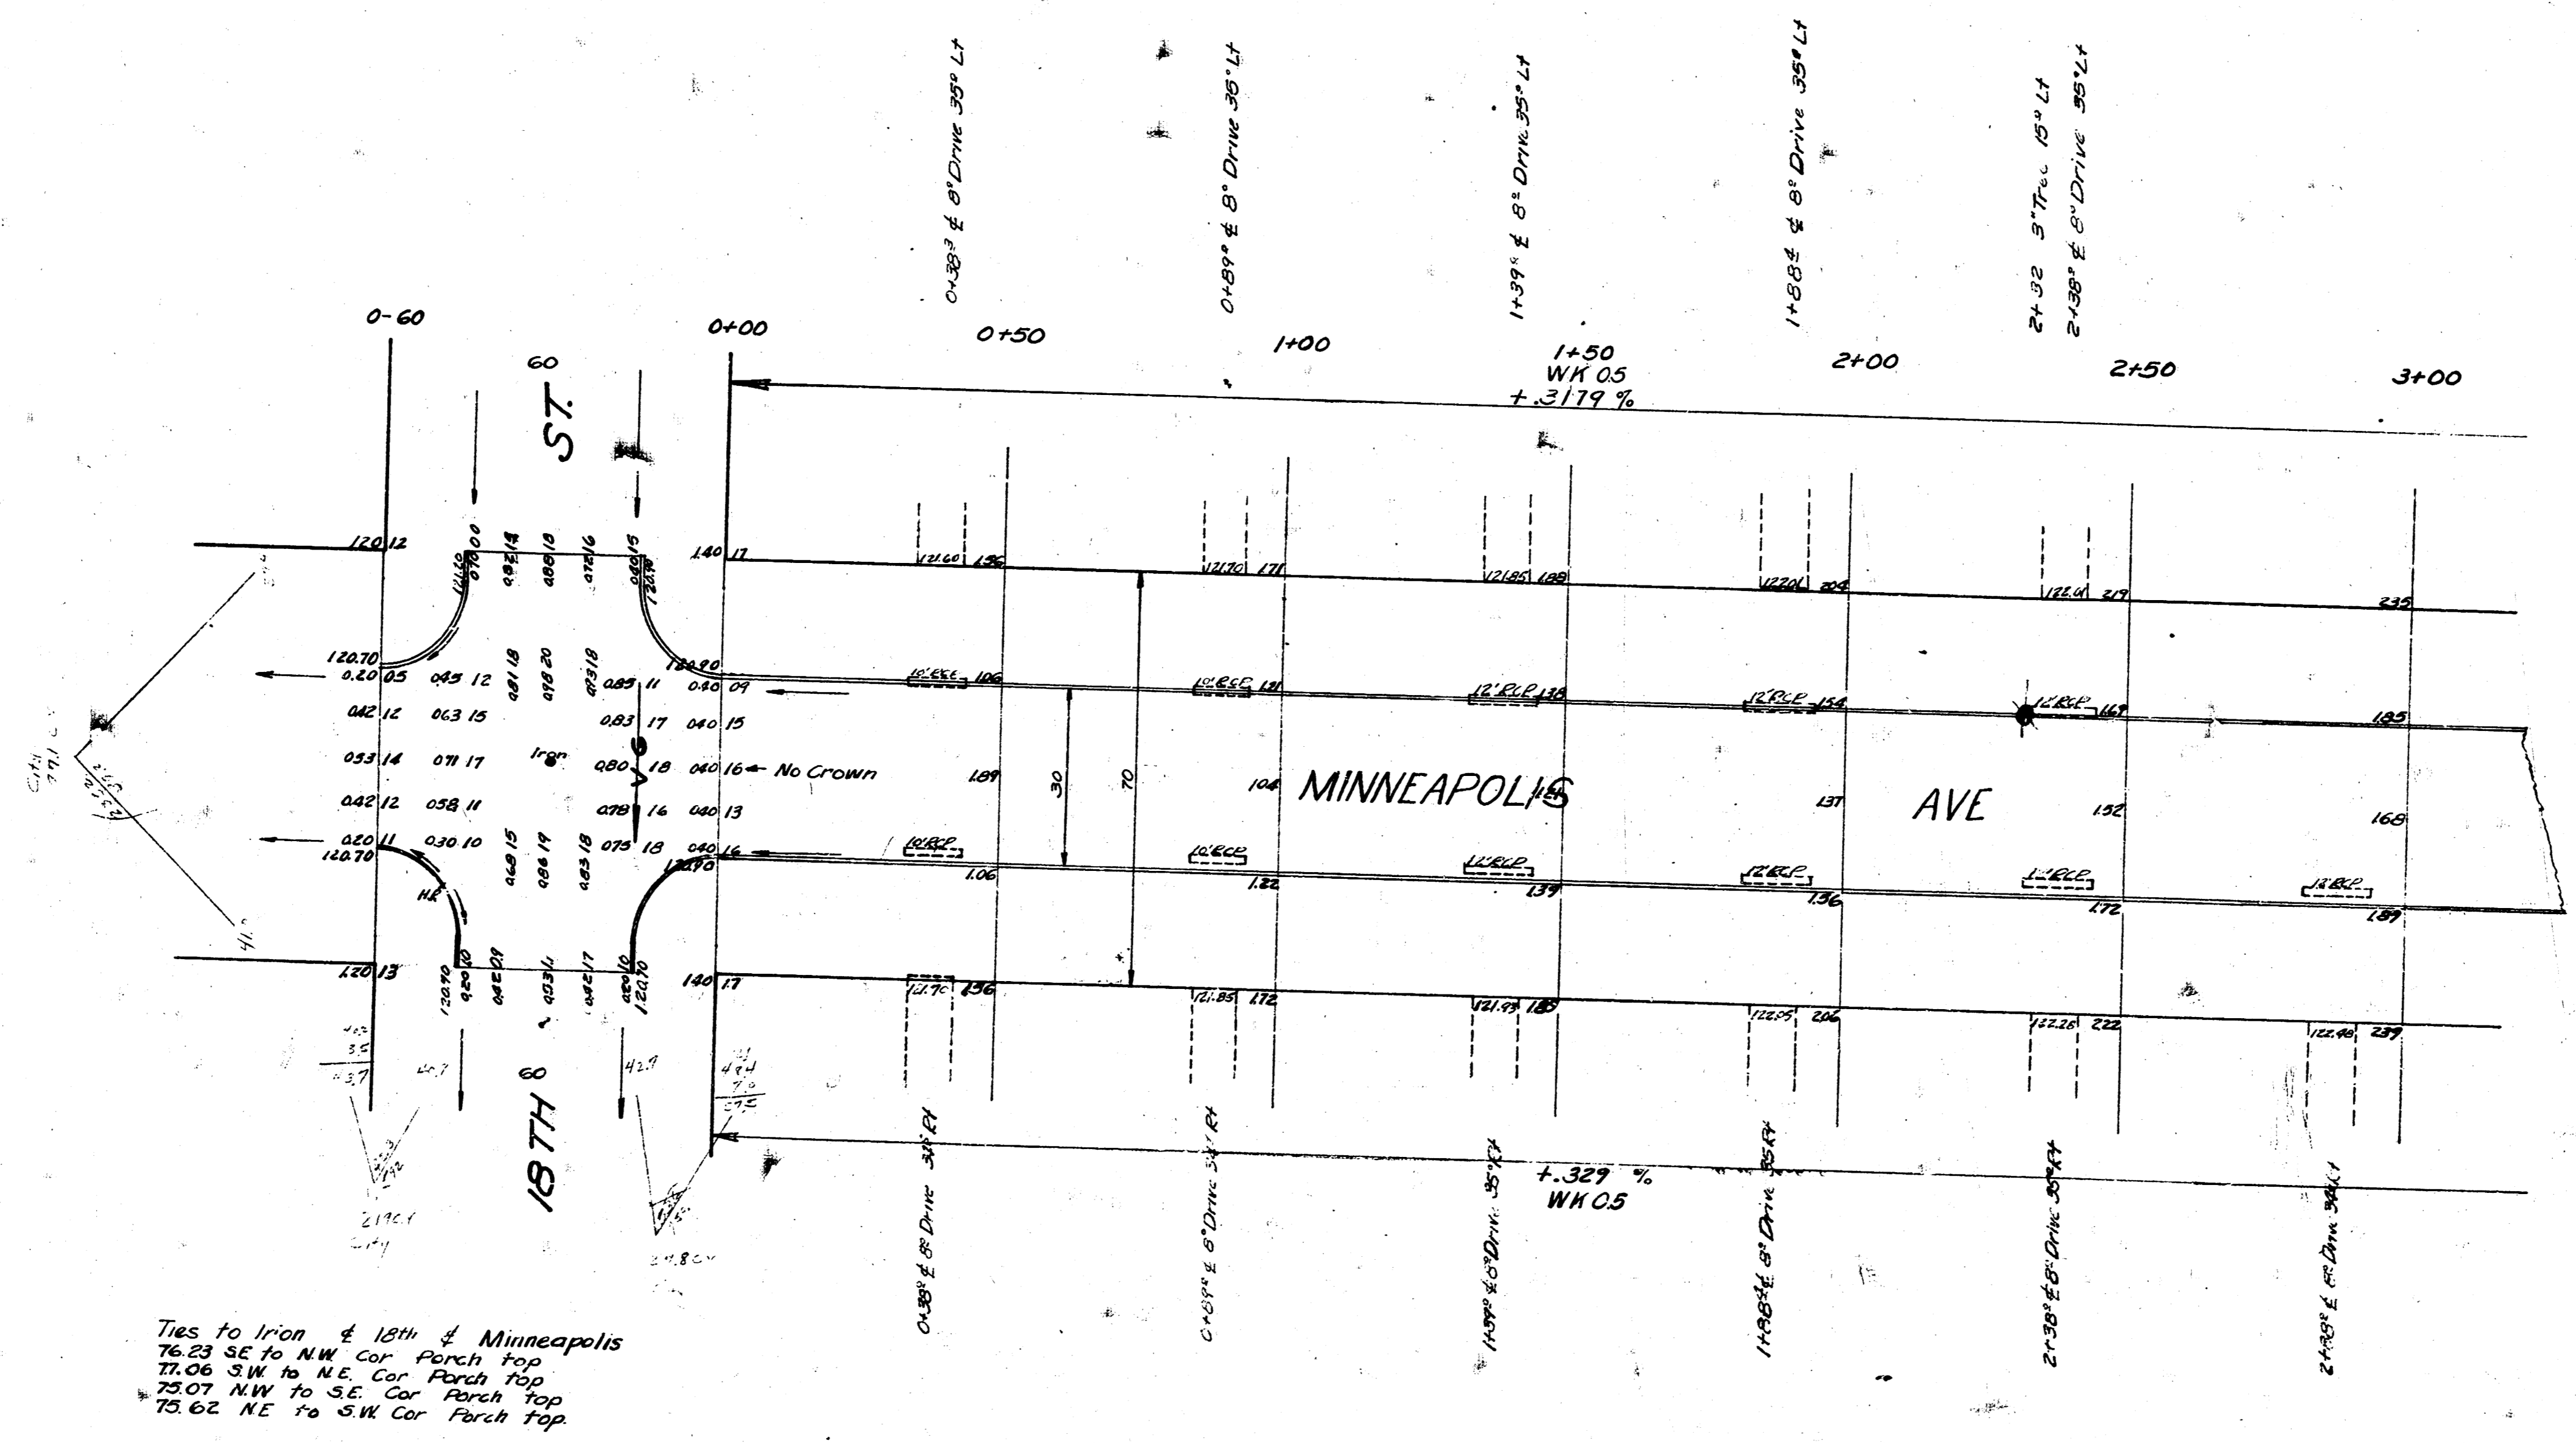

Ties to Iron @ 18th & Minneapolis

Note about Pot Pits

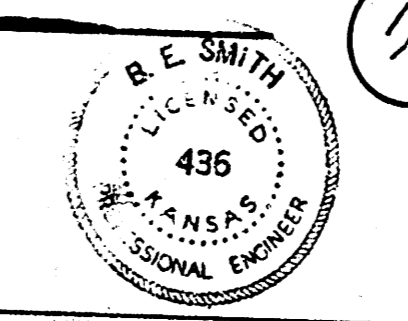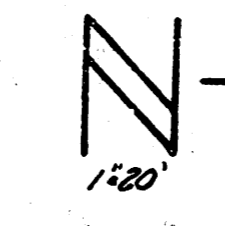

MINNEAPOLIS AVE.
S.L. 18TH ST. TO N.L. 19TH ST.
30' CONC. & Cb.
CITY OF WICHITA, KAN.
B.E. SMITH
Jan. 1953
CITY ENGINEER
Proj. No. C12-98

Survey by B.H.K. Checked

