



B.M. 108.23 N.E. Cor. Lower Step How 2001 Indianapolis & Orme Court

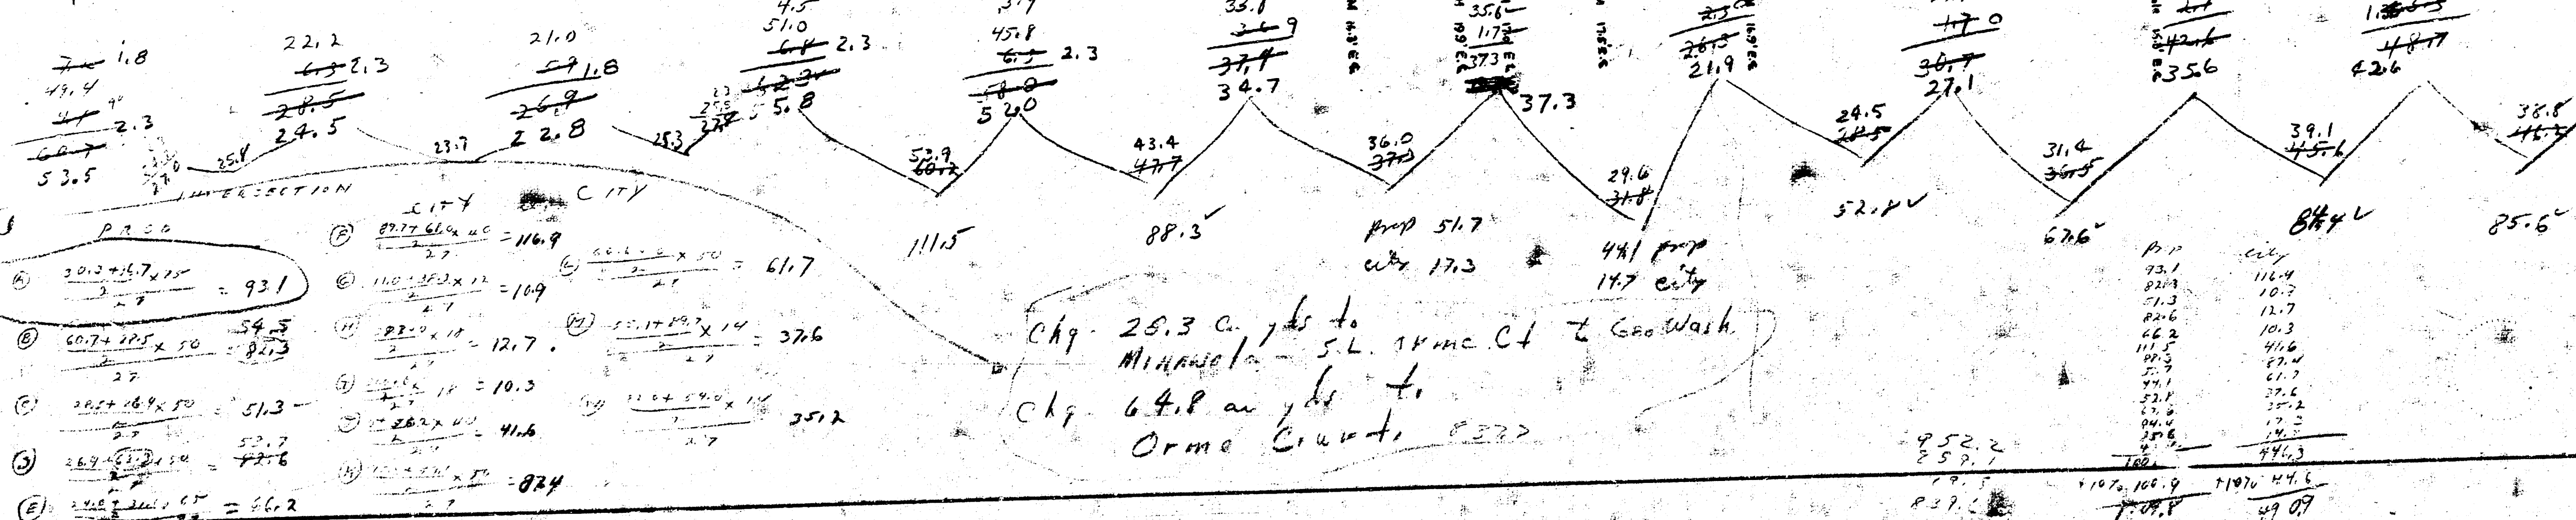

MINNESOTA AVE
S.L. KELLOGG TO N.L. GEO. WASHINGTON
30' CONCRETE & C.B.
CITY OF WICHITA, KANSAS
L.K. WHITE CITY ENGINEER
JULY-OCT 1946

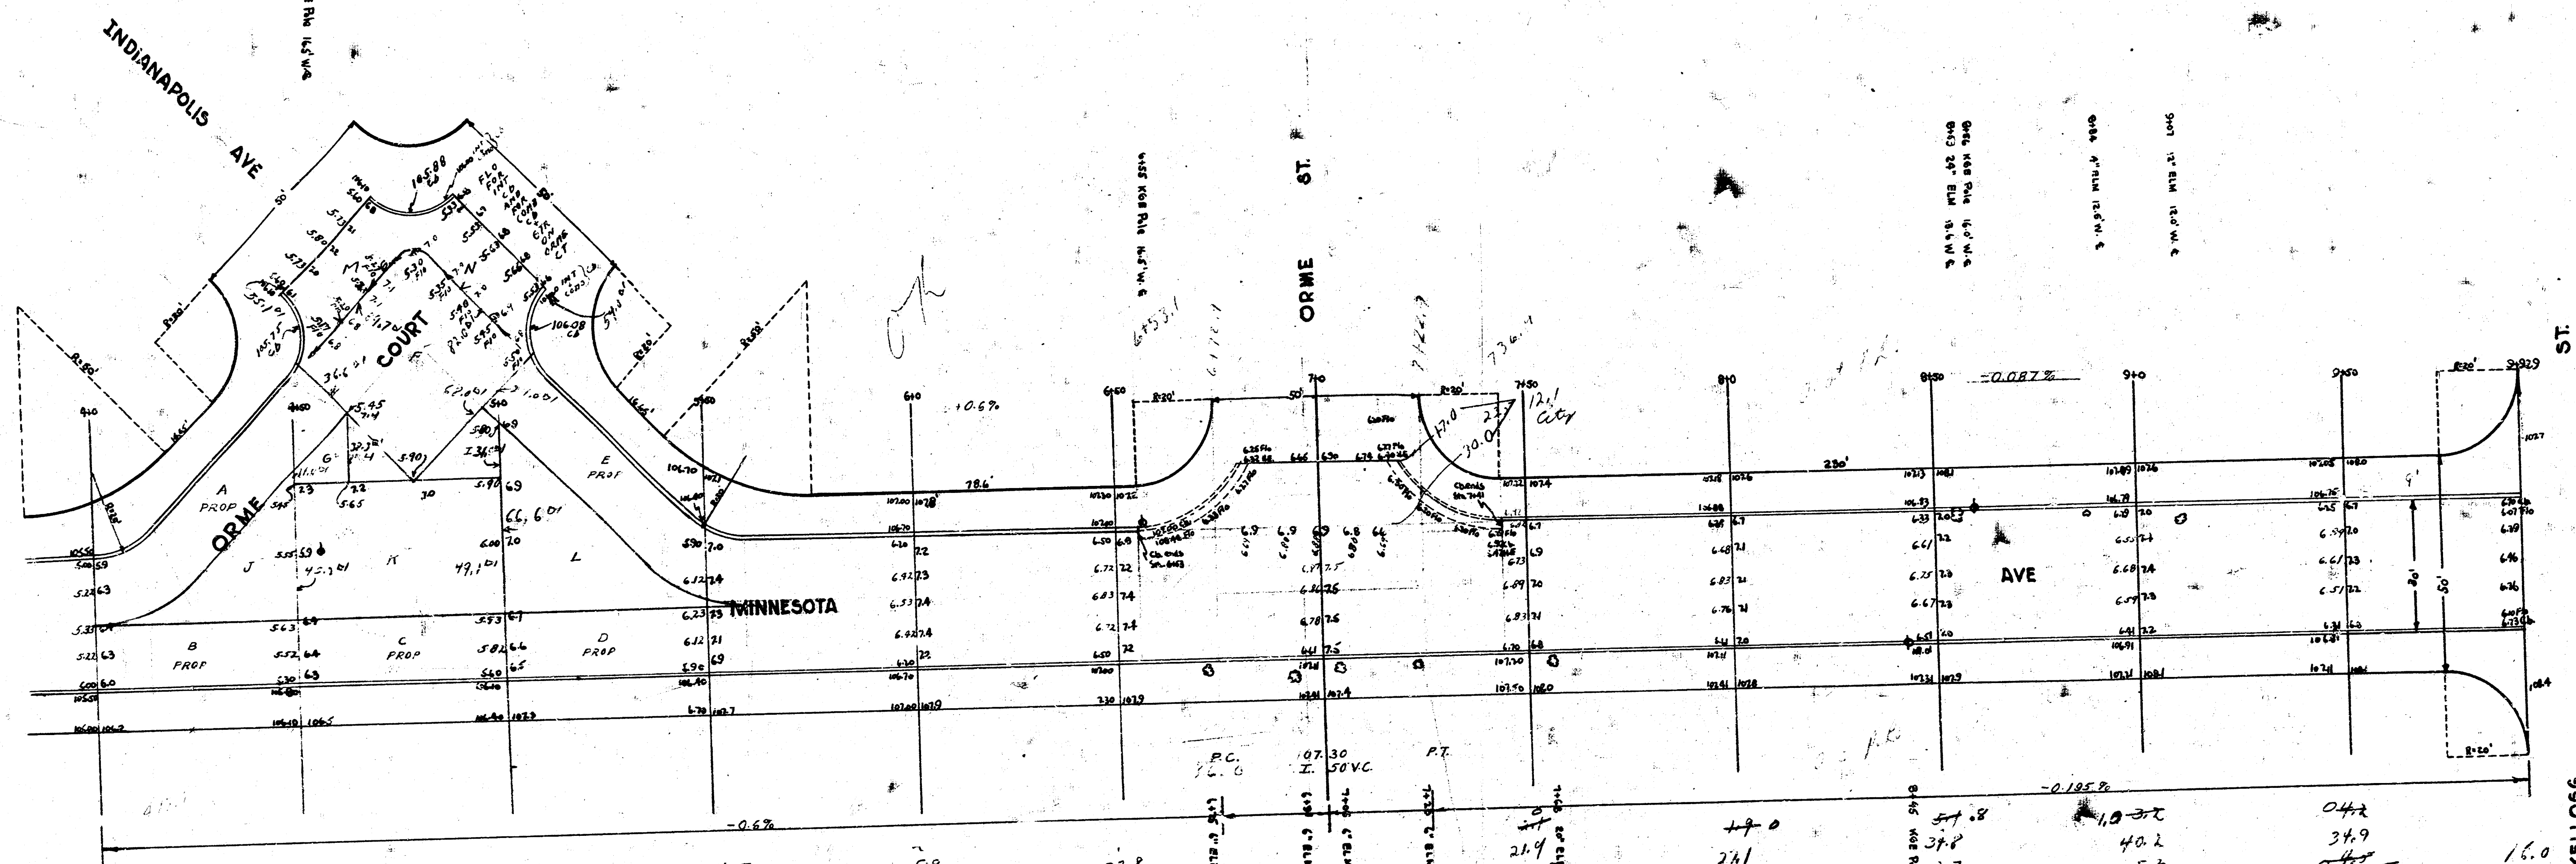