



1942
 OLIVER ST. - N.L. CENTRAL TO S.L. 9TH
 34' ASPHALT MAT - CENTRAL TO MURDOCK
 36'-2'-40" - 4' ASPHALT MAT - MURDOCK TO 9TH

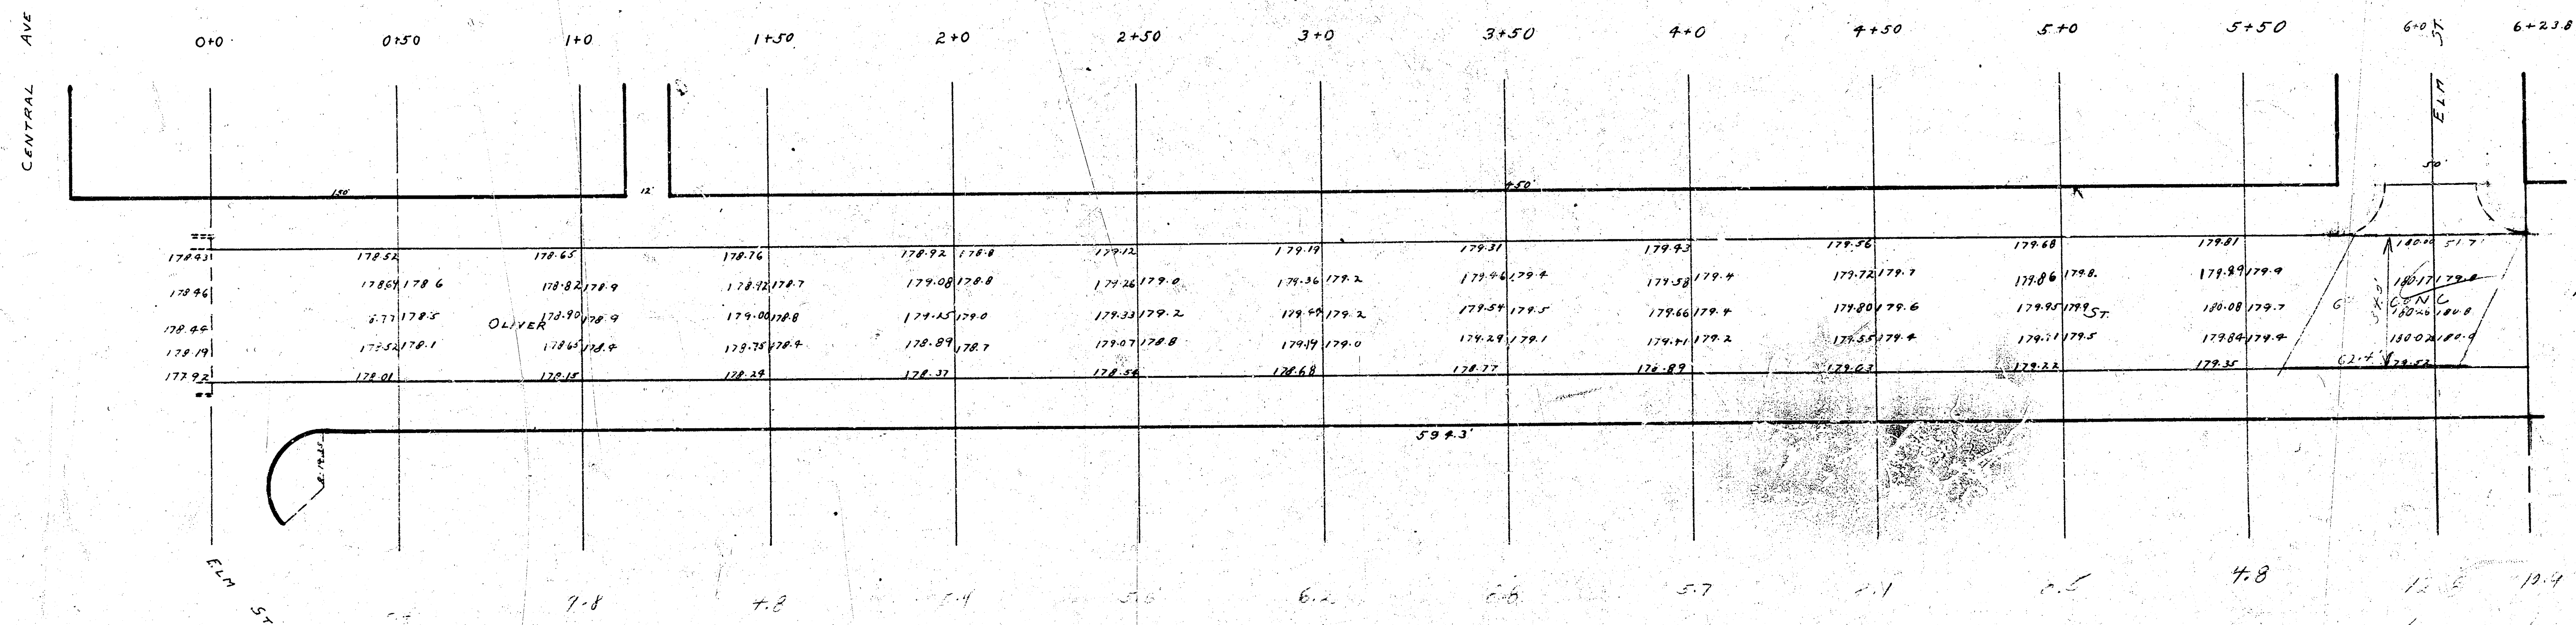

B.M. 177.60 C.B. N.W. SIDE OF ELM 65' N.E. OF N.E. COR OLIVER & CENTRAL

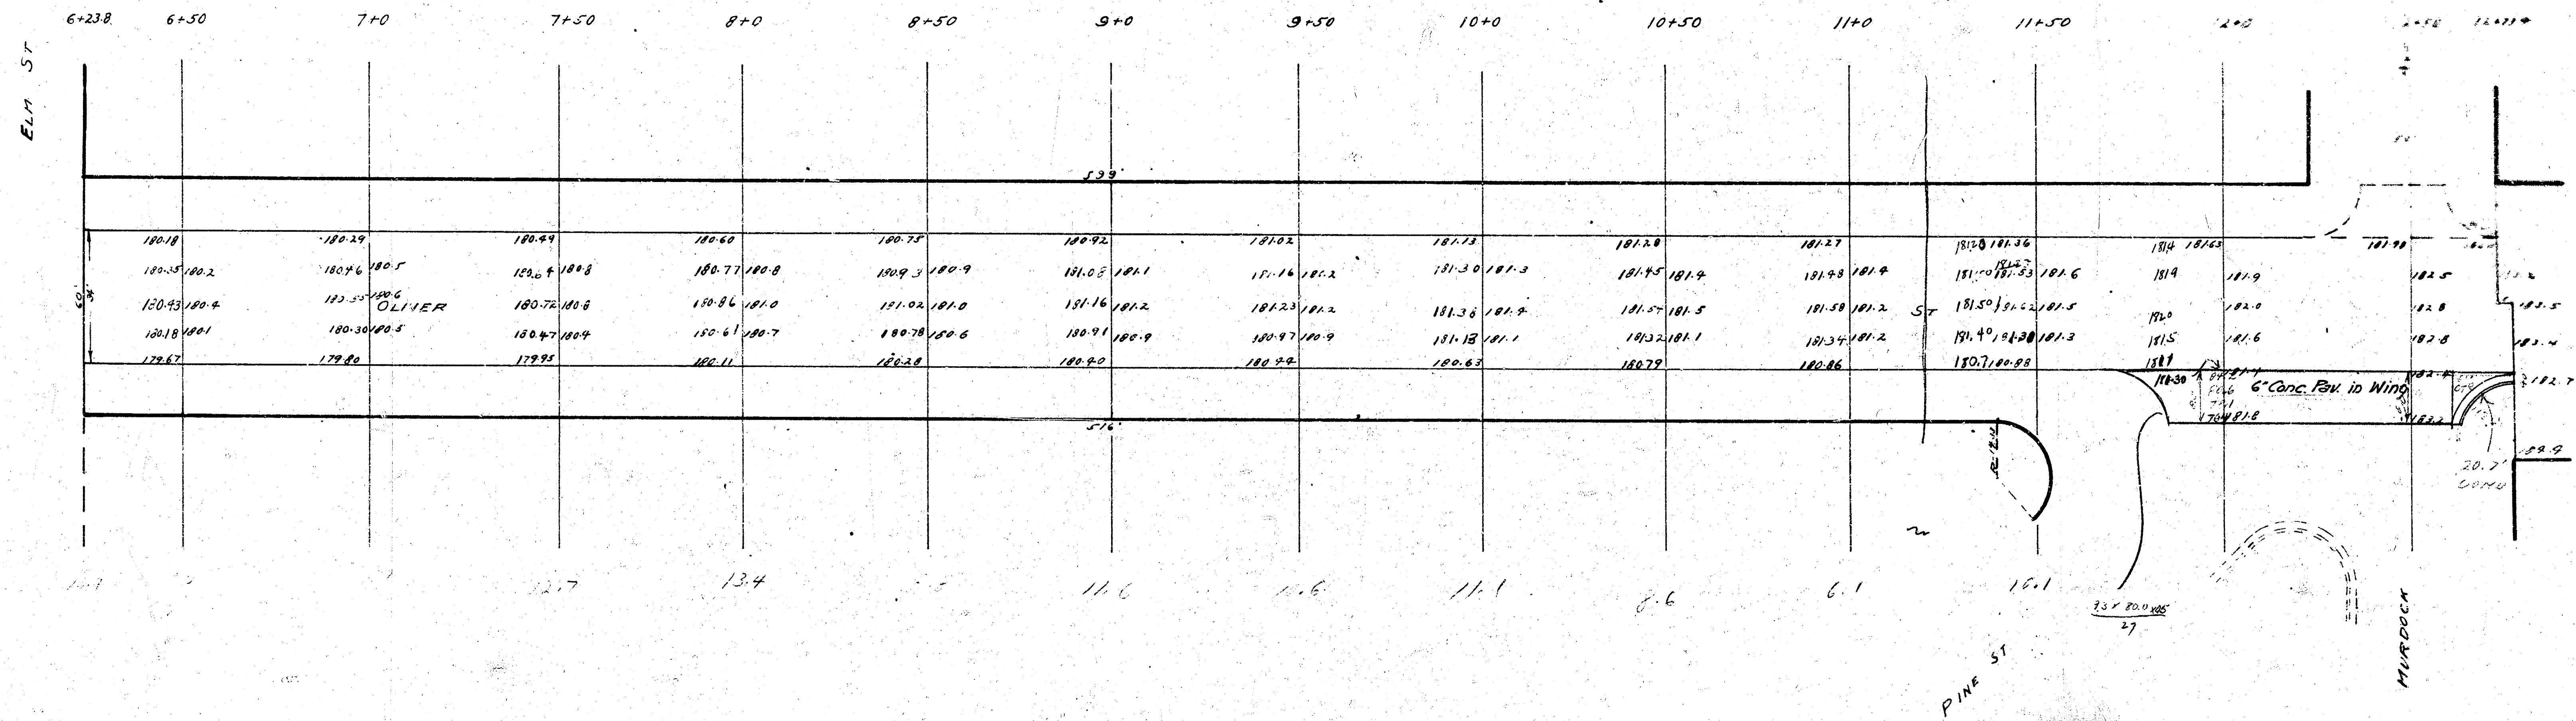

B.M. 183.67 "L" IN LUDLOW FIRE HYDRANT, S.E. COR. OLIVER + MURDOCK.

