


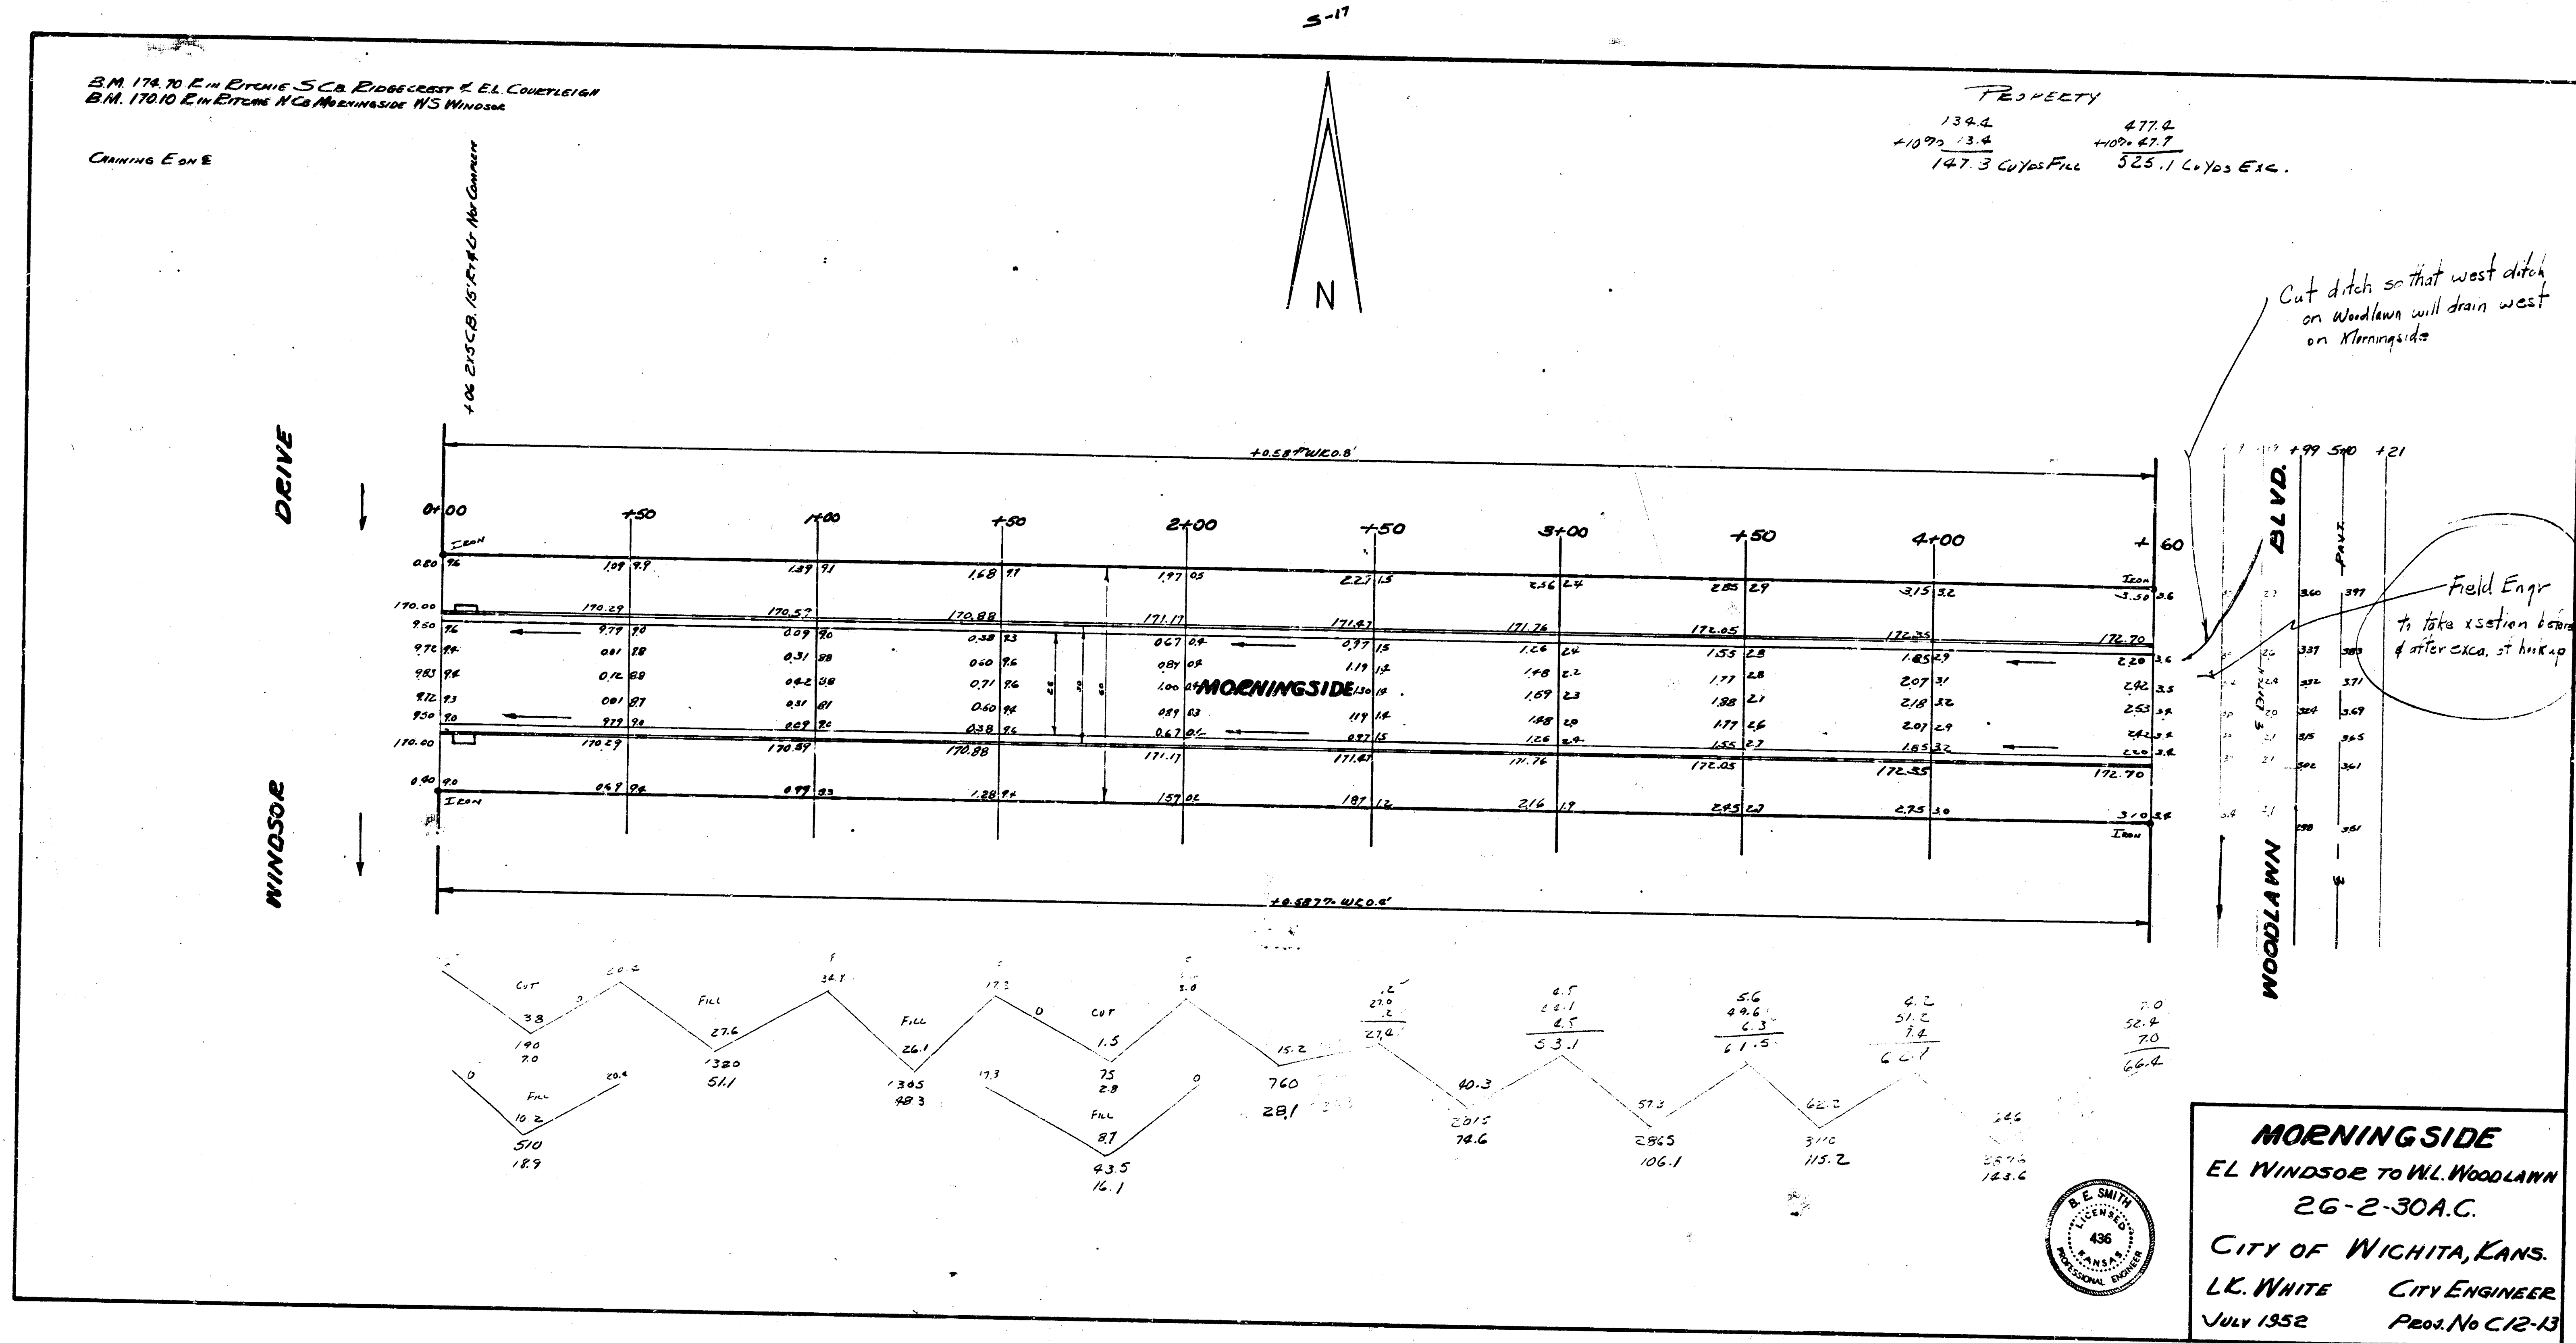

1 5 5 2