


B.M. 163.03 S.E. COR. STEP HO #755 SO. CRESTWAY

B.M. 162.62 "G" IN GLOBE SO. END S.W. RET. MORRIS & TERRACE DR.

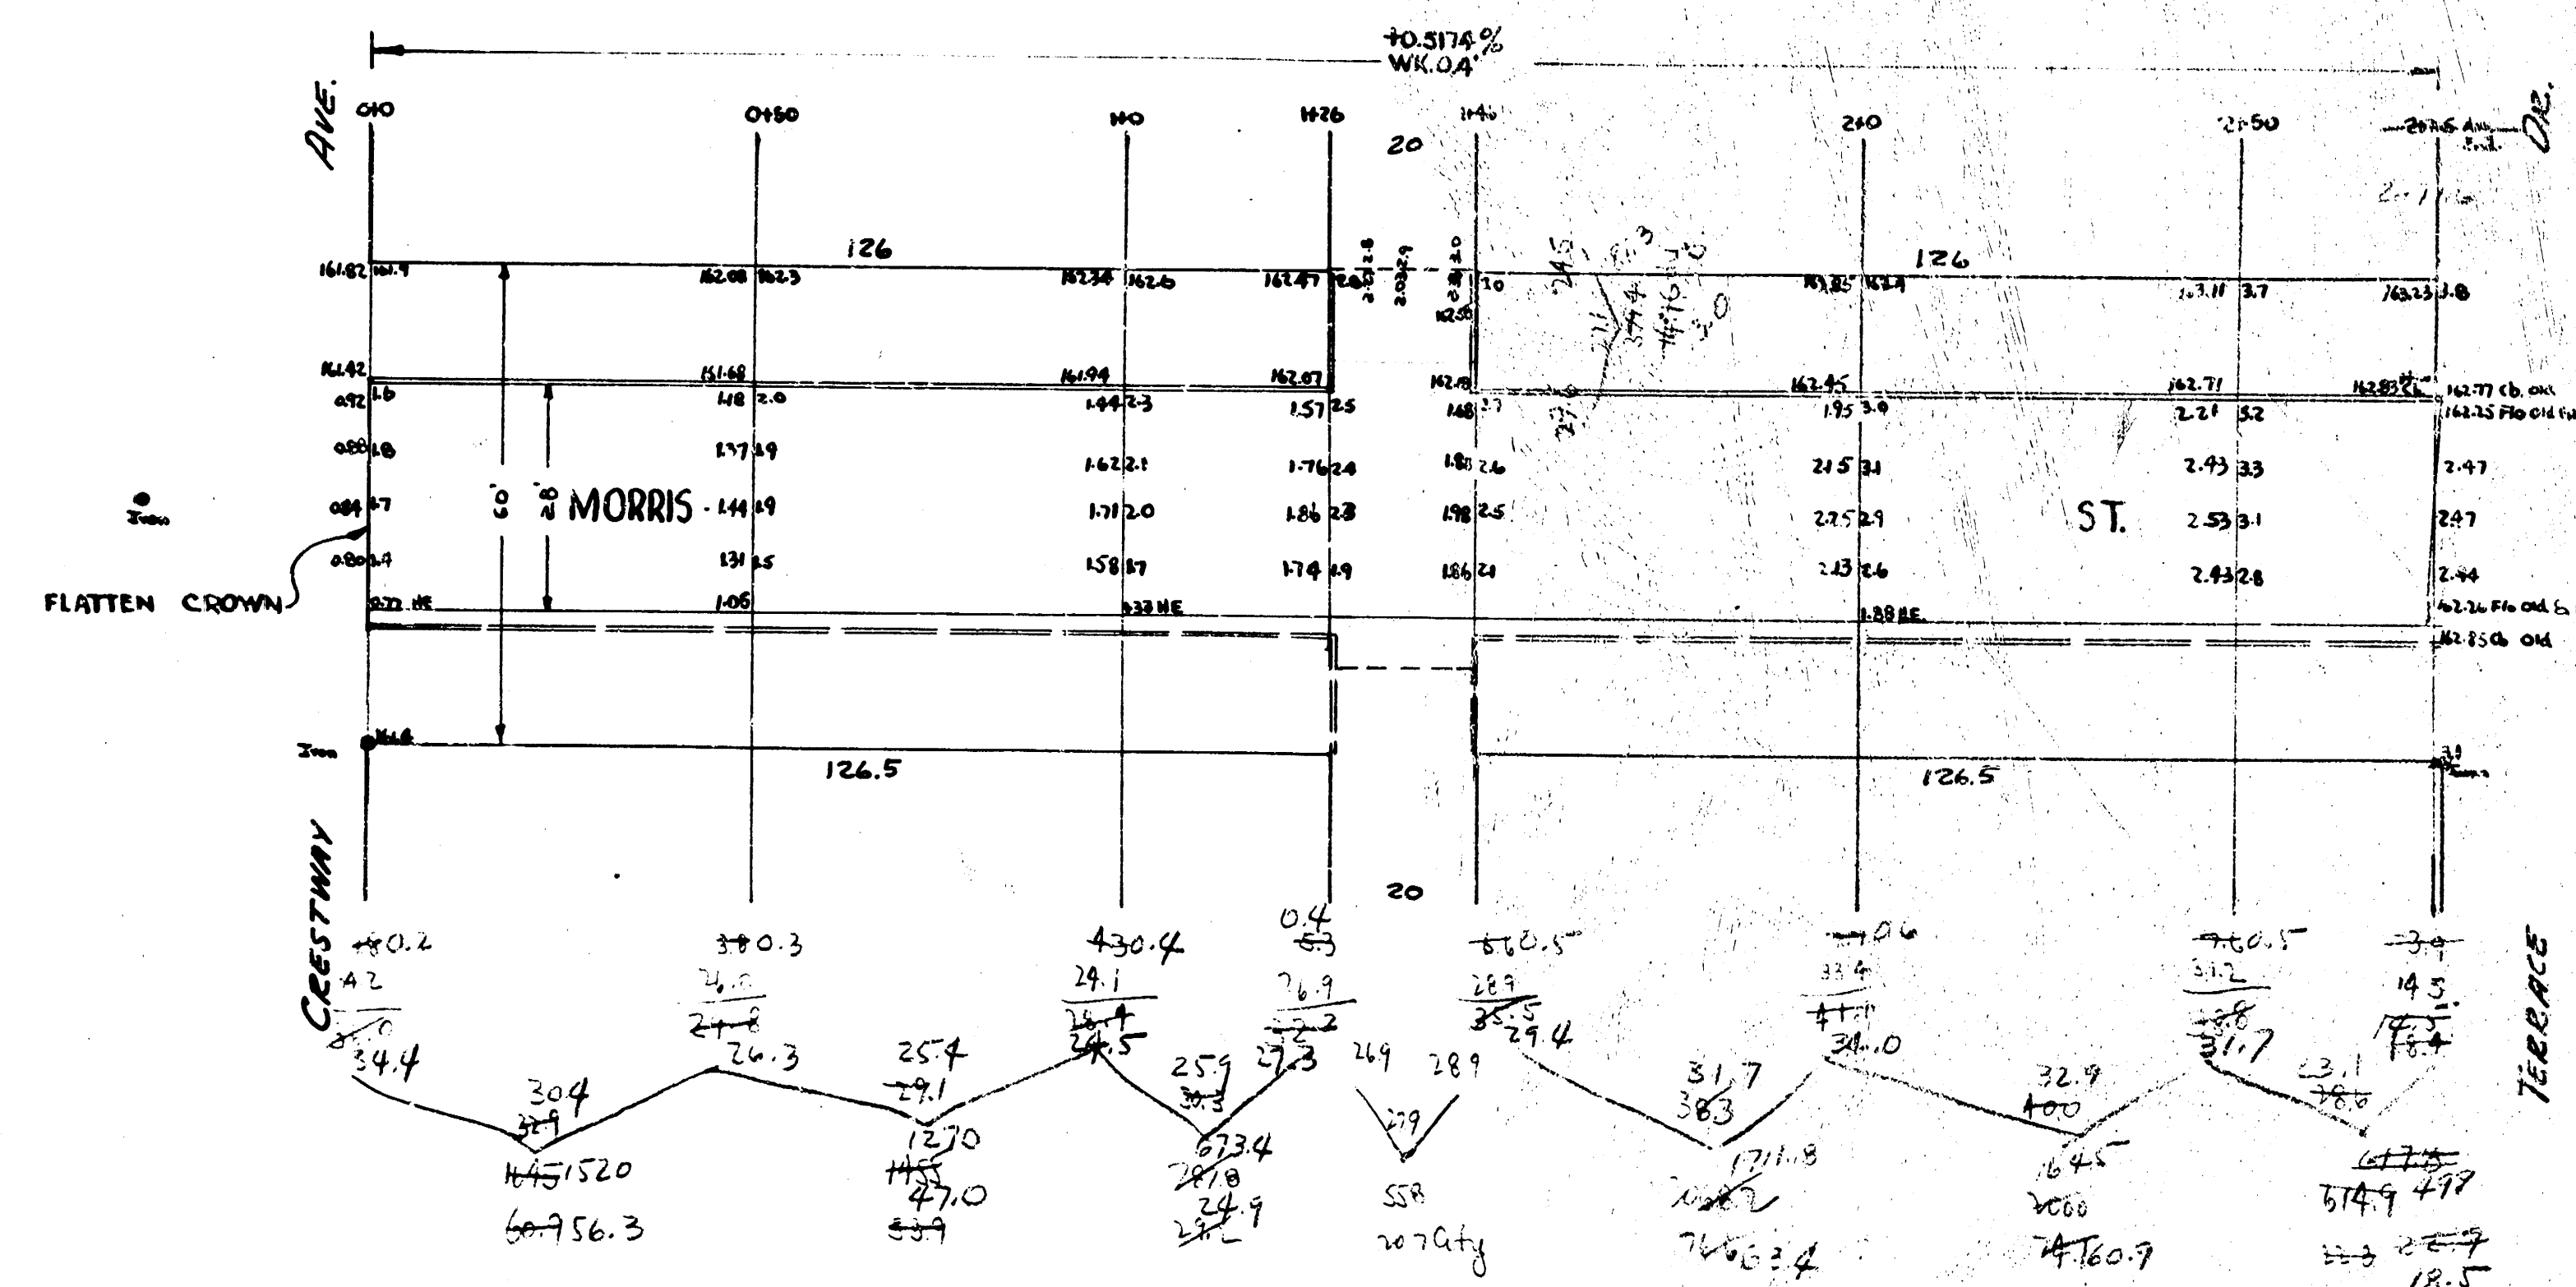

MORRIS ST.
E.L. CRESTWAY TO W.L. TERRACE DR.
28' CONC. & C.B. N.S.
CITY OF WICHITA, KANSAS
L.K. WHITE CITY ENGINEER
4-14-49 PROJ. C19-51