

B.M. 104.35 "G" in Globe E. end Rod E.L. Kansas f.S. Morris

B.M. 104.29 "G" in Globe end Radius W.L. Minneapolis f.S. Morris


DEFLECTIONS

0+20	0'	00'
0+75	0'	03'
1+20	0'	07'
1+75	0'	12'

NOTE: STATIONED ON CENTER LINE

PROPERTY

96.9
127.0
91.1
61.5
25.1
401.6
40.2 + 10%
441.8 Total Cu Up Excavation

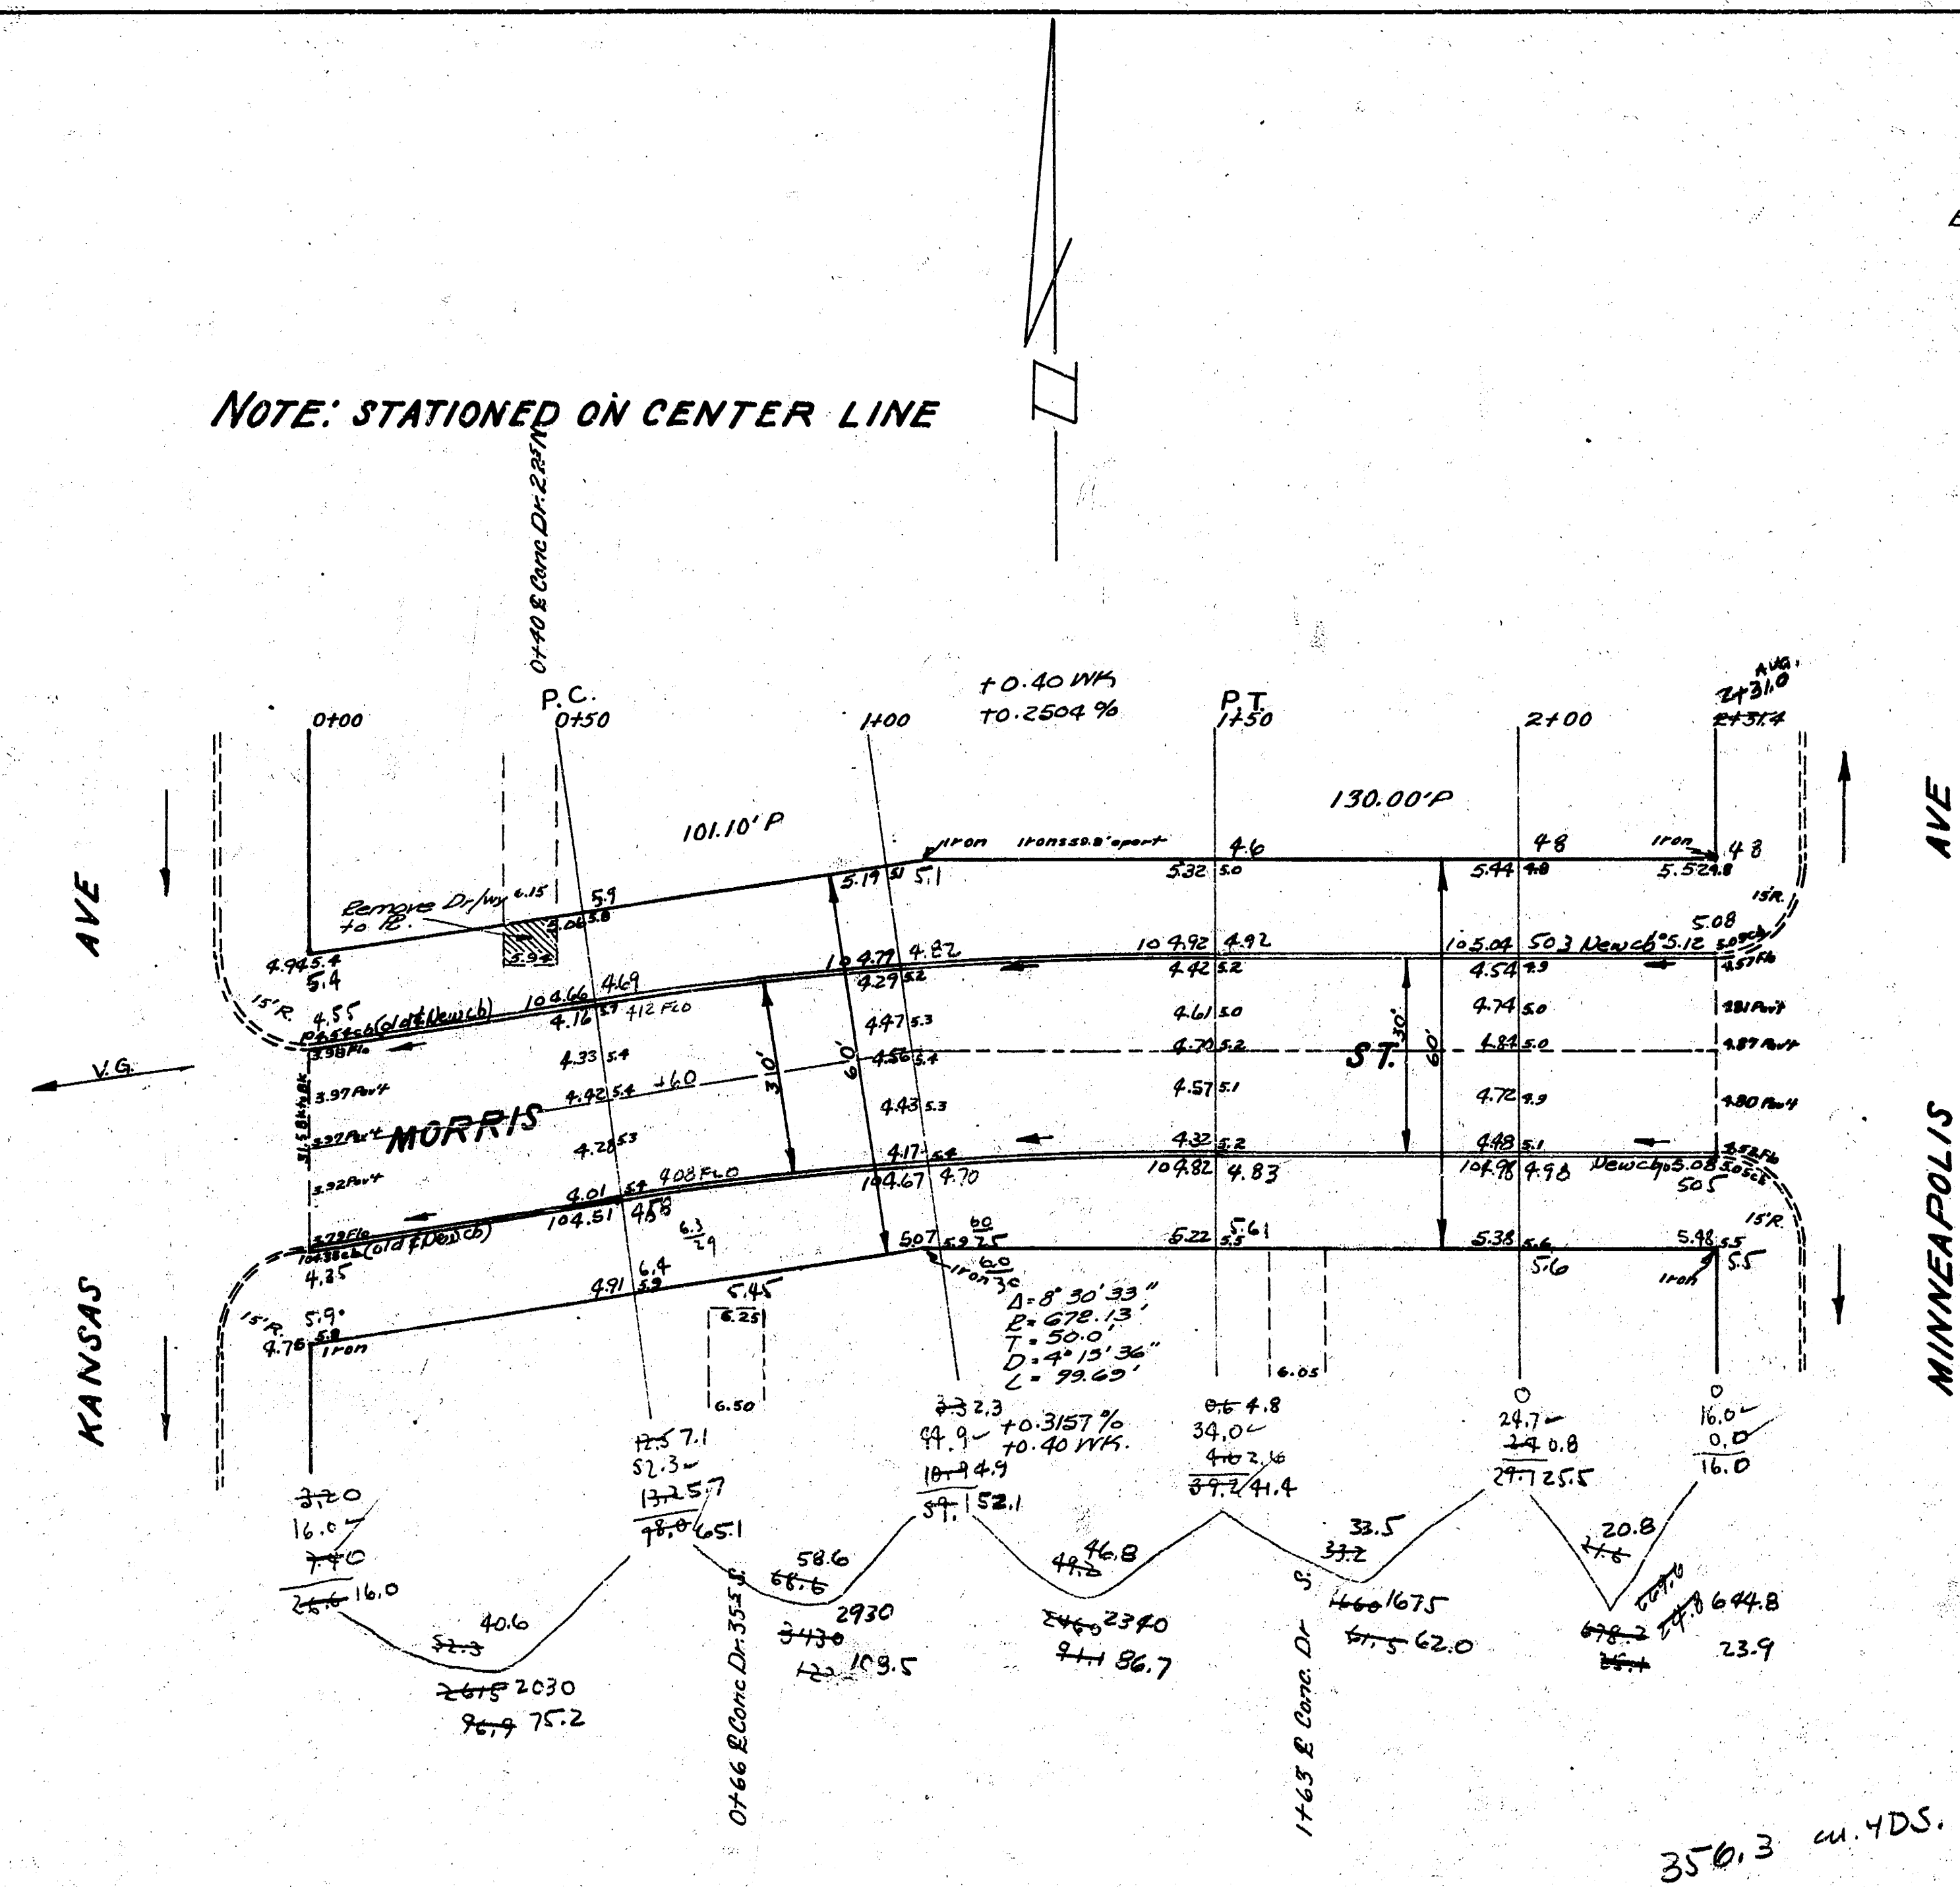

MORRIS ST.

E.L. KANSAS AVE. W.L. MINNEAPOLIS

50' CONC. & CB.

CITY OF WICHITA, KANSAS

L.K. WHITE CITY ENGINEER

JANUARY 13, 1951 PROJ. NO. C10205

