



181
 Re X section BK-K8

BM 16266 'M' in Mueller F. Hyd. NW Cor. Lightner & Morris


Exc.
 Prop. City
 200.0
 217.8
 174.3
 148.0
 53.8
 54.0
 88.1
 219.4
 1011.3 cu. yds.

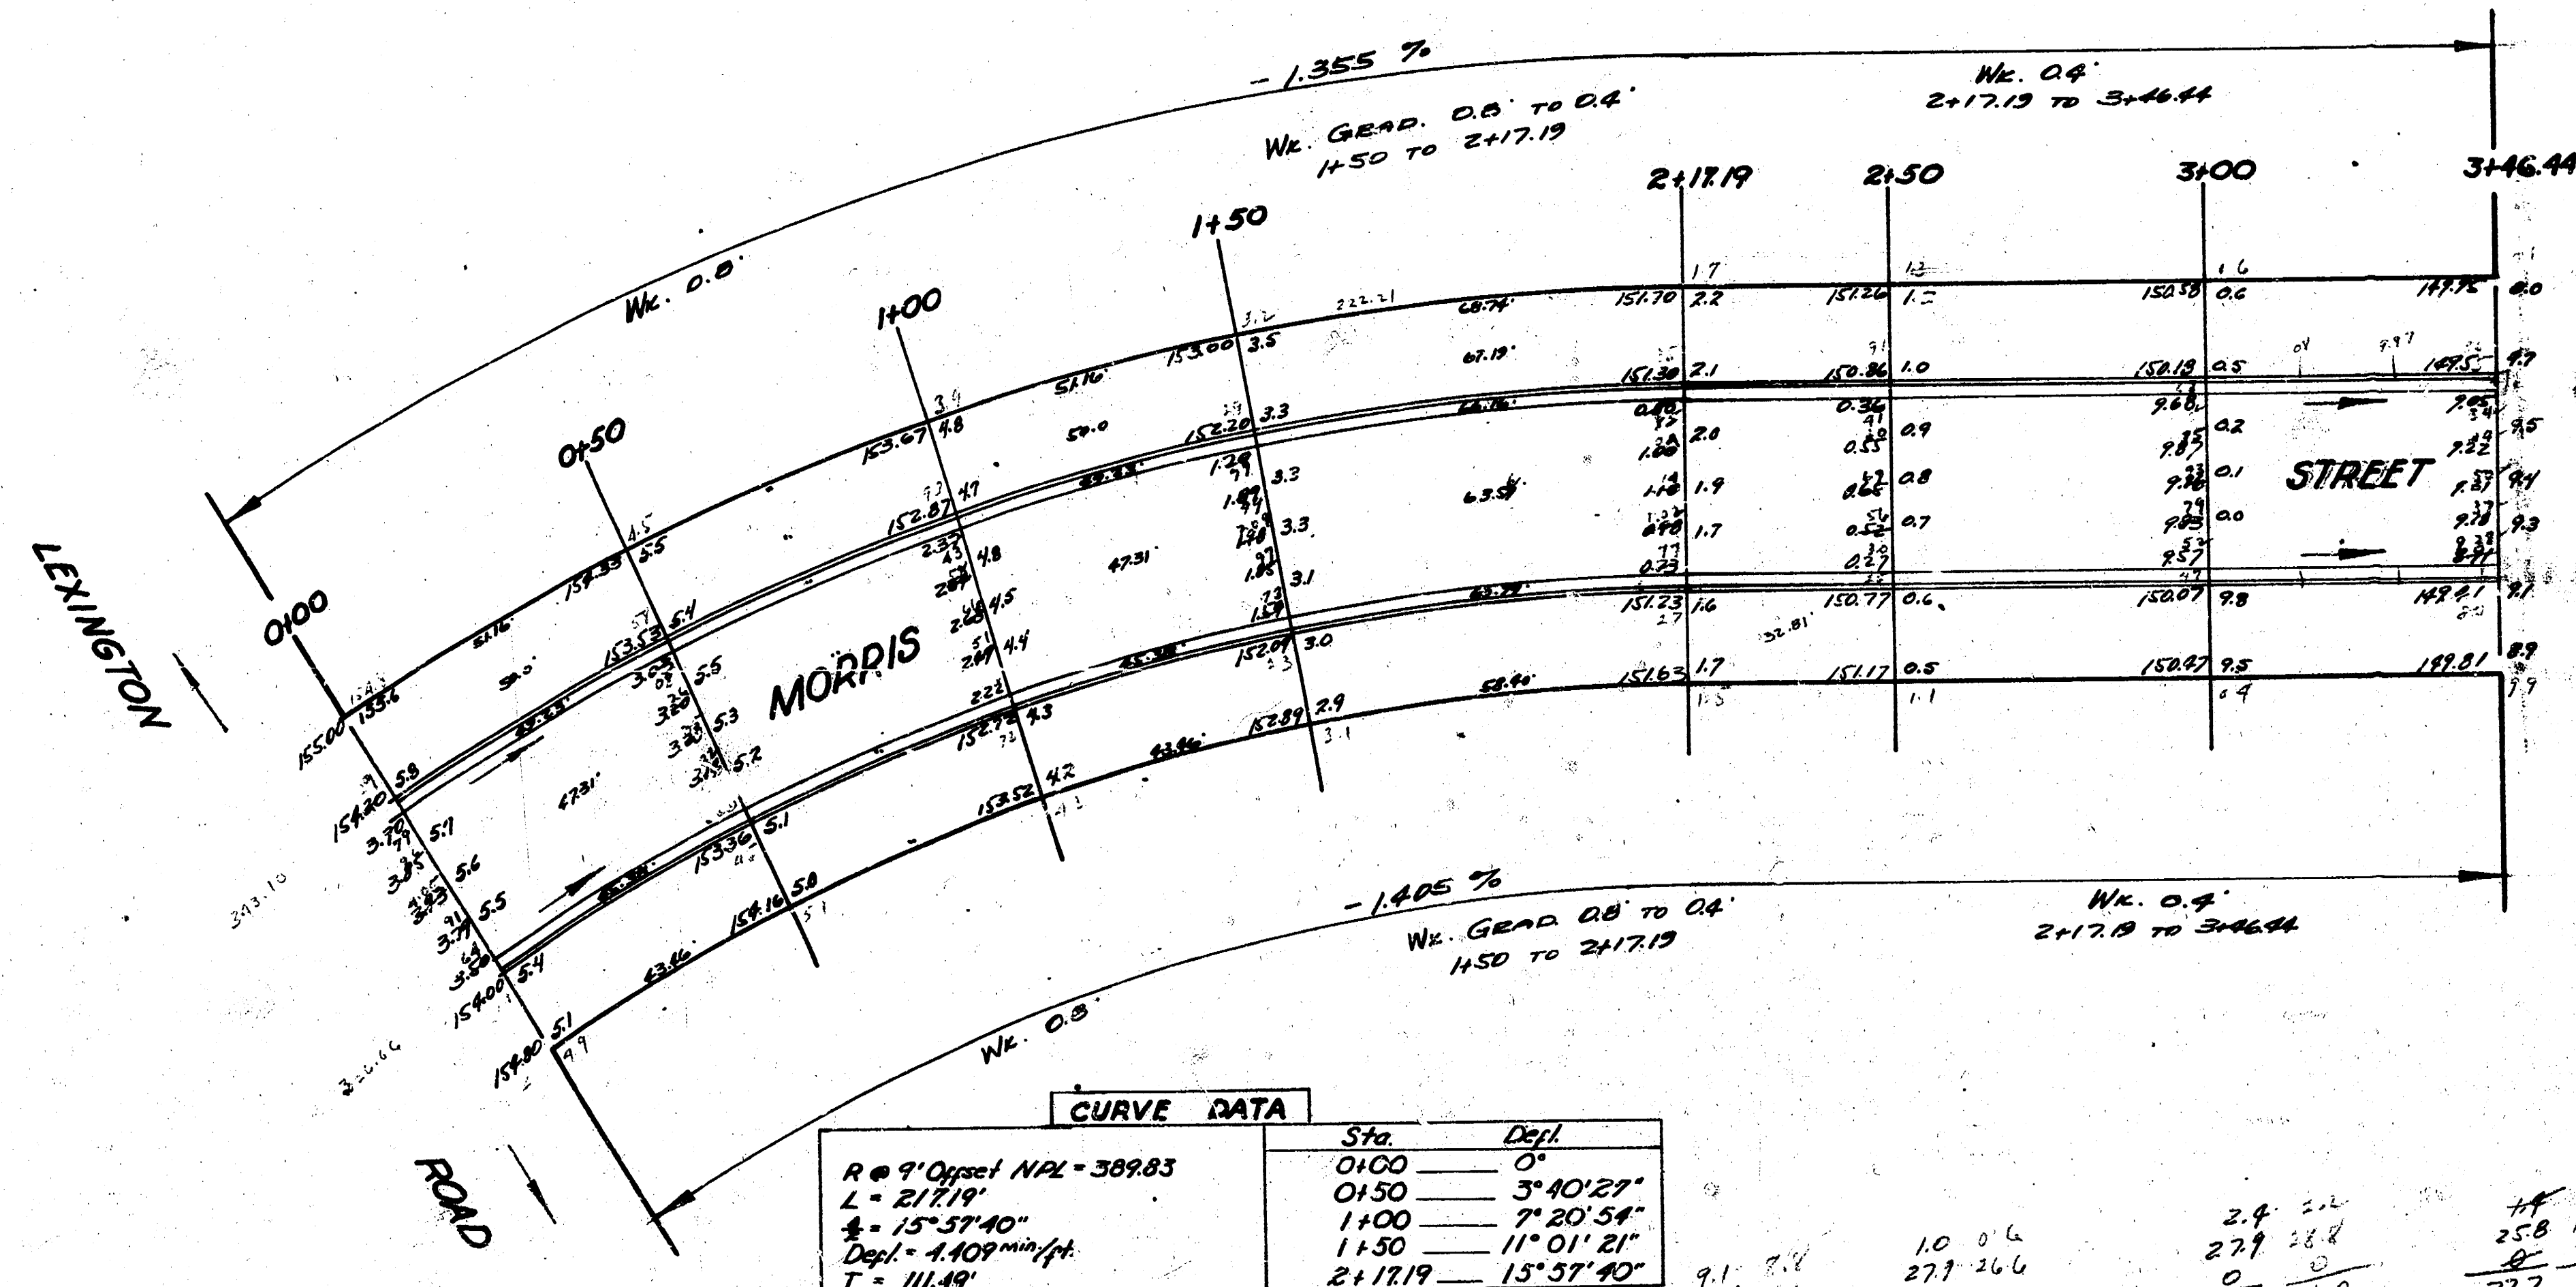

CURVE DATA	
R = 389.83	Sta. 0+00
L = 217.19	Sta. 0+50
Δ = 15° 57' 40"	Sta. 1+00
Dep't = 4.409' min. ft.	Sta. 1+50
T = 111.48	Sta. 2+17.19

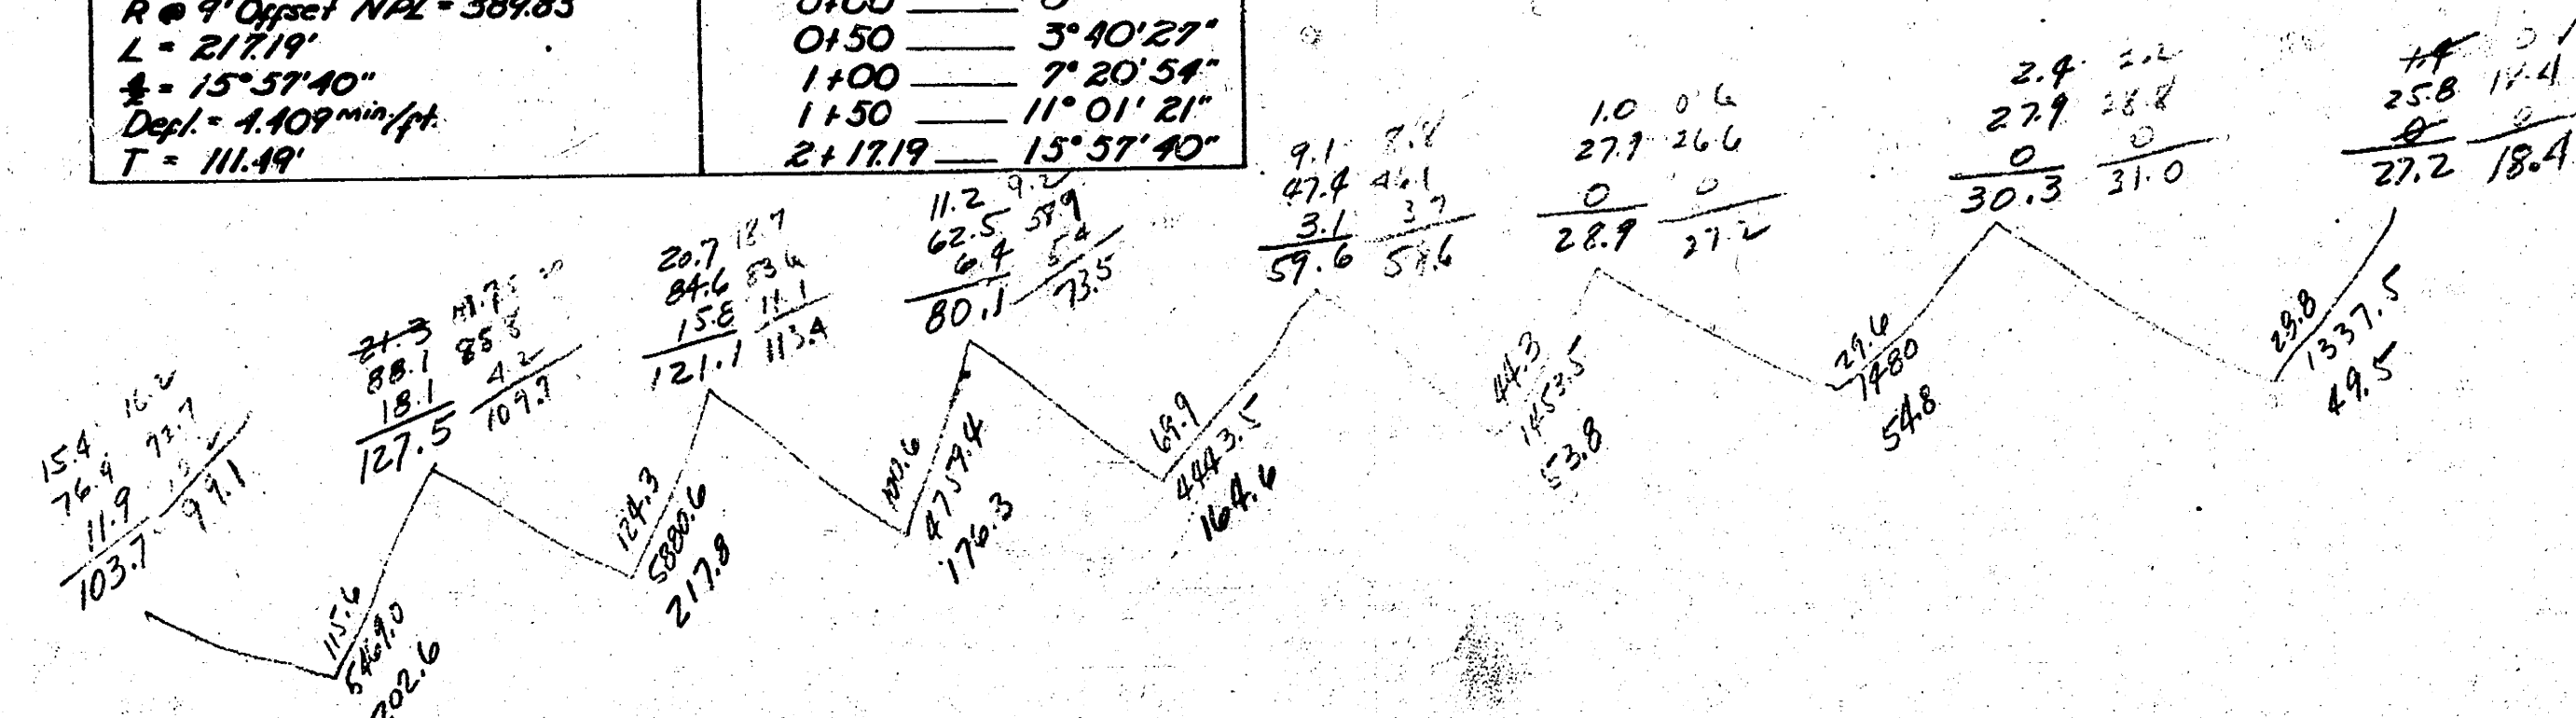


EL PRAIRIE PARK ADDN

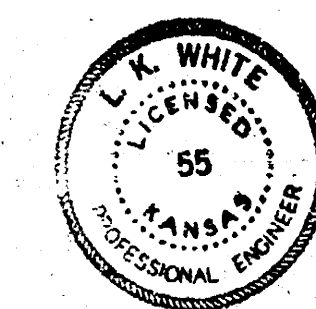

MORRIS STREET
 EL LEXINGTON~EL PRAIRIE PARK A
 26-2-30 AC
 City of Wichita Kansas
 LK White City Engineer
 April, 1951 Proj. No. C11-43

4 8 1 52

BM 16266 "M" in Mueller F. Hyd. NW Cor. Lightner & Morris

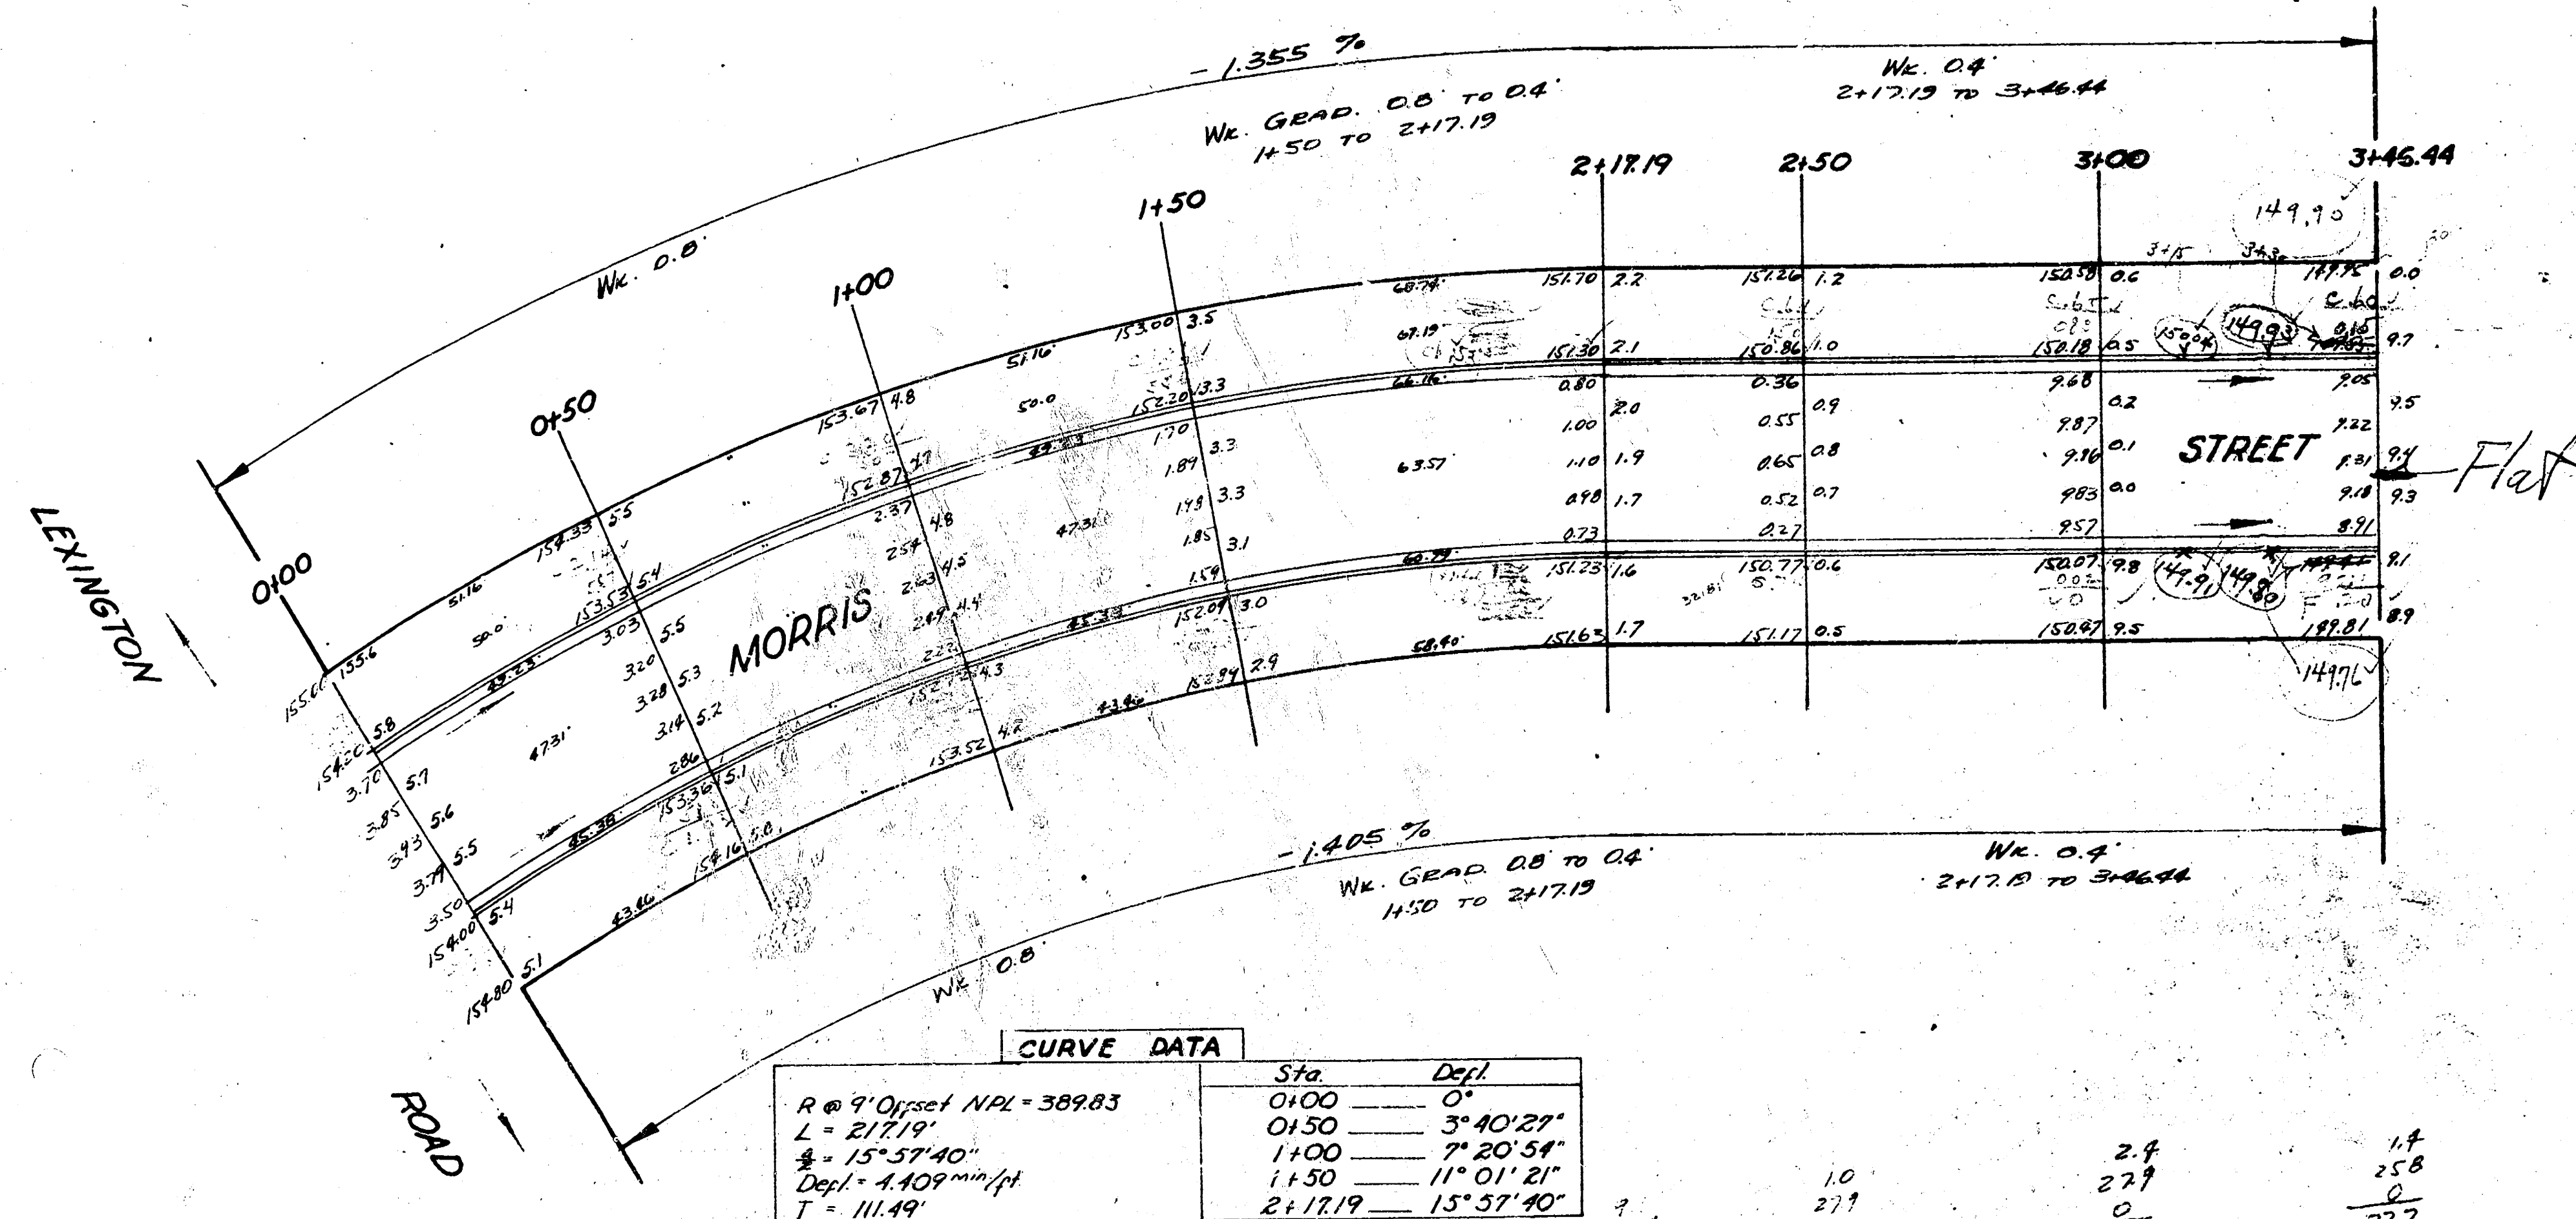

CURVE DATA	
Sta.	Dist.
0+00	0'

Dist. = 4.409 min/ft
T = 111.49'

Prop. City
200.0
217.8
178.8
141.6
53.8
54.2
82.1
319.8
219.8
1011.3

EL PRAIRIE PARK ADDN

MORRIS STREET
EL LEXINGTON-EL PRAIRIE PARK
26-2-30 AC
City of Wichita Kansas
L.K. White City Engineer
April, 1951 Proj. No. C11-43

