



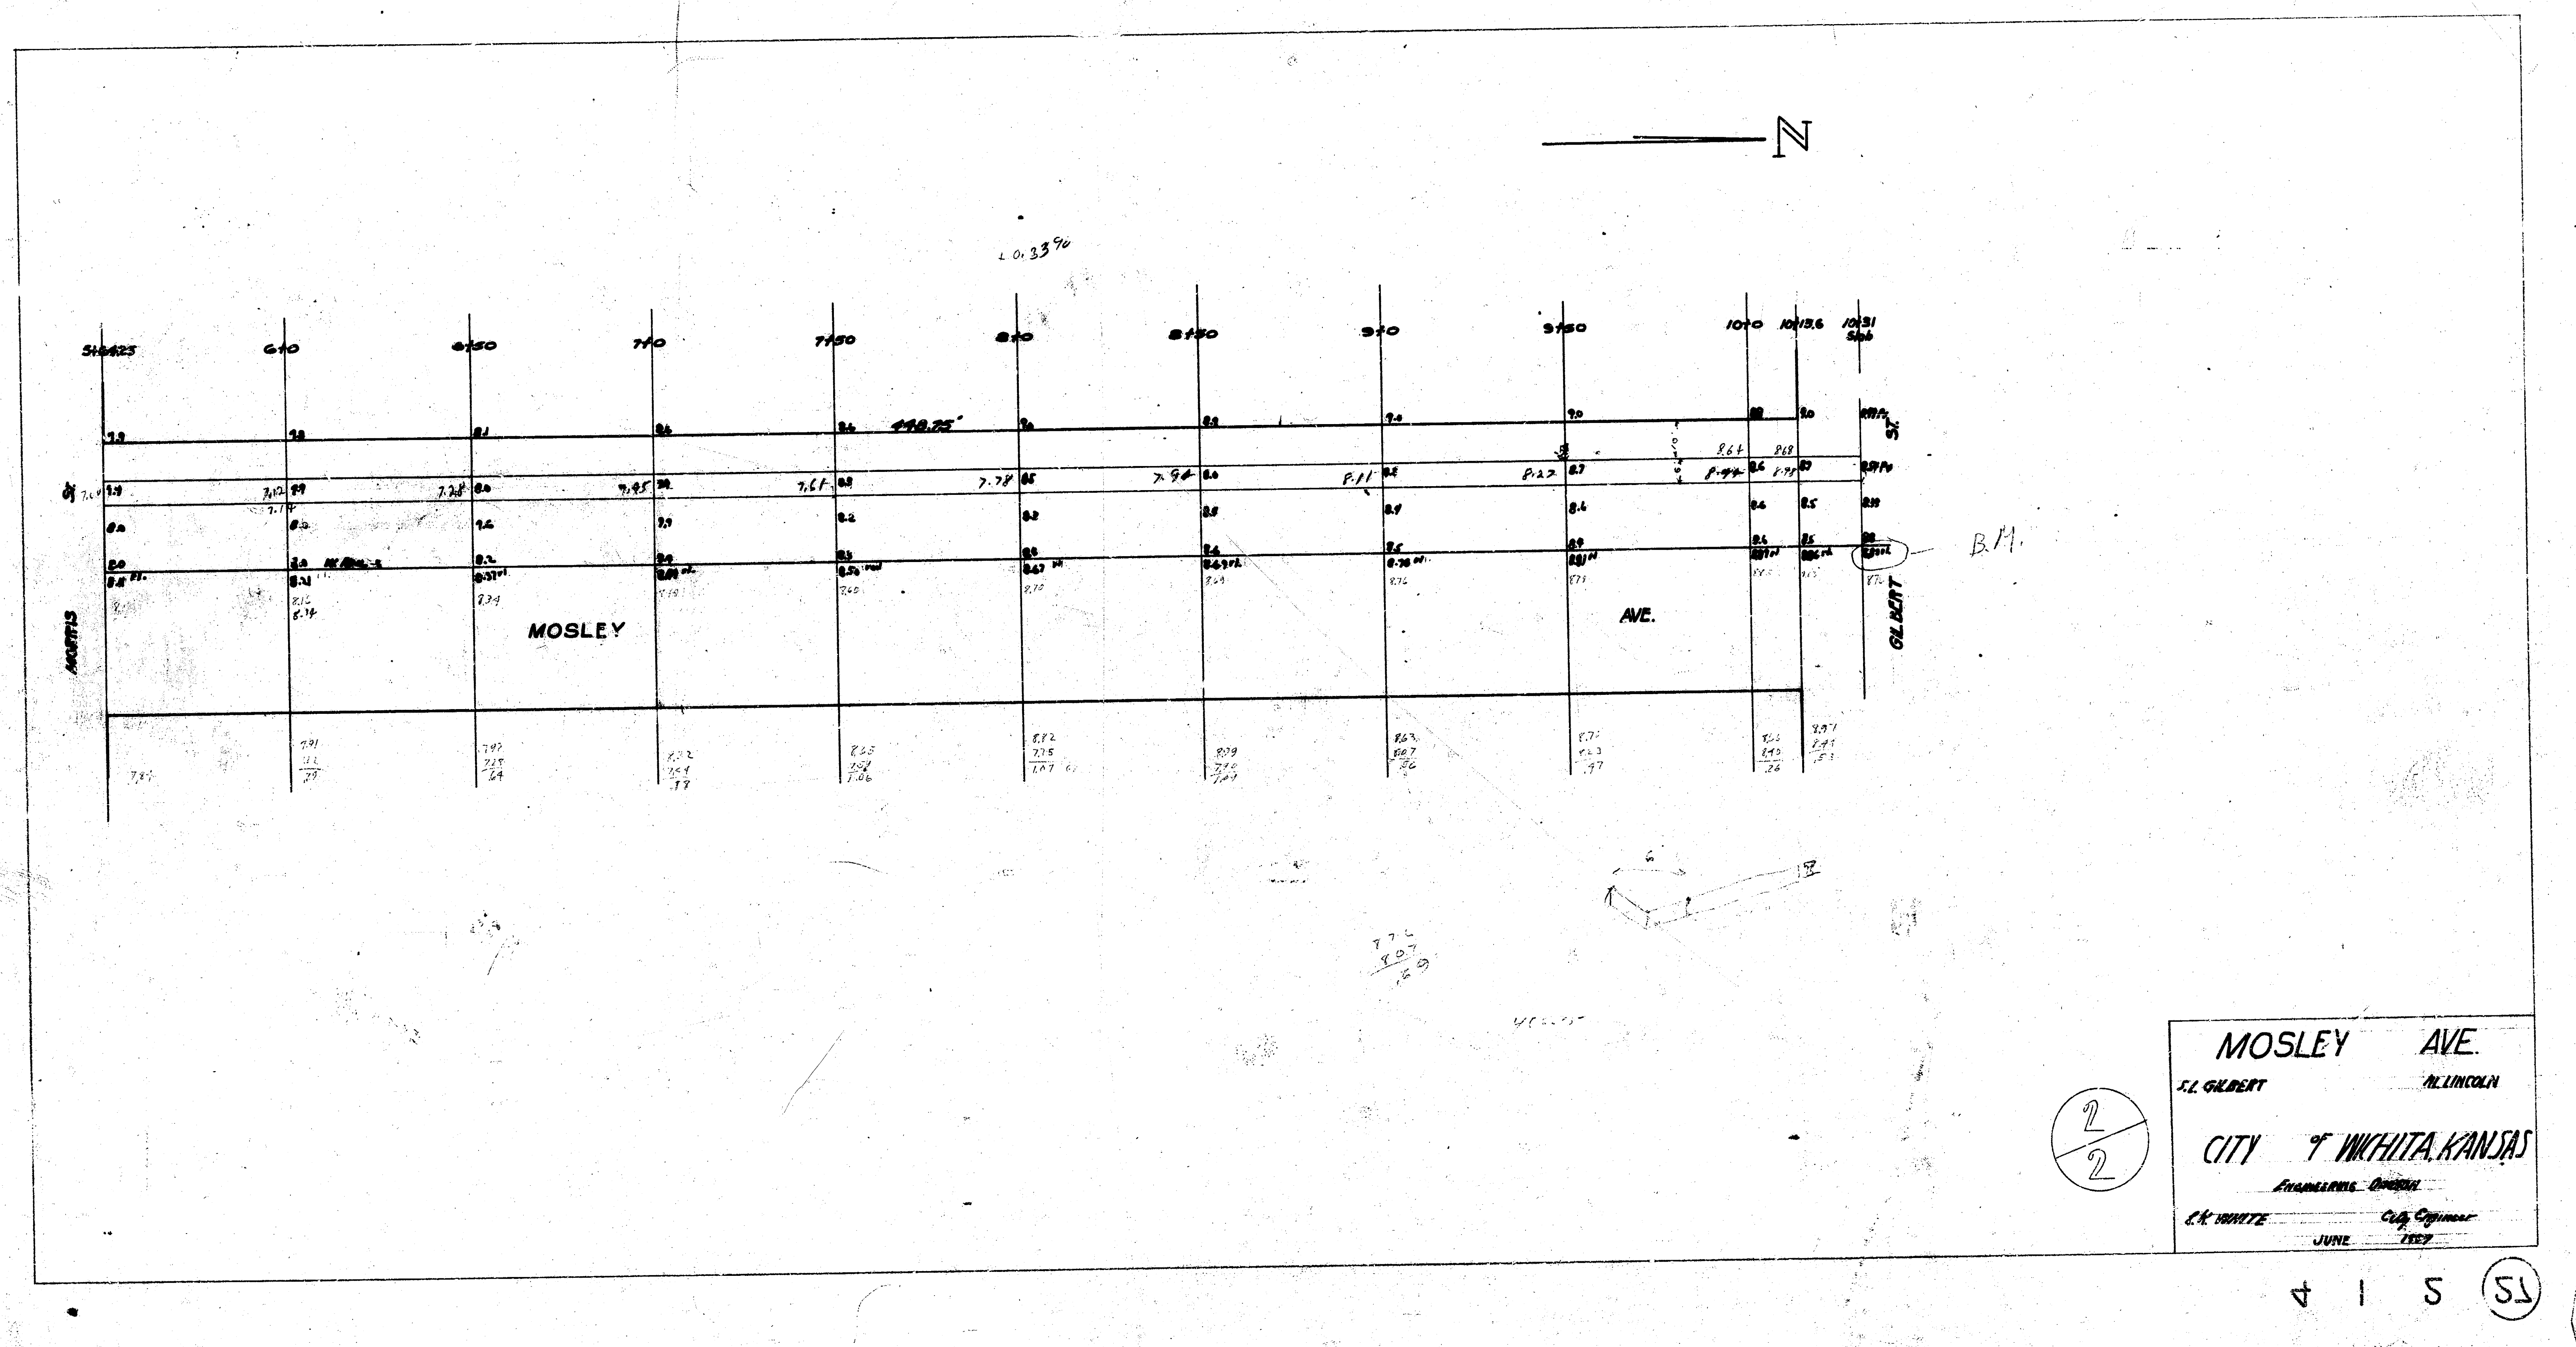

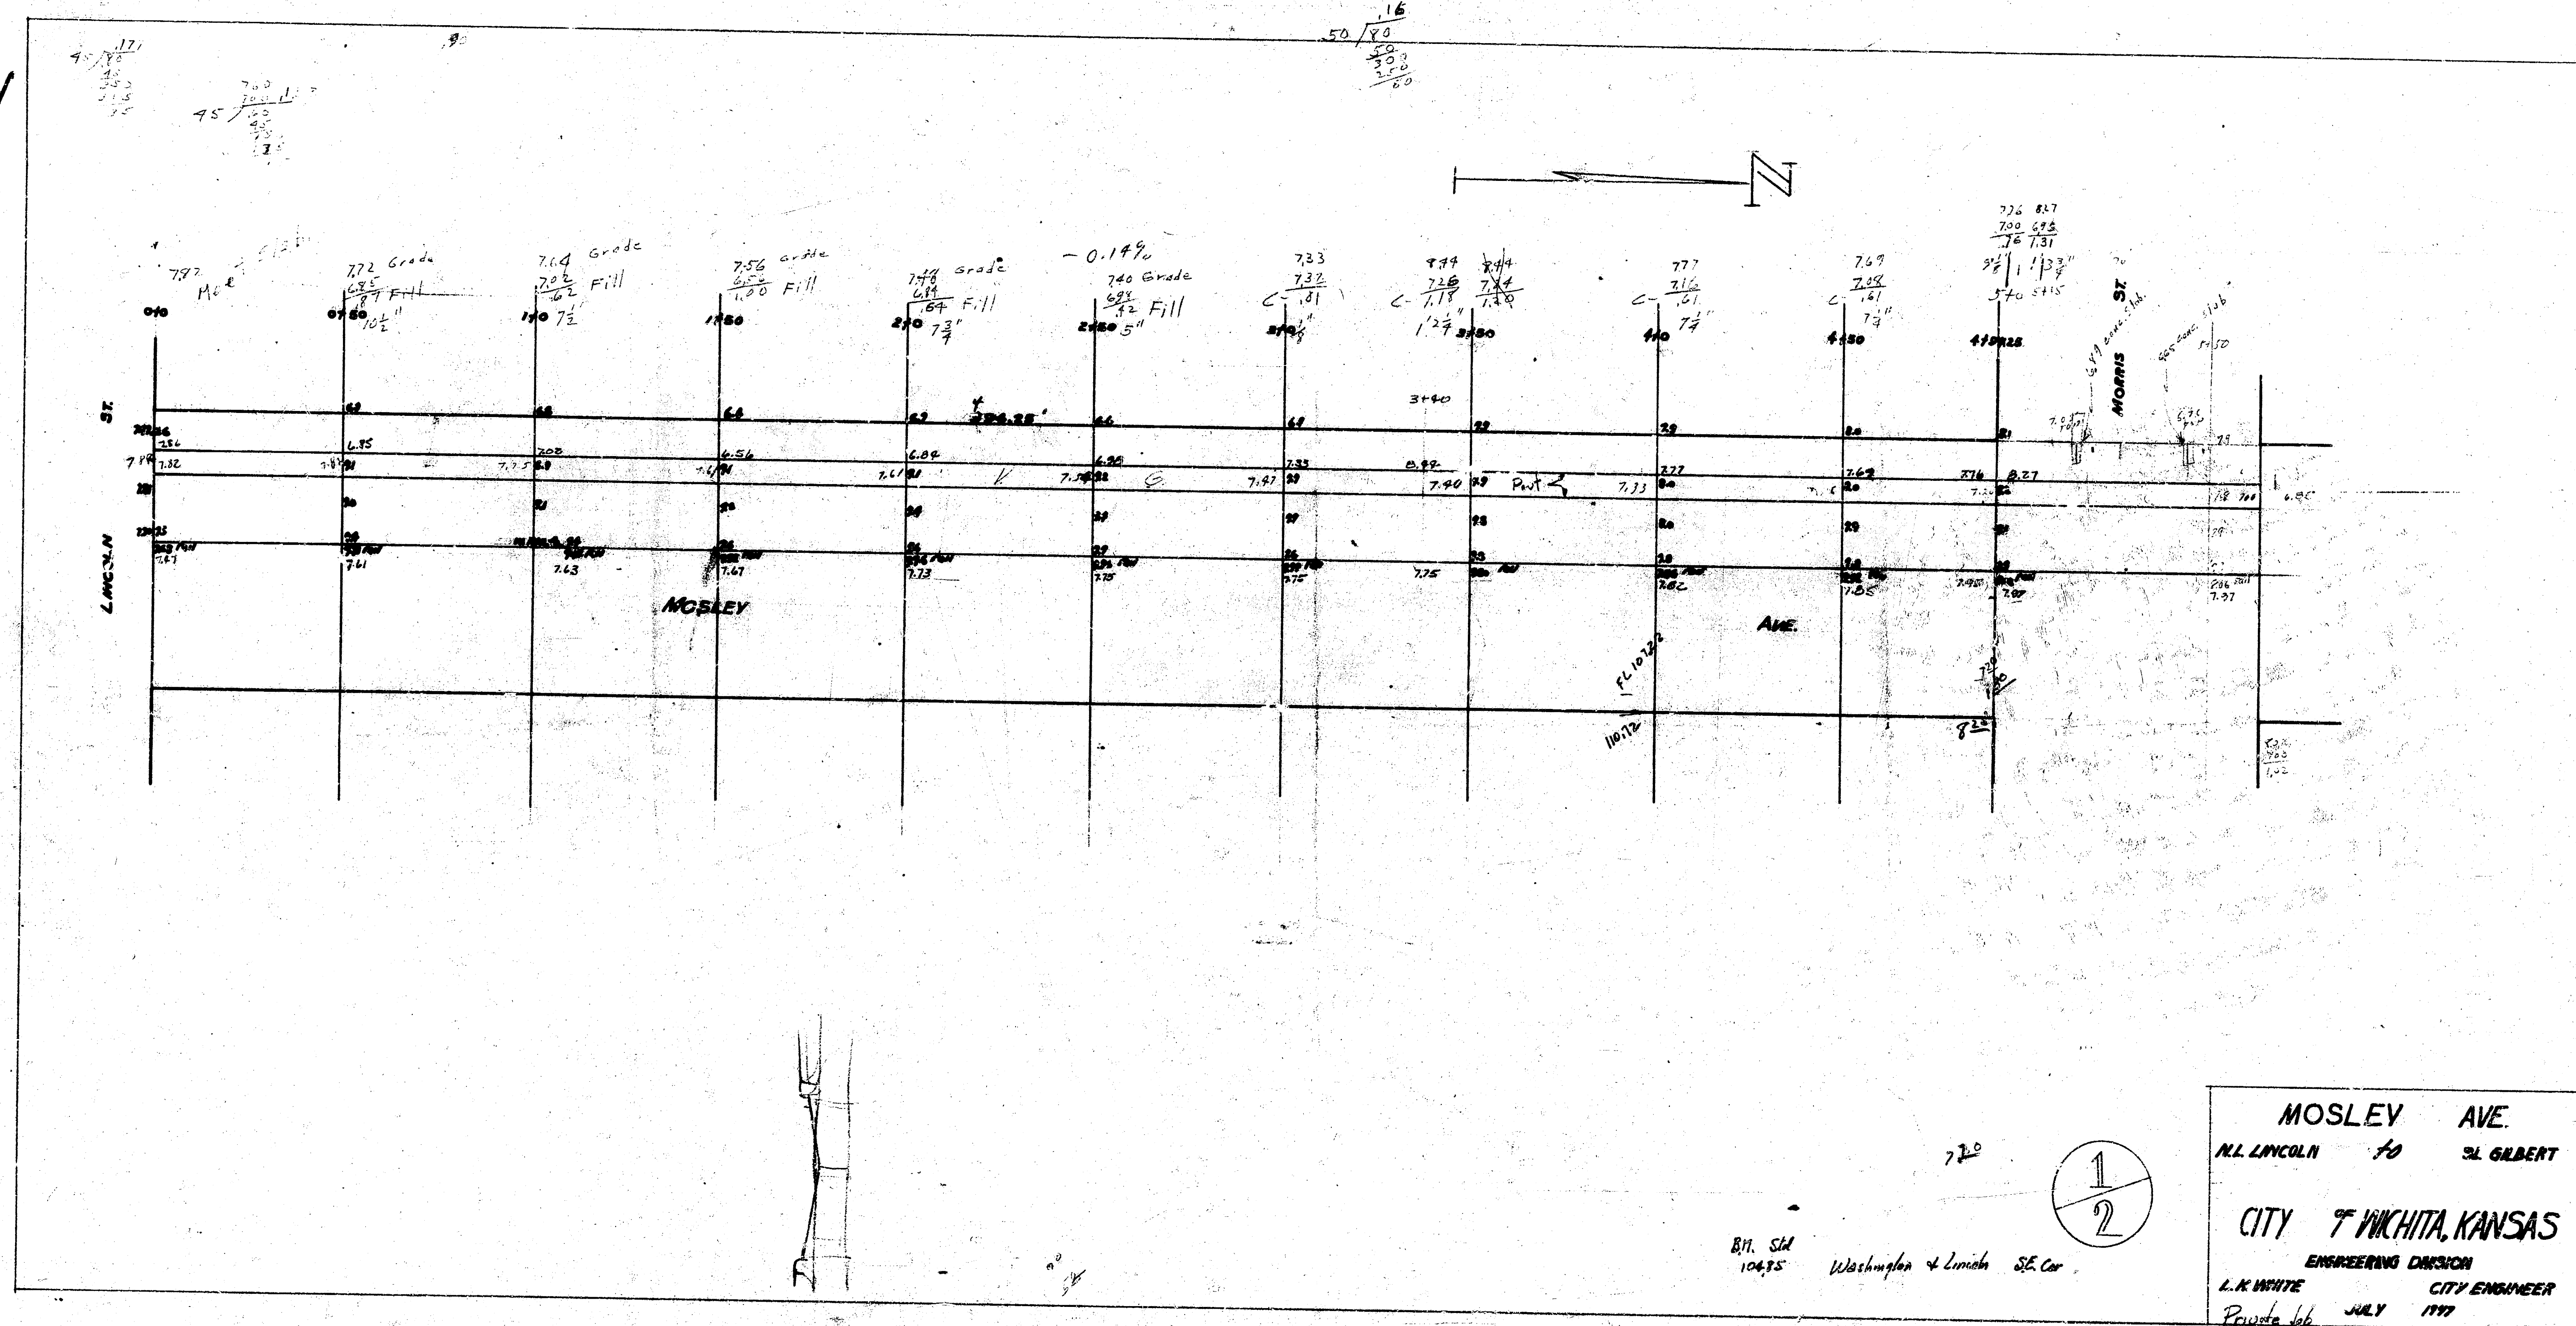

MOSLEY AVE.
 N. LINCOLN ST. to S. GILBERT ST.
 CITY OF WICHITA, KANSAS
 ENGINEERING DIVISION
 L. K. WHITE CITY ENGINEER
