
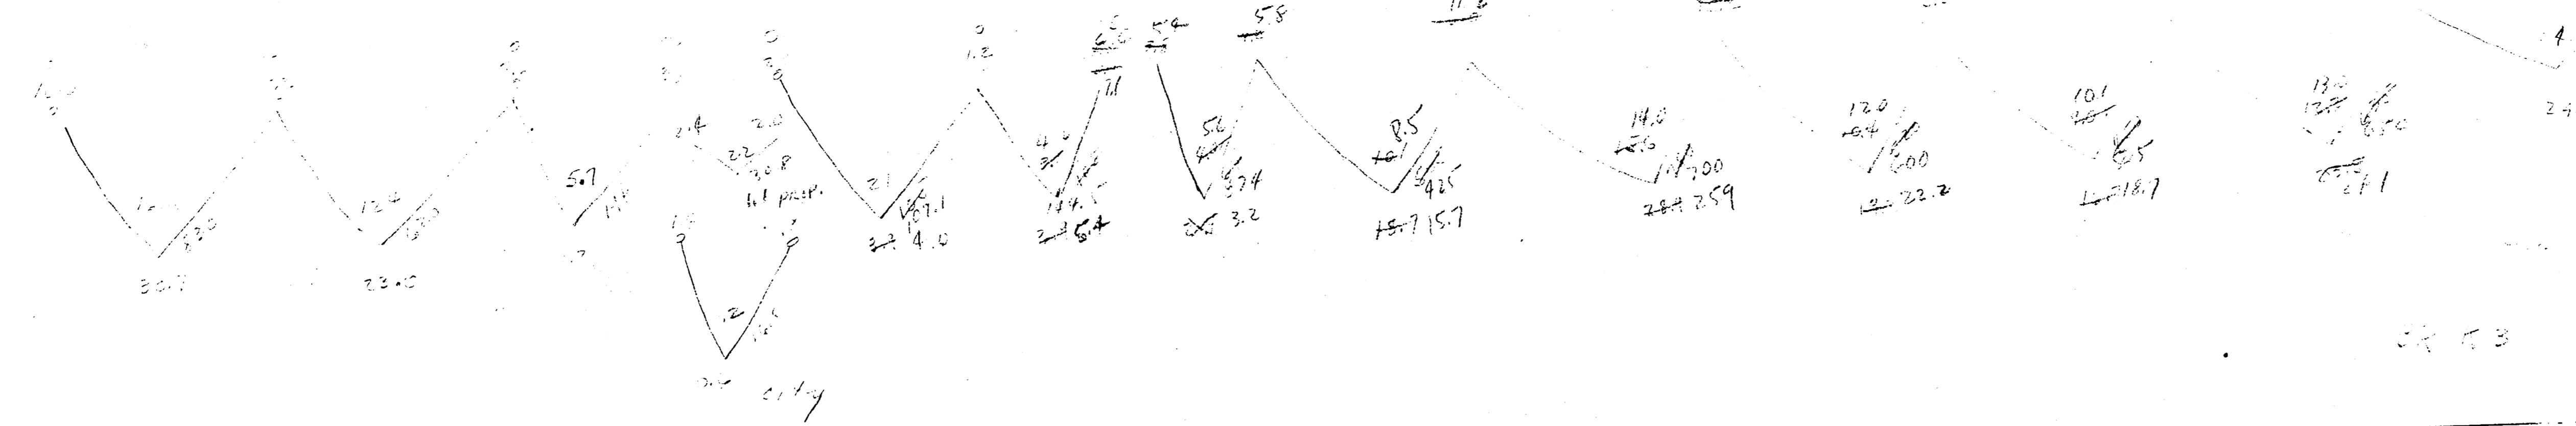


B.M. 11917 "R" in Ritche on S.W. S.L. Mossman W.S. Grove.

House S.W. cor. Green & Bth.

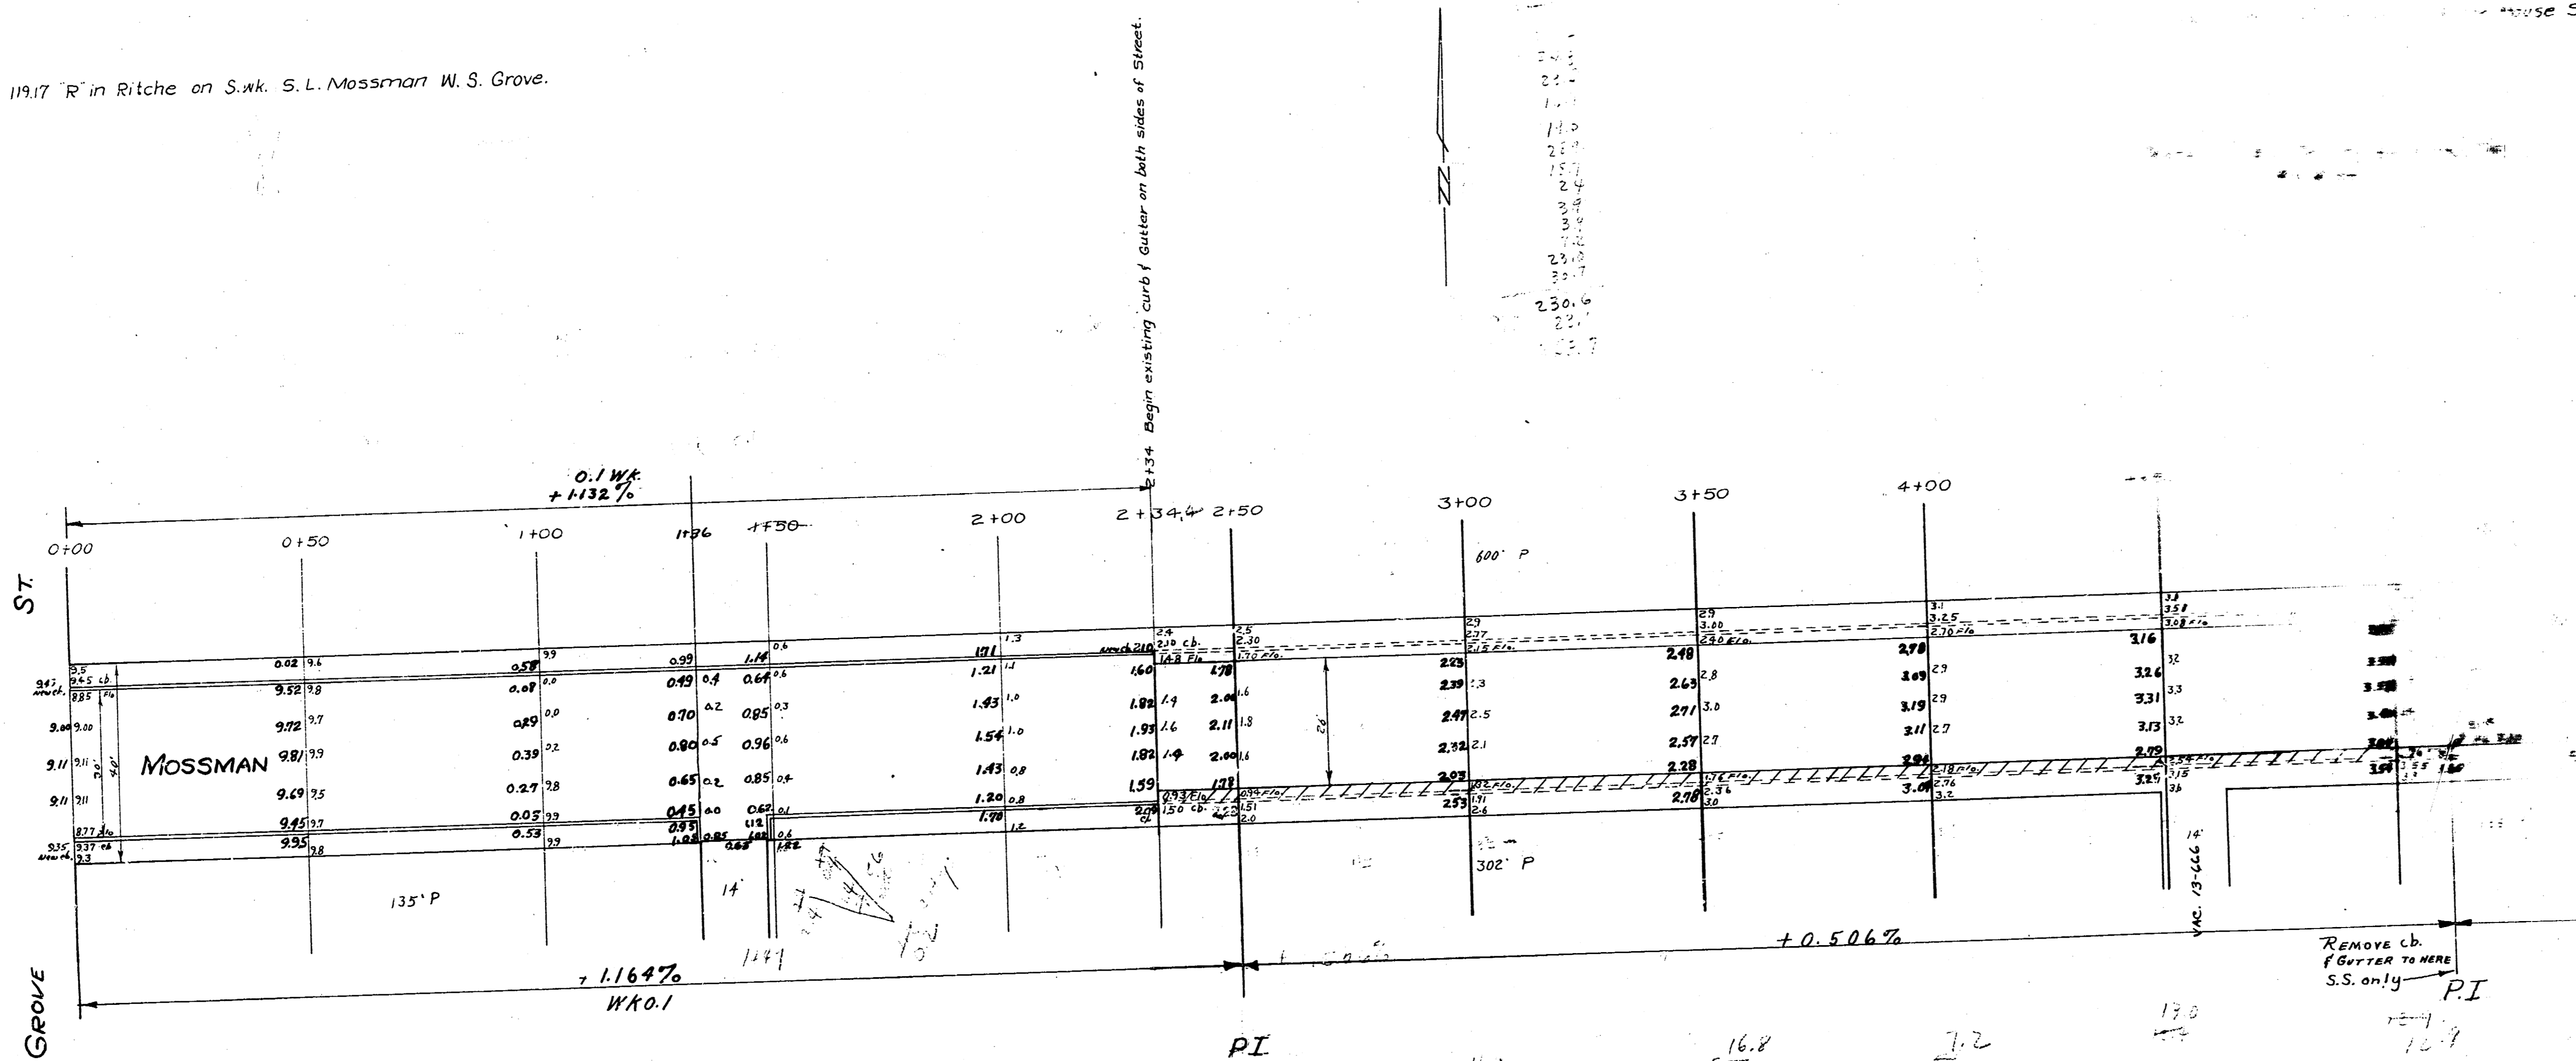

MOSSMAN AVE
 EL. GROVE to EL. GREEN
 30' CONC & CB.
 CITY OF WICHITA, KANSAS
 L.K. WHITE CITY ENGINEER
 JUNE 1949 PROJ. NO. C19-111