


Message Ave
 to Morrison to E. Pitt

L-2-30 A.C.

Change 70 ft Gr by P.L.B.
 20 Ave.

On line 11531 15" Ball bed of wall north N.W. corner Pitt & 70

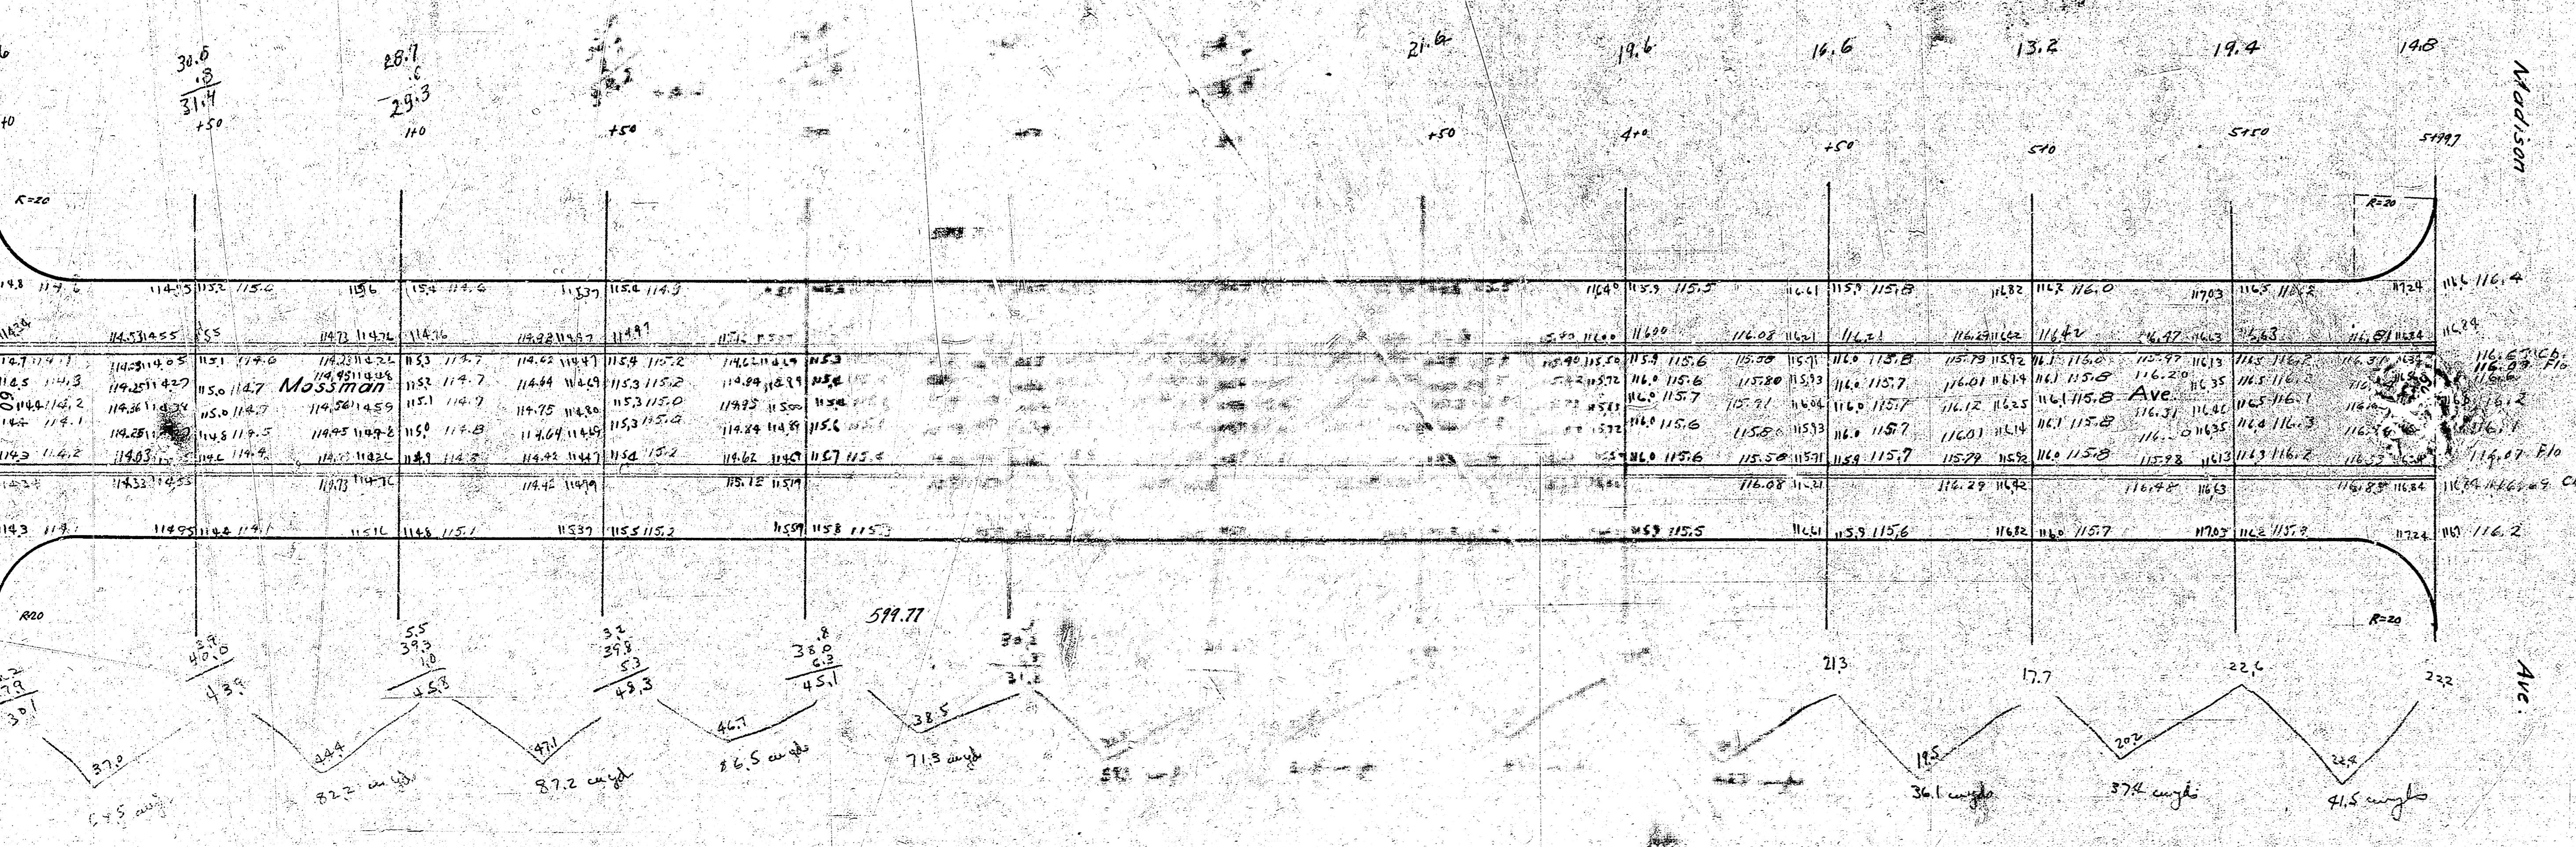

Property - 714.8
 710.7% = 71.5
 706.3 acre/da